


01 SITE PLAN 1:500

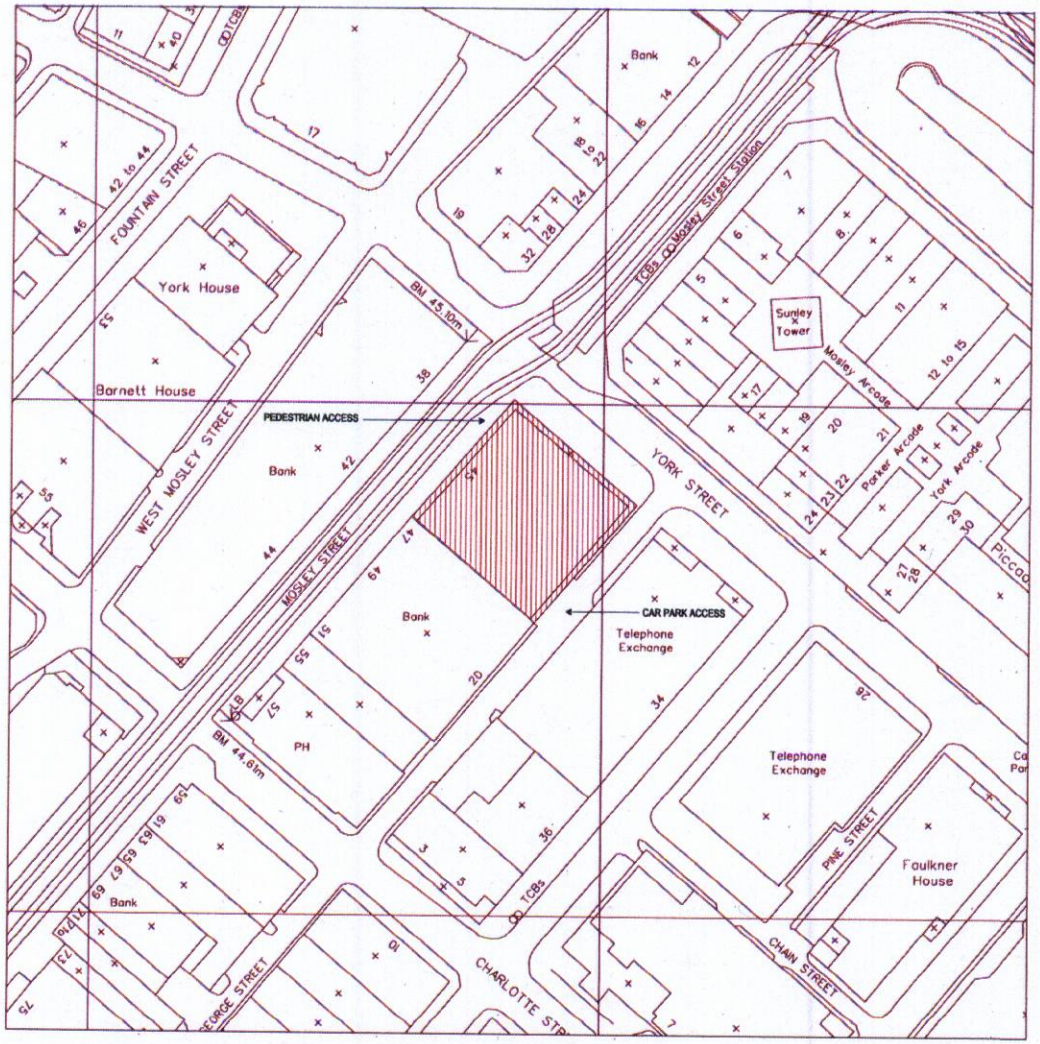

SITE: 45 MOSLEY STREET

General Notes
Do not scale from drawing. Use marked dimensions.
To be read in conjunction with all other Consultant's drawings.
The Architect to be immediately notified of any discrepancies.
Copyright on this drawing retained by the Architect.

Scale / North Point
1:500 @ A1 0 5 10 15 20M

No	Date	Dsn	Chk	App	Revision or reason for issue
A	19/06/2007	DH	JH	SQ	Planning
B	17/05/2009	DH	TG	SQ	As Built Record

DENTON CORKER MARSHALL

Architect
Denton Corker Marshall Limited
Exmouth House 3-11 Pine Street
London EC1R 0JH
Telephone 020 7833 2626 Facsimile 020 7833 0329
Email mail@dentoncorkermarshall.co.uk

Project Title
45 MOSLEY STREET MANCHESTER

Client
Brunswick Estates Limited
City Tower
Piccadilly Plaza
Manchester M1 4BD
Telephone 016 1237 3000 / Facsimile 0161 237 1779

Drawing Title
EXISTING SITE PLAN

Project Number 6339
Drawing Status PLANNING
Drawing Number A001
CAD Reference
Existing Site
B
26/02/2007