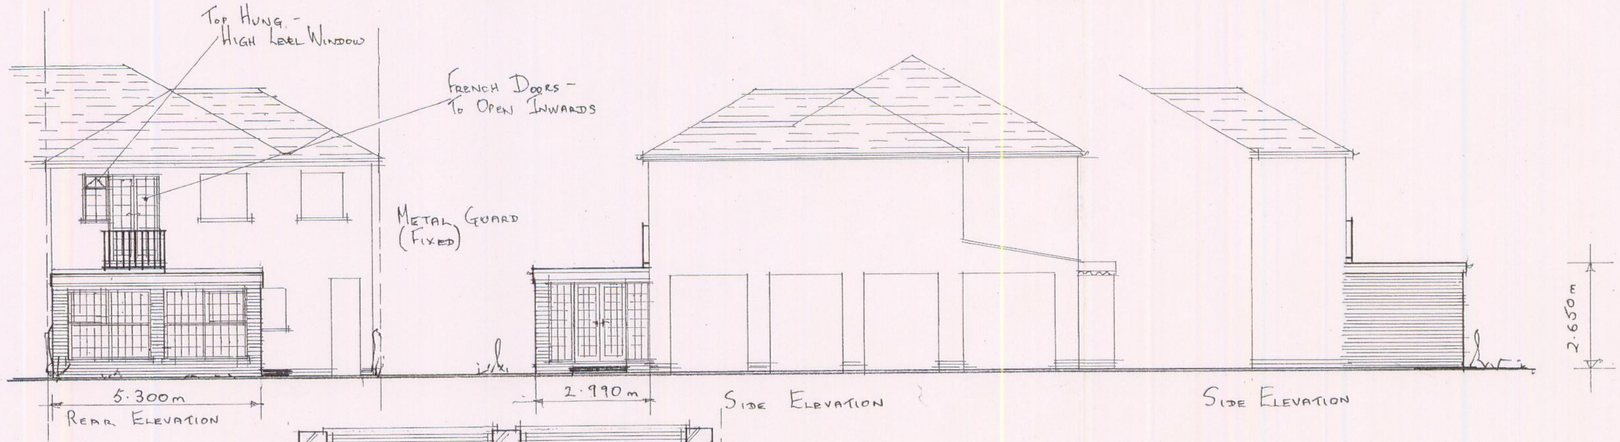

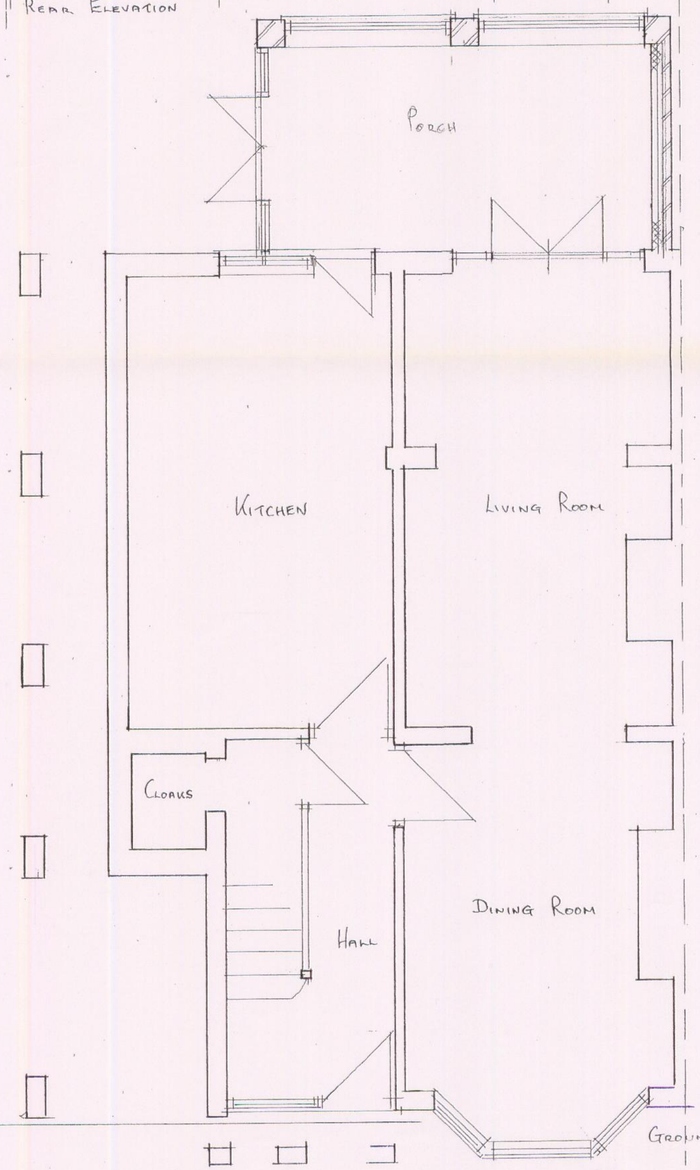

Ground Floor Plan

Note: These Plans Are For Retrospective Planning Permission Only



1:1250 Location Plan

REC'D 28 JUL 2009
PORCH ADDITION

NOTES:
All dimensions must be checked on site and not scaled from this drawing.

Revised Drg. 090589

© copyright

BRIAN MOSS ASSOCIATES
Architectural and Planning Services

BRIAN A. MOSS MRICS
Chartered Surveyor

17 The Ridgeway, Disley,
Cheshire, SK12 2JG
Telephone: 01663 - 762614
Mobile: 07815 - 900616

RICS

Client
Mr + Mrs S A Choudhry

Job Title
Proposed Rear Porch At:-
36 Chatburn Road
Chorlton
M21 0xw

Drawing Title
Proposed Plans + Elevations (As Built)

Scale
1:100 + 1:50

Date
July 09

Drawn by
BAH.

Drg. No.
09/0442/02

Rev.
A