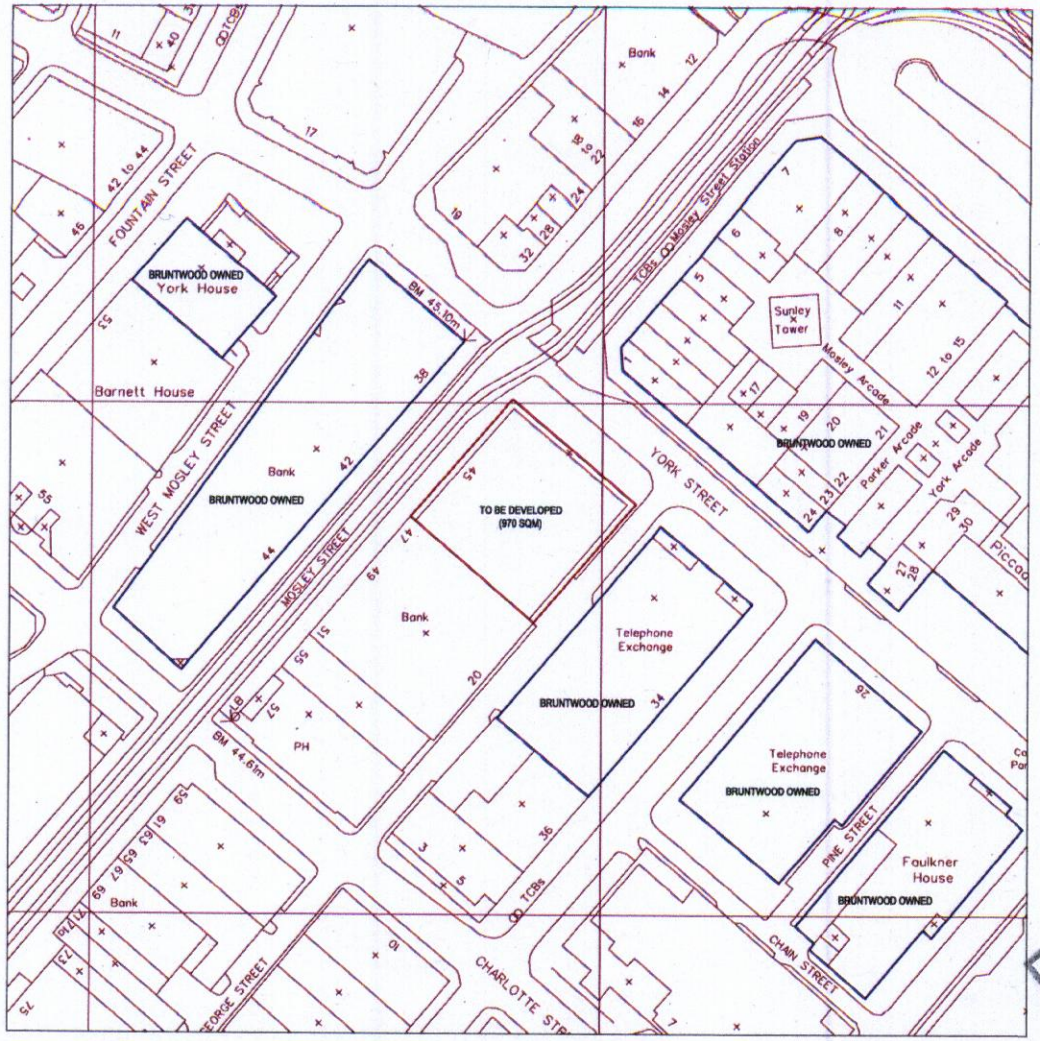

01 RED EDGE PLAN

1:500

PLANNING
ACK'D
REPLIED
RECD 20 JUL 2009
M
M
M
FOILACTION

Do not scale from drawing. Use marked dimensions.
To be read in conjunction with all other Consultant's drawings.
The Architect to be immediately notified of any discrepancies.
Copyright on this drawing retained by the Architect.

No.	Date	Dwn	Chk	App	Revision or reason for issue
A	16/03/2007	EB	JR	SQ	Planning
B	17/03/2009	BH	TG	SQ	As Built Record

DENTON CORKER MARSHALL

Architect
Denton Corker Marshall Limited
Exmouth House 3-11 Pine Street
London EC1R 0JH
Telephone 020 7833 3020 Facsimile 020 7833 9320
Email mail@dentoncorkermarshall.co.uk

Project Title
45 MOSLEY STREET
MANCHESTER

Client
Brunswick Estates Limited
City Tower
Piccadilly Plaza
Manchester M1 4BD
Telephone 016 1237 5883 / Facsimile 0161 237 1779

Scale / North Point
1:500 @ A1 0 5 10 15 20M

Drawing Title
RED EDGE SITE PLAN

Project Number
6339

Drawing Number
A002

B

Drawing Status
PLANNING

CAD Reference
Red Edge Plan