MANCHESTER CITY COUNCIL
Planning
Telephone: +44 (0)161 234 4516
planning@manchester.gov.uk
PO Box 532 Town Hall
Manchester M60 2LA

098066

# Application for a non-material amendment following a grant of planning permission.

Town and Country Planning Act 1990

PLANNING AND BUILDING CONTROL
08 DEC 2011

## Publication of applications on planning authority websites

**Please note that the information provided on this application form and in supporting documents may be published on the Authority's website. If you require any further clarification, please contact the Authority's planning department.**

Please complete using block capitals and black ink.
It is important that you read the accompanying guidance notes as incorrect completion will delay the processing of your application.

## 1. Applicant Name and Address

| | | | | | |
|---|---|---|---|---|---|
| Title: | MR | First name: | NIGEL | | |
| Last name: | KENDRICK | | | | |
| Company (optional): | C-I-C CENTRAL SUPPORT SERVICES | | | | |
| Unit: | N/A | House number: | N/A | House suffix: | N/A |
| House name: | OLD MARKET COURT | | | | |
| Address 1: | MINERS WAY | | | | |
| Address 2: | | | | | |
| Address 3: | | | | | |
| Town: | WIDNES | | | | |
| County: | CHESHIRE | | | | |
| Country: | ENGLAND | | | | |
| Postcode: | WA8 7SP | | | | |

## 2. Agent Name and Address

| | | | | | |
|---|---|---|---|---|---|
| Title: | MR | First name: | NIGEL | | |
| Last name: | CROMPTON | | | | |
| Company (optional): | POZZONI LLP | | | | |
| Unit: | | House number: | 2 | House suffix: | |
| House name: | WOODVILLE HOUSE | | | | |
| Address 1: | WOODVILLE ROAD | | | | |
| Address 2: | ALTRINCHAM | | | | |
| Address 3: | | | | | |
| Town: | AS ADDRESS 2 | | | | |
| County: | CHESHIRE | | | | |
| Country: | ENGLAND | | | | |
| Postcode: | WA14 2FH | | | | |

## 3. Site Address Details

Please provide the full postal address of the application site.

| | | | | | |
|---|---|---|---|---|---|
| Unit: | N/A | House number: | N/A | House suffix: | N/A |
| House name: | THORNLEA CARE HOME | | | | |
| Address 1: | CHARLESTOWN ROAD (198) | | | | |
| Address 2: | BLACKLEY | | | | |
| Address 3: | | | | | |
| Town: | MANCHESTER | | | | |
| County: | | | | | |
| Postcode (optional): | M9 7ED | | | | |

Description of location or a grid reference.
(must be completed if postcode is not known):

Easting: Northing:

Description:

## 4. Pre-application Advice

Has assistance or prior advice been sought from the local authority about this application? ☐ Yes ☐ No

If Yes, please complete the following information about the advice you were given. (This will help the authority to deal with this application more efficiently).

Please tick if the full contact details are not known, and then complete as much as possible: ☐

Officer name:

Reference:

Date of advice (DD/MM/YYYY):

Details of pre-application advice received:

## 5. Eligibility

Do you, or the person on whose behalf you are making this application, have an interest in the part of the land to which this amendment relates? ☑ Yes ☐ No

**If you have answered No to this question, you cannot apply to make a non-material amendment.**

If you are not the sole owner, has notification under article 9 of the DMPO been given? ☐ Yes ☐ No ☑ Not Applicable

**If you have answered No to this question, you cannot apply to make a non-material amendment.**

If you have answered Yes to this question, please give details of persons notified:

| Person Notified | Address | Date of Notification |
|---|---|---|
| | | |
| | | |
| | | |
| | | |
| | | |

## 6. Authority Employee / Member

With respect to the Authority, I am:
(a) a member of staff
(b) an elected member
(c) related to a member of staff
(d) related to an elected member

Do any of these statements apply to you?

☐ Yes ☑ No

If yes please provide details of the name, relationship and role

## 7. Description Of Your Proposal

Please provide a description of the approved development as shown on the decision letter, including application reference number and date of decision in the sections below. Please also provide the original application type:

- FULL PLANNING APPLICATION. DATE OF APPLICATION 16TH MARCH 2010 APPLICATION REFERENCE Nº. 092673/FO/2010/N1 DATE OF DECISION (APPROVAL) 03/06/2010.
- ERECTION OF A THREE STOREY 48 BED CARE HOME PLUS 12 RESPITE BEDROOMS WITH ASSOCIATED PARKING, LANDSCAPING AND BOUNDARY TREATMENT FOLLOWING DEMOLITION OF EXISTING CARE HOME.

Reference number: 092673/FO/2010/N1

Date of decision (DD/MM/YYYY): 03/06/2010.

What was the original application type?:
(e.g. 'Full', 'Householder and Listed Building', 'Outline') FULL.

For the purpose of calculating fees, which of the following best describes the original application type?


**Householder development**: development to an existing dwelling-house or development within its curtilage ☐

**Other:** anything not covered by the above category ☑

## 8. Non-Material Amendment(s) Sought

Please describe the non-material amendment(s) you are seeking to make:

- EAST ELEVATION 1200 X 1200 LOW RED GRILLE TO MATCH BRICKWORK COLOUR
- SOUTH ELEVATION - ORIGINAL PORTION OF RAISED ROOF IN CENTRE HAS BEEN ADJUSTED DUE TO STRUCTURAL CONSTRAINTS. RIDGE HEIGHT REMAINS AS ORIGINAL APPLICATION, BUT INTERFACE WITH MAIN ROOF NOW HAS A BROKEN FASCIA LINE

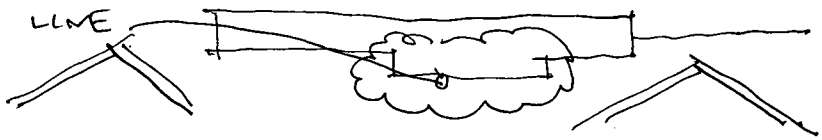

Are you intending to substitute amended plans or drawings? ☑ Yes ☐ No

If Yes, please complete the following:

Old plan/drawing number(s):

G.A. ELEVATIONS P2849-300B, 301 B, 302 B.

New plan/drawing number(s):

GA ELEVATIONS P2849-300H, 301 H, 302 G ROOF PLAN P2849-217D.

Please state why you wish to make this amendment:

- MECHANICAL VENTILATION REQUIREMENTS.
- STRUCTURAL REQUIREMENTS TO SUPPORT RAISED ROOF AREA.

## 9. Application Requirements - Checklist

Please read the following checklist to make sure you have sent all the information in support of your proposal. Failure to submit all information required will result in your application not being accepted. It will not be accepted until all information required by the Local Planning Authority has been submitted.

The original and 3 copies of a completed and dated application form: ☑

The original and 3 copies of other plans and drawings or information necessary to describe the subject of the application: ☑

The correct fee: ☑

## 10. Declaration

I/we hereby apply for planning permission/consent as described in this form and the accompanying plans/drawings and additional information.

Signed - Applicant: N/A

Or signed - Agent: [redacted]

Date (DD/MM/YYYY): 06-12-11.

## 11. Applicant Contact Details

Telephone numbers

Country code: [redacted] National number: [redacted] Extension number: [redacted]

Country code: [redacted]

Country code: [redacted]

Email address (optional): [redacted]

## 12. Agent Contact Details

Telephone numbers

Country code: [redacted] National number: [redacted] Extension number: [redacted]

Country code: [redacted] Mobile number (optional): N/A

Country code: [redacted] Fax number (optional): N/A.

Email address (optional): [redacted]

## 13. Site Visit

Can the site be seen from a public road, public footpath, bridleway or other public land? ☑ Yes ☐ No

If the planning authority needs to make an appointment to carry out a site visit, whom should they contact? *(Please select only one)* ☑ Agent ☐ Applicant ☐ Other (if different from the agent/applicant's details)

If Other has been selected, please provide:

Contact name: [redacted] Telephone number: [redacted]

Email address: [redacted]