



BASEMENT PLAN

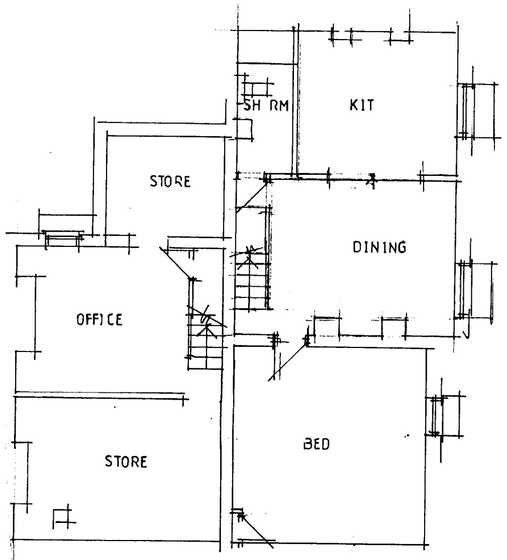


GROUND FLOOR PLAN

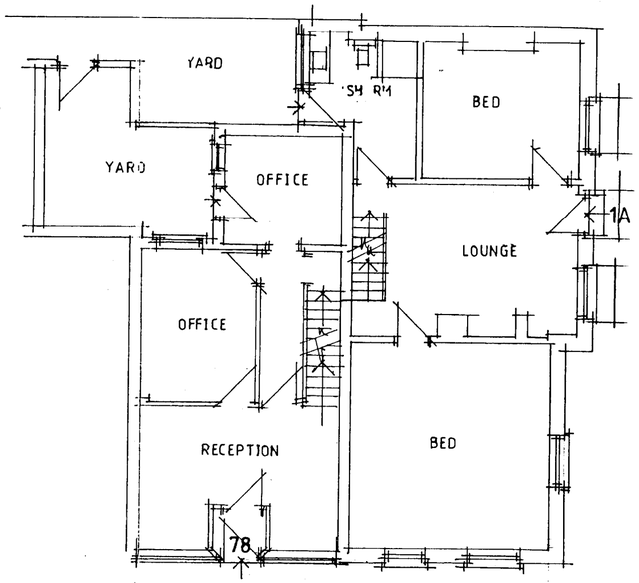



PLANS PRIOR TO CONSTRUCTION

SCALE 1:100

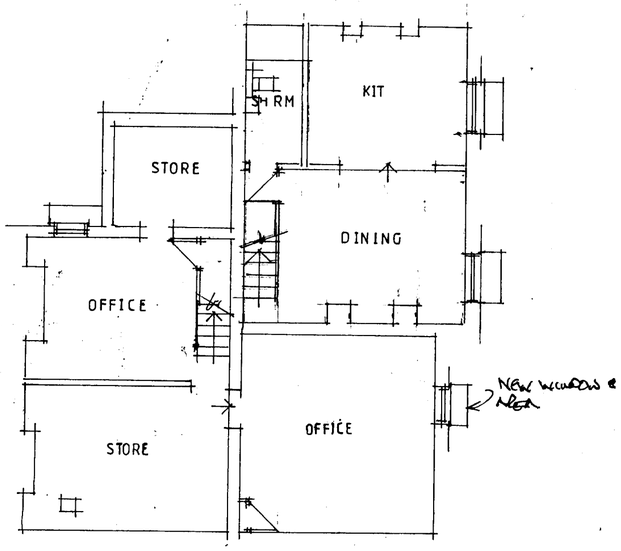

BASEMENT PLAN

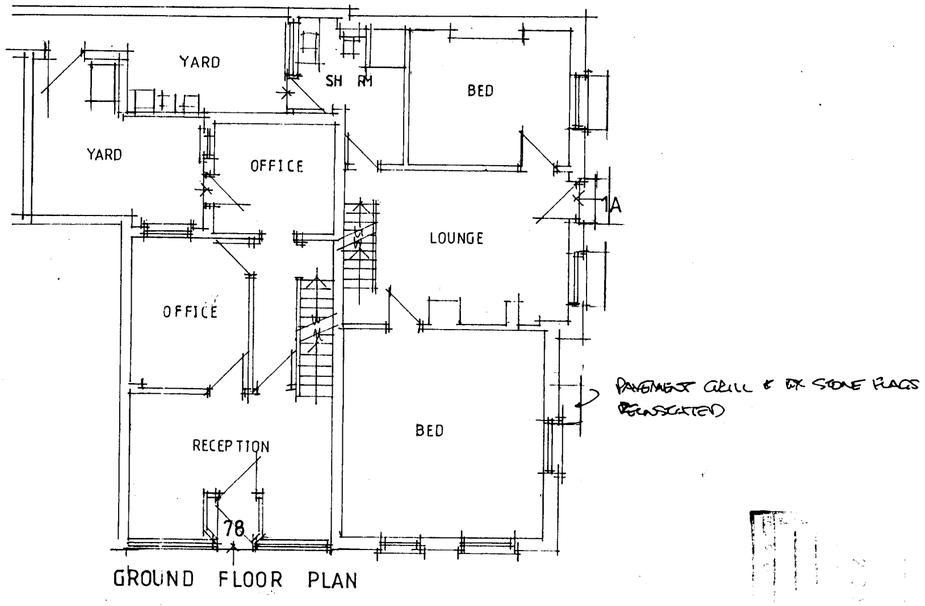

GROUND FLOOR PLAN

PLANS AS CONSTRUCTED

SCALE 1:100

NOTES

CLIENT
SADDIQUE & CO
78 DICKENSON ROAD
RUSHOLME M14 5HF

JOB TITLE
CHANGE OF USE OF PART OF
1A MOON GROVE CELLAR (C3) TO
A2 OFFICE USAGE

DRG. TITLE
PLANS PRIOR TO CHANGE
PLANS AS CONSTRUCTED

HOLBOROW + ORMESHER Limited
architectural & interior design
Station House
Adams Hill
Knutsford
Cheshire WA16 6DN
telephone : 01565 652275
fax : 01565 750501

ISSUE	ORIGINAL	1	2	3	4	5	6	7
REVISION		A						
DATE		MAR 08						
DRAWN		MD						
CHECKED								
APPROVED								

SCALE 1:100

DRAWING NUMBER 724/07/02 A

M 512650 R