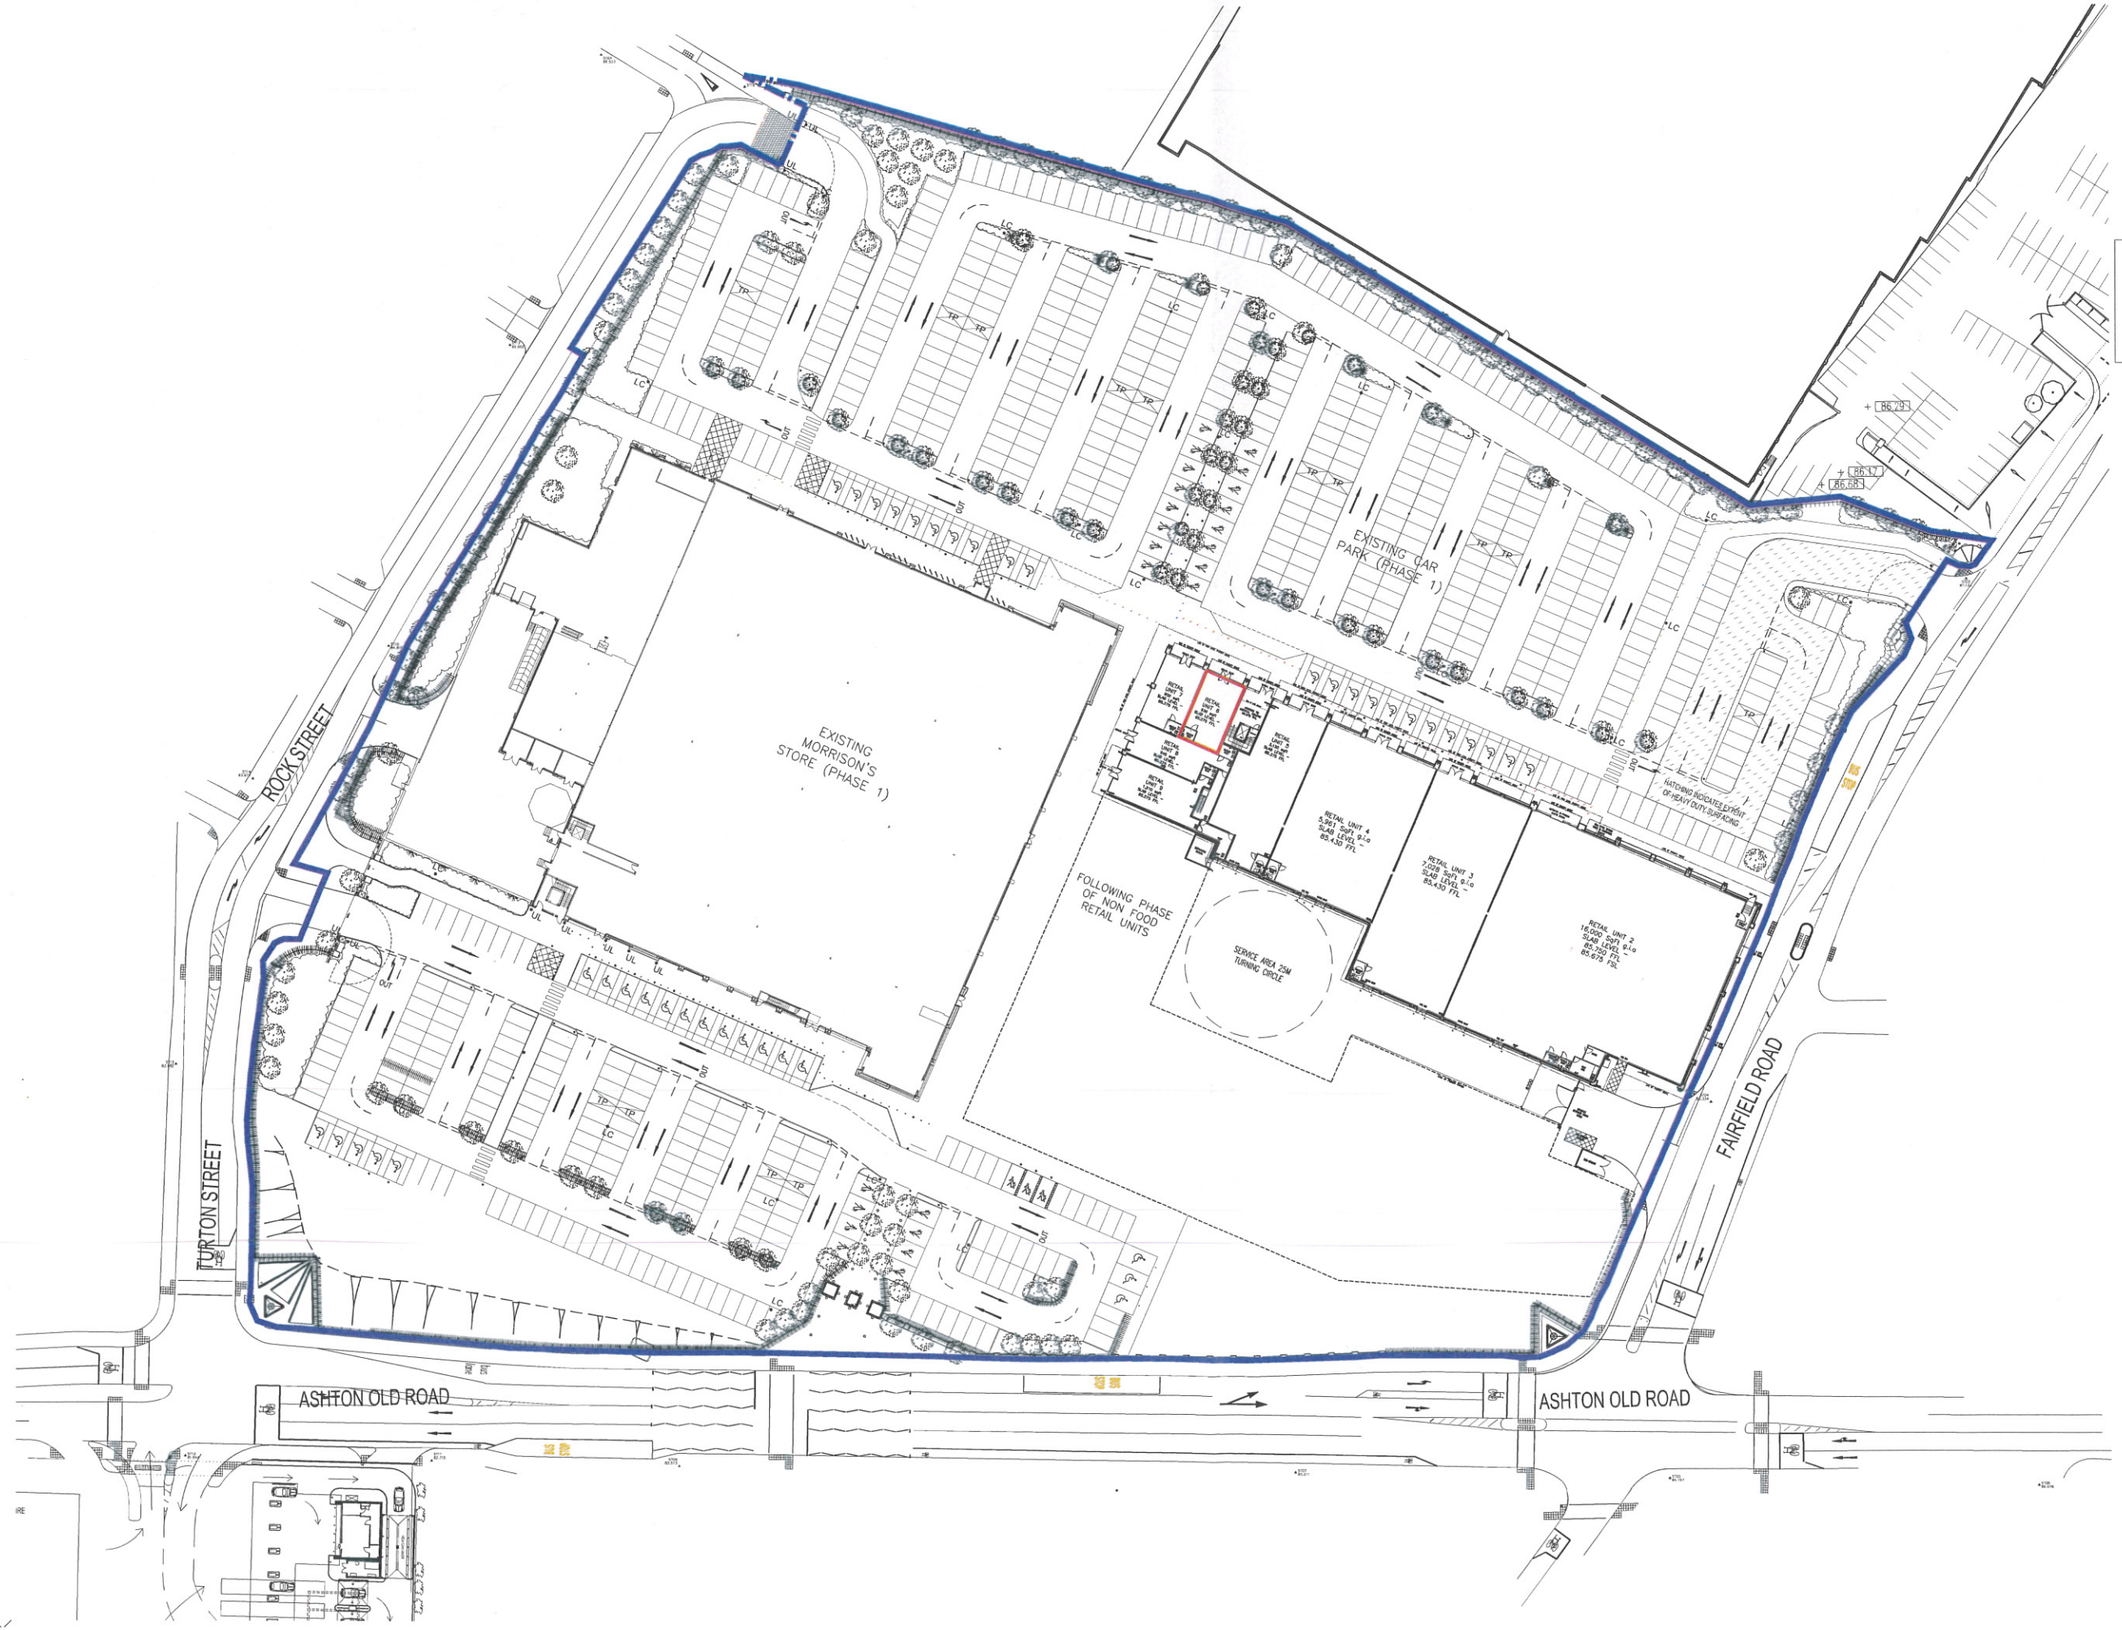


© WCEC ARCHITECTS - DISCLAIMER:

This drawing is copyright and shall not be reproduced nor used for any other purpose without the written permission of the Architects. This drawing must be read in conjunction with all other related drawings and documentation. It is the contractors responsibility to ensure full compliance with the Building Regulations. Do not scale from this drawing, use figured dimensions only. It is the contractors responsibility to check and verify all dimensions on site. Any discrepancies to be reported immediately.
IF IN DOUBT ASK.
Materials not in conformity with relevant British or European Standards/Codes of practice or materials known to be deleterious to health & safety must not be used or specified on this project.

XREF'S IN THIS DRAWING

SITE MODEL

GF MODEL

KEY:

- EXISTING DISABLED SIGNS (PHASE 1)
- EXISTING BOLLARDS (PHASE 1)
- No. 51 NEW BOLLARDS
- No. 12 NEW DISABLED SIGNS

No.	Date	Description	Drawn/ Chkd By

CLIENT
DRANSFIELD PROPERTIES LIMITED

Plan 1

PROJECT
NEW DISTRICT CENTRE
HIGHER OPENSHAW

TITLE
PROPOSED SITE LAYOUT PLAN RETAIL Unit 6

DRAWING STATUS
AS BUILT

DRAWN	CHECKED
SM	SW

SCALE 1:500 @ A1

DATE JANUARY 2012

wcec architects
Carrwood Court; Carrwood Road
Sheepbridge; Chesterfield; S41 9QB
t: 01246 260261; e: email@wcec.co.uk; www.wcec.co.uk

JOB NO.	DRAWING NO.	REV
09-009	A(20)_01 let 6	-