
PRODUCED BY AN AUTODESK EDUCATIONAL PRODUCT


39 Carmoor Road
Manchester
M13 0EA

As Built HMO Plans
Scale 1:50

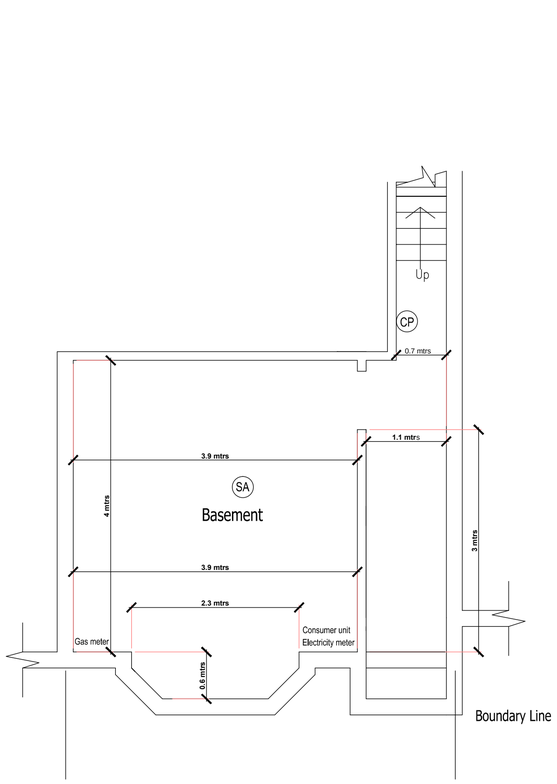


Basement Floor Plan


Note: Only ued to read meters

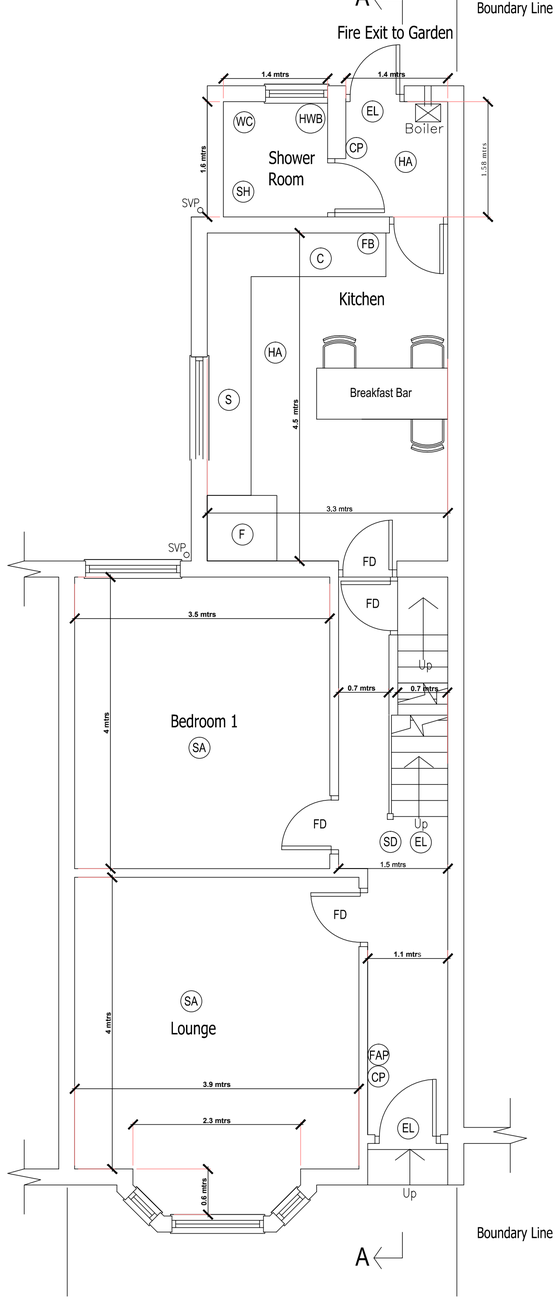

Ground Floor Plan

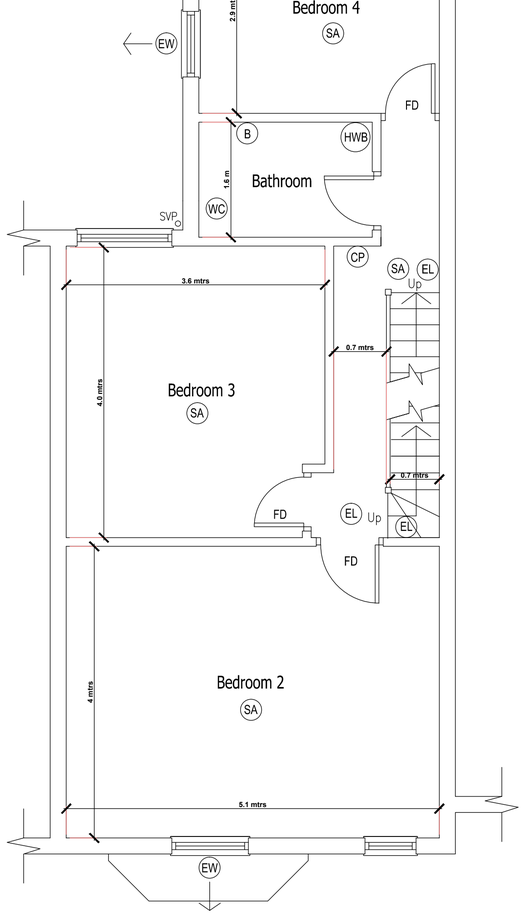

First Floor Plan

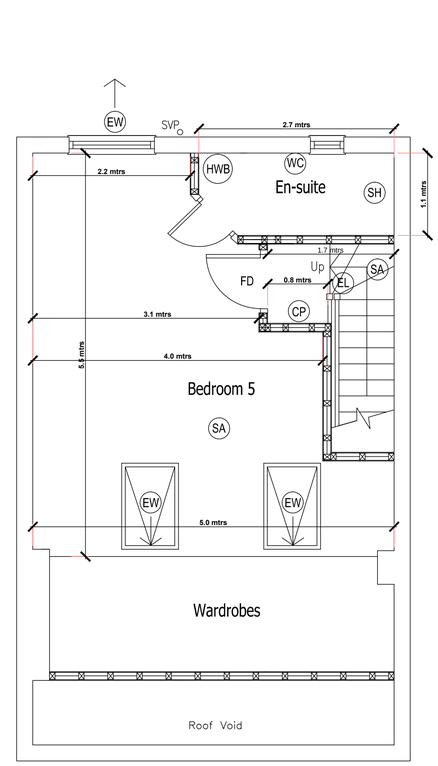

Second Floor Plan

Note: Minimum Ceiling Height
1.7 mtrs at wardrobe doors

PRODUCED BY AN AUTODESK EDUCATIONAL PRODUCT