PLANNING
RECD 28 FEB 2009

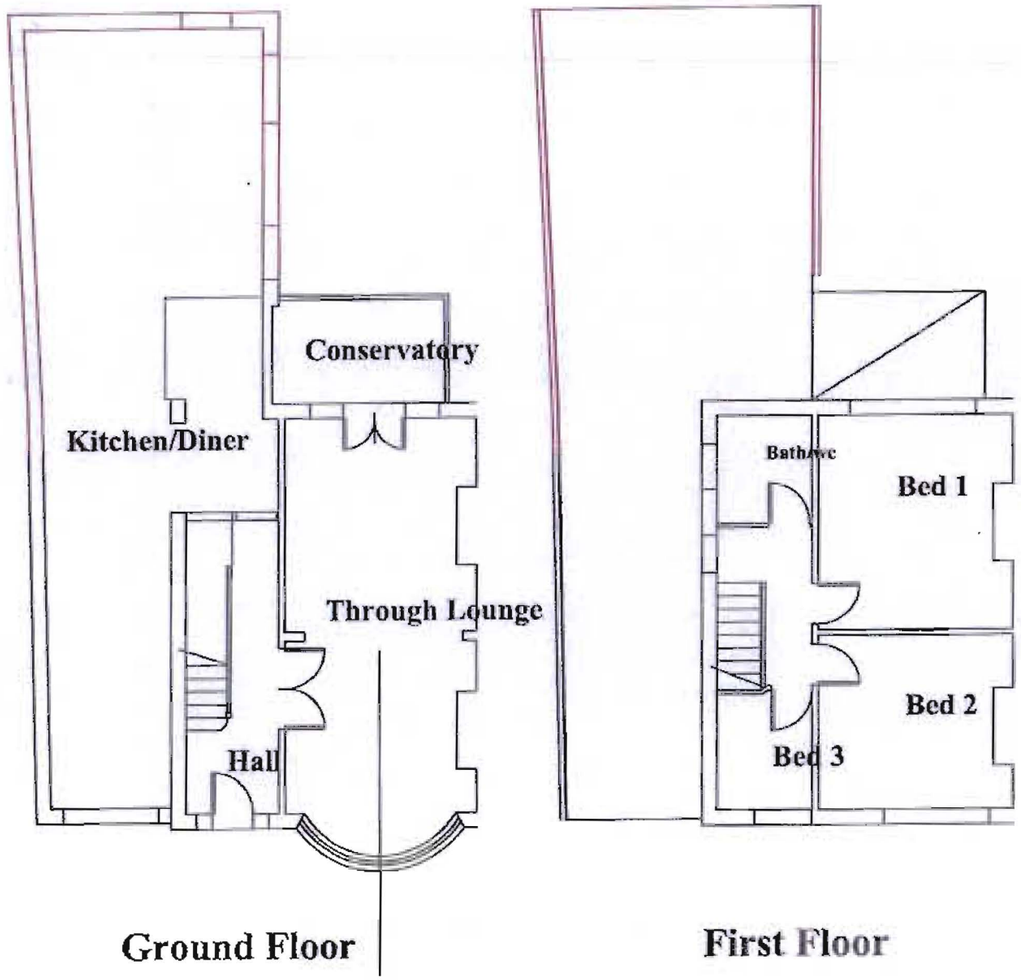

Unauthorised

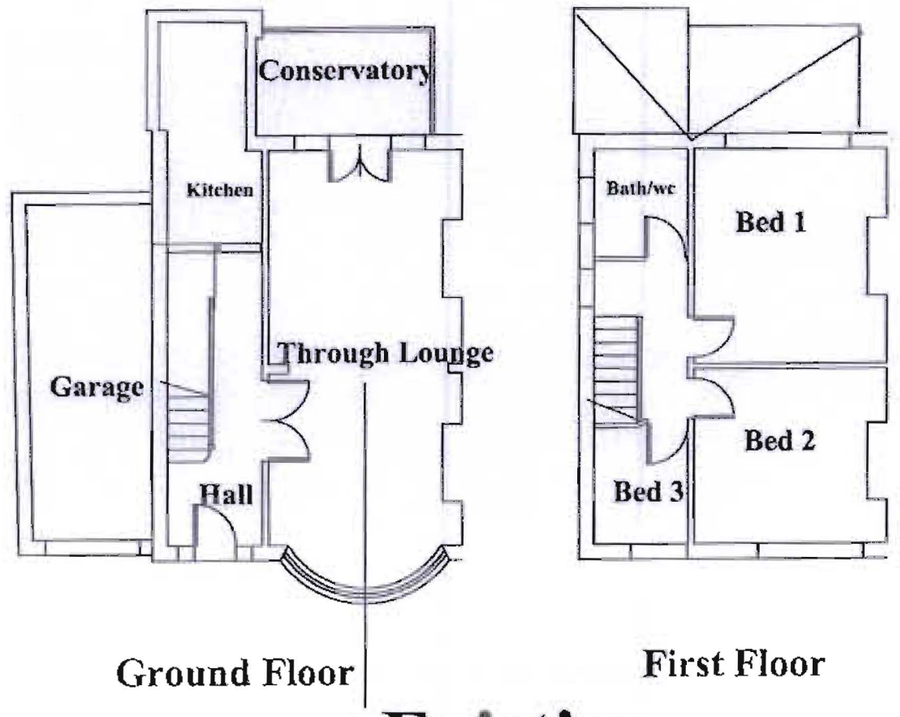

Existing

F SUMMERFIELD	20 Homestead Crescent Burnage, Manchester	Project 09.01.29	Sheet 01
	Existing & unauthorised plans - as built	Date 28.01.09	
		Scale 1:100 @ A3	Rev A