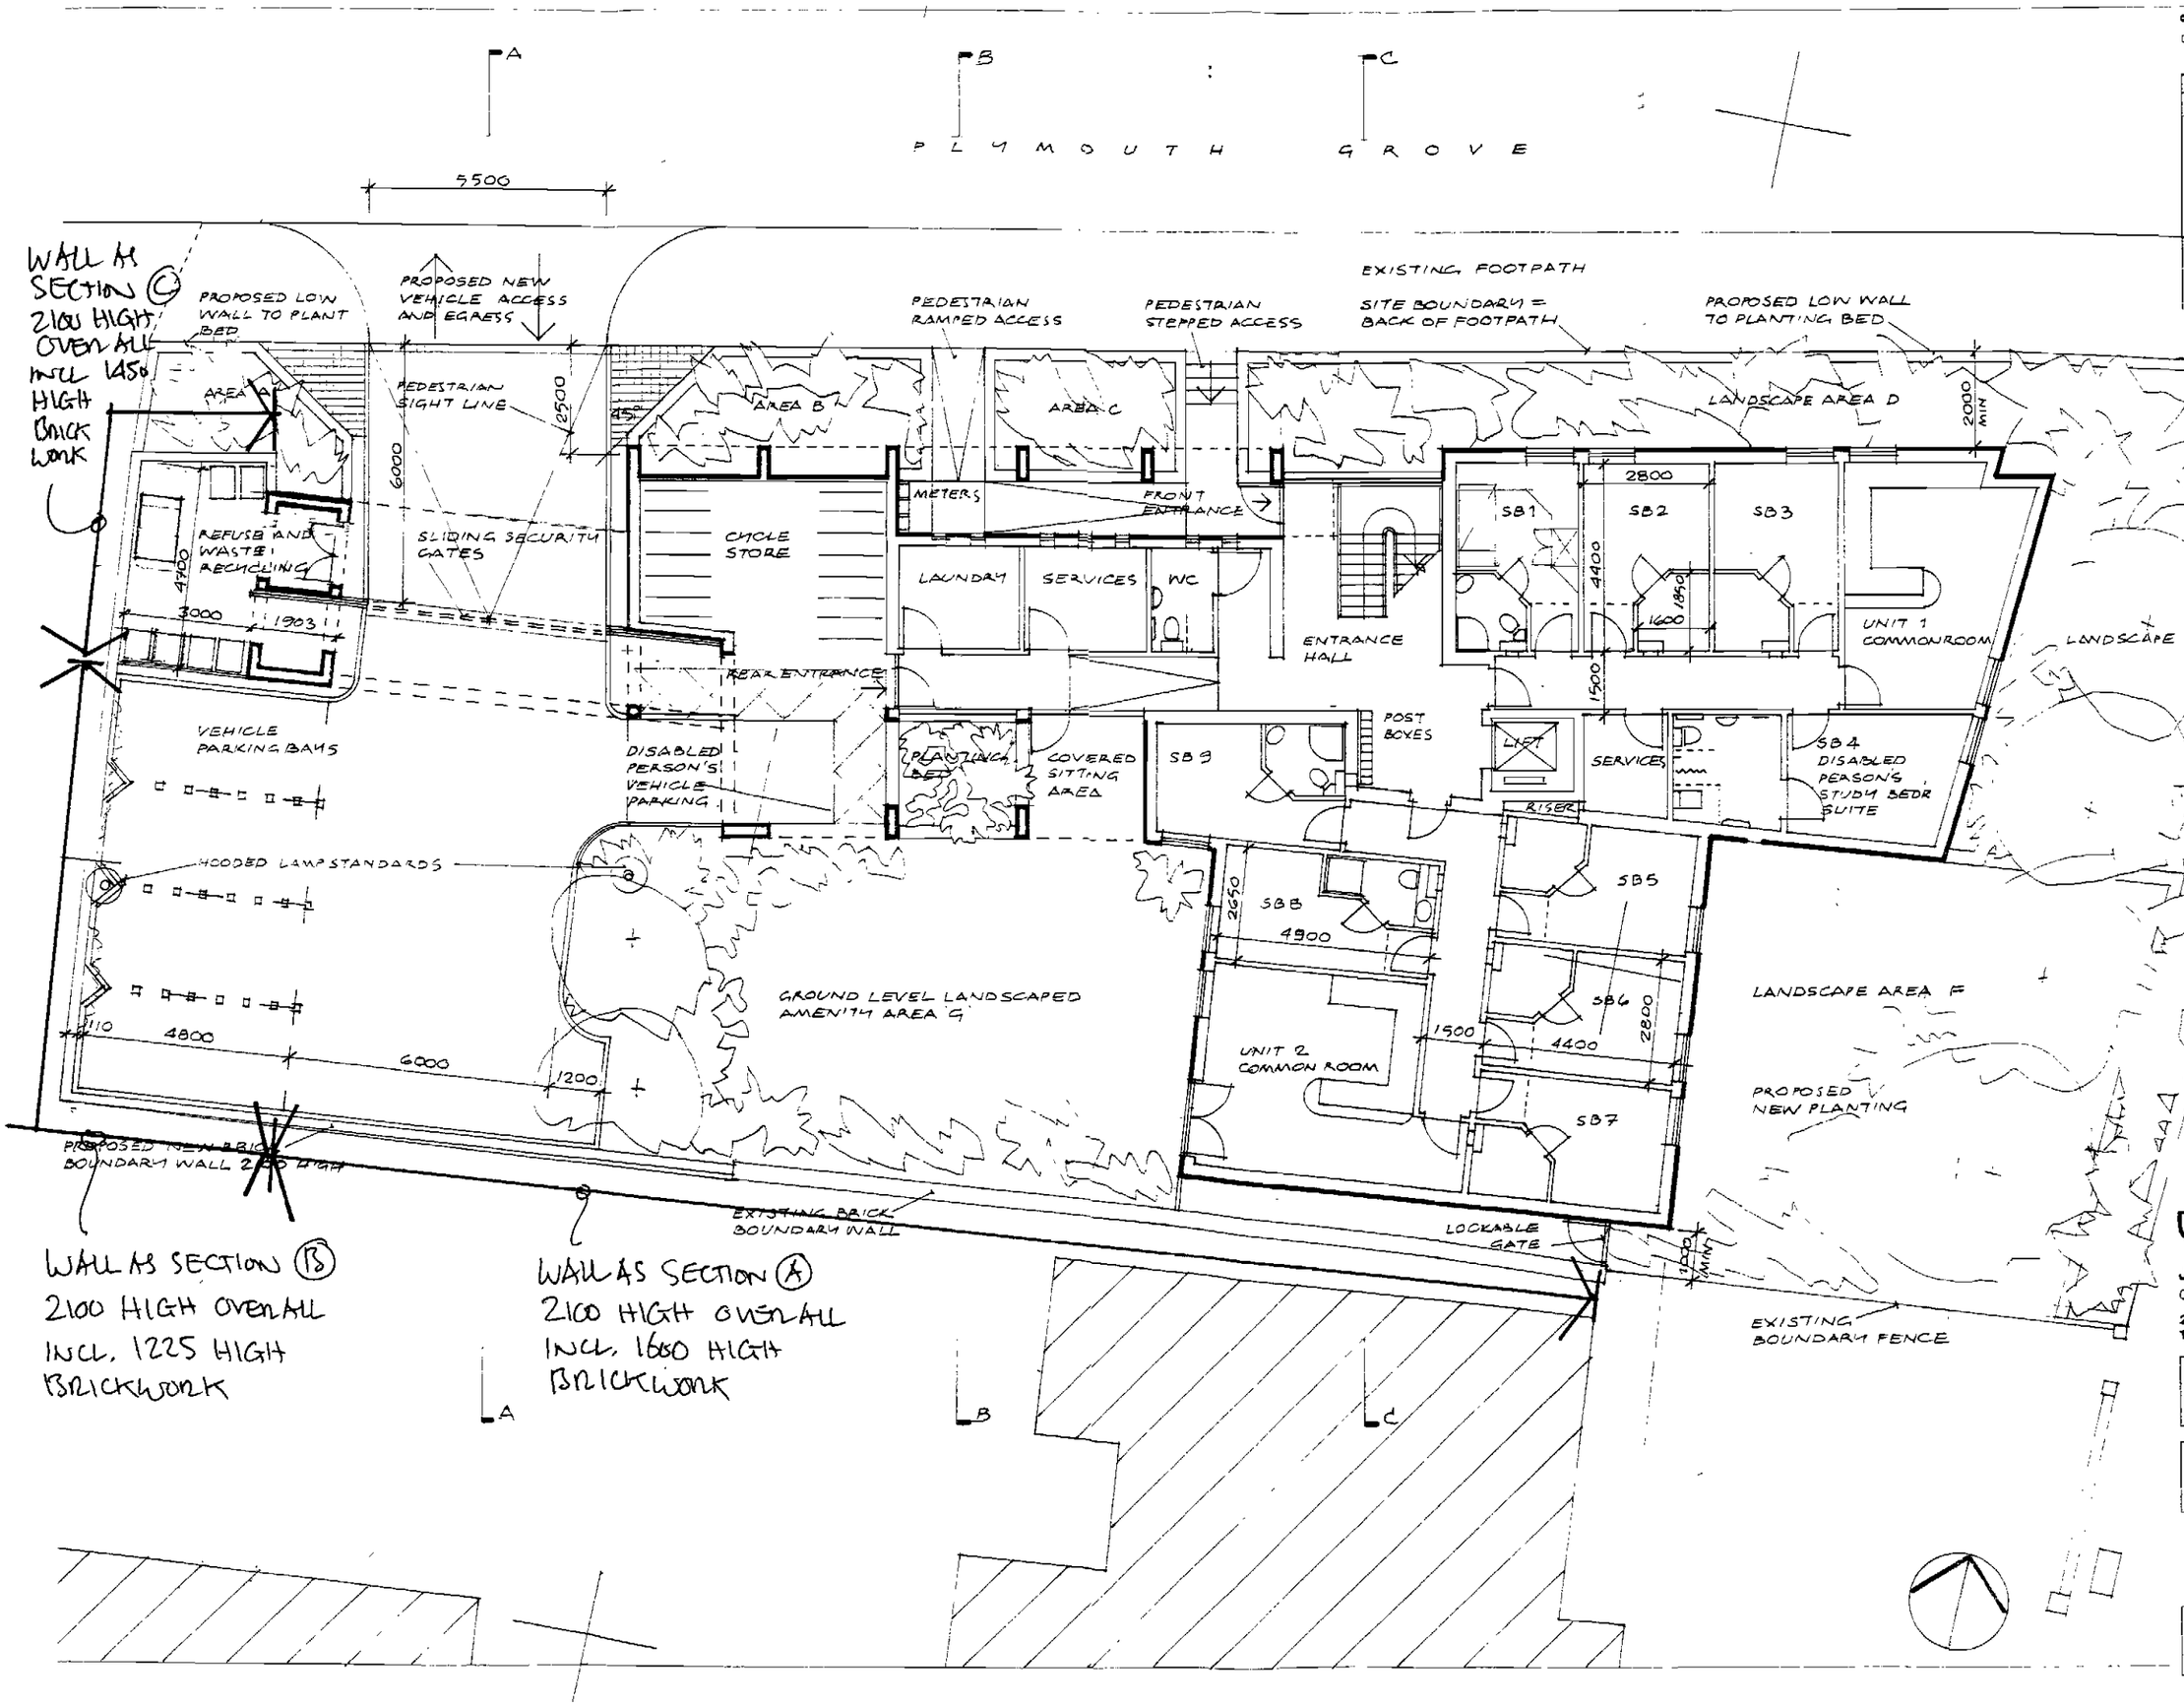

© Copyright retain
Do not scale off

2/7/08

Rev.	Descriptio

MARK UP TO SHOW AMMENDED WALL ENCLOSURE DETAILS
REF: BOUNDARY WALL DETAIL DWG REV A

CKD
REPLIED
RECD 04 JUL 2008
INT RECD DATE
FOIL ACTION

JG&A
Johnstone Godfrey and Associates
Chartered Architects and Planning Consultants
2 Swinton Sq, Knutsford, Cheshire, WA16 6HH
Tel: 01565 652126 Fax: 01565 652126

STUDENT HOUSING PLYMOUTH GROVE

GROUND FLOOR PLAN/SITE PLAN

Scale	Date	Drawn by
1:100	12·07	IR

Project No.	Dwg. No.	Rev.
1666	10	