

Appendix 1

Drawings Schedule

Drawings Attached:

Drawing No.	Title
24/M19-2EN/FENCE/01	Land Ownership - Official Copy (Title Plan) of Title No. GM116953
24/M19-2EN/FENCE/02	Plan of Existing Fence Line and As-Built Roof Overhang
24/M19-2EN/FENCE/03	Plan of Existing and Old Fence Lines
24/M19-2EN/FENCE/04	Plan of Existing Fence Line and Old Fence Line and Proposed Roof Alteration
24/M19-2EN/FENCE/05	Side Elevation of As-Built Fence

These are the notes referred to on the following official copy

The electronic official copy of the title plan follows this message.

Please note that this is the only official copy we will issue. We will not issue a paper official copy.

This official copy was delivered electronically and when printed will not be to scale. You can obtain a paper official copy by ordering one from Land Registry.

Additional references, which are not referred to in the register of title, may appear on the title plan in respect of any pending applications.

This official copy is issued on 25 January 2012 shows the state of this title plan on 25 January 2012 at 20:09:14. It is admissible in evidence to the same extent as the original (s.67 Land Registration Act 2002). This title plan shows the general position, not the exact line, of the boundaries. It may be subject to distortions in scale. Measurements scaled from this plan may not match measurements between the same points on the ground. See Land Registry Public Guide 7 - *Title Plans*.

This title is dealt with by the Land Registry, Fylde Office .

© Crown copyright. Produced by Land Registry. Reproduction in whole or in part is prohibited without the prior written permission of Ordnance Survey. Licence Number 100026316.

DRG. NO. 24|M19-2EN|FENCE|01 : LAND OWNERSHIP-
OFFICIAL COPY (TITLE PLAN) OF TITLE
NO GM116953

24 CENTRAL AVENUE, MANCHESTER, M19 2EN

H. M. LAND REGISTRY

DRG. NO. J 24/M19-2EN/FENCE/01

NATIONAL GRID PLAN SJ 8794 SECTION

GREATER MANCHESTER

MANCHESTER DISTRICT Scale 1/1250

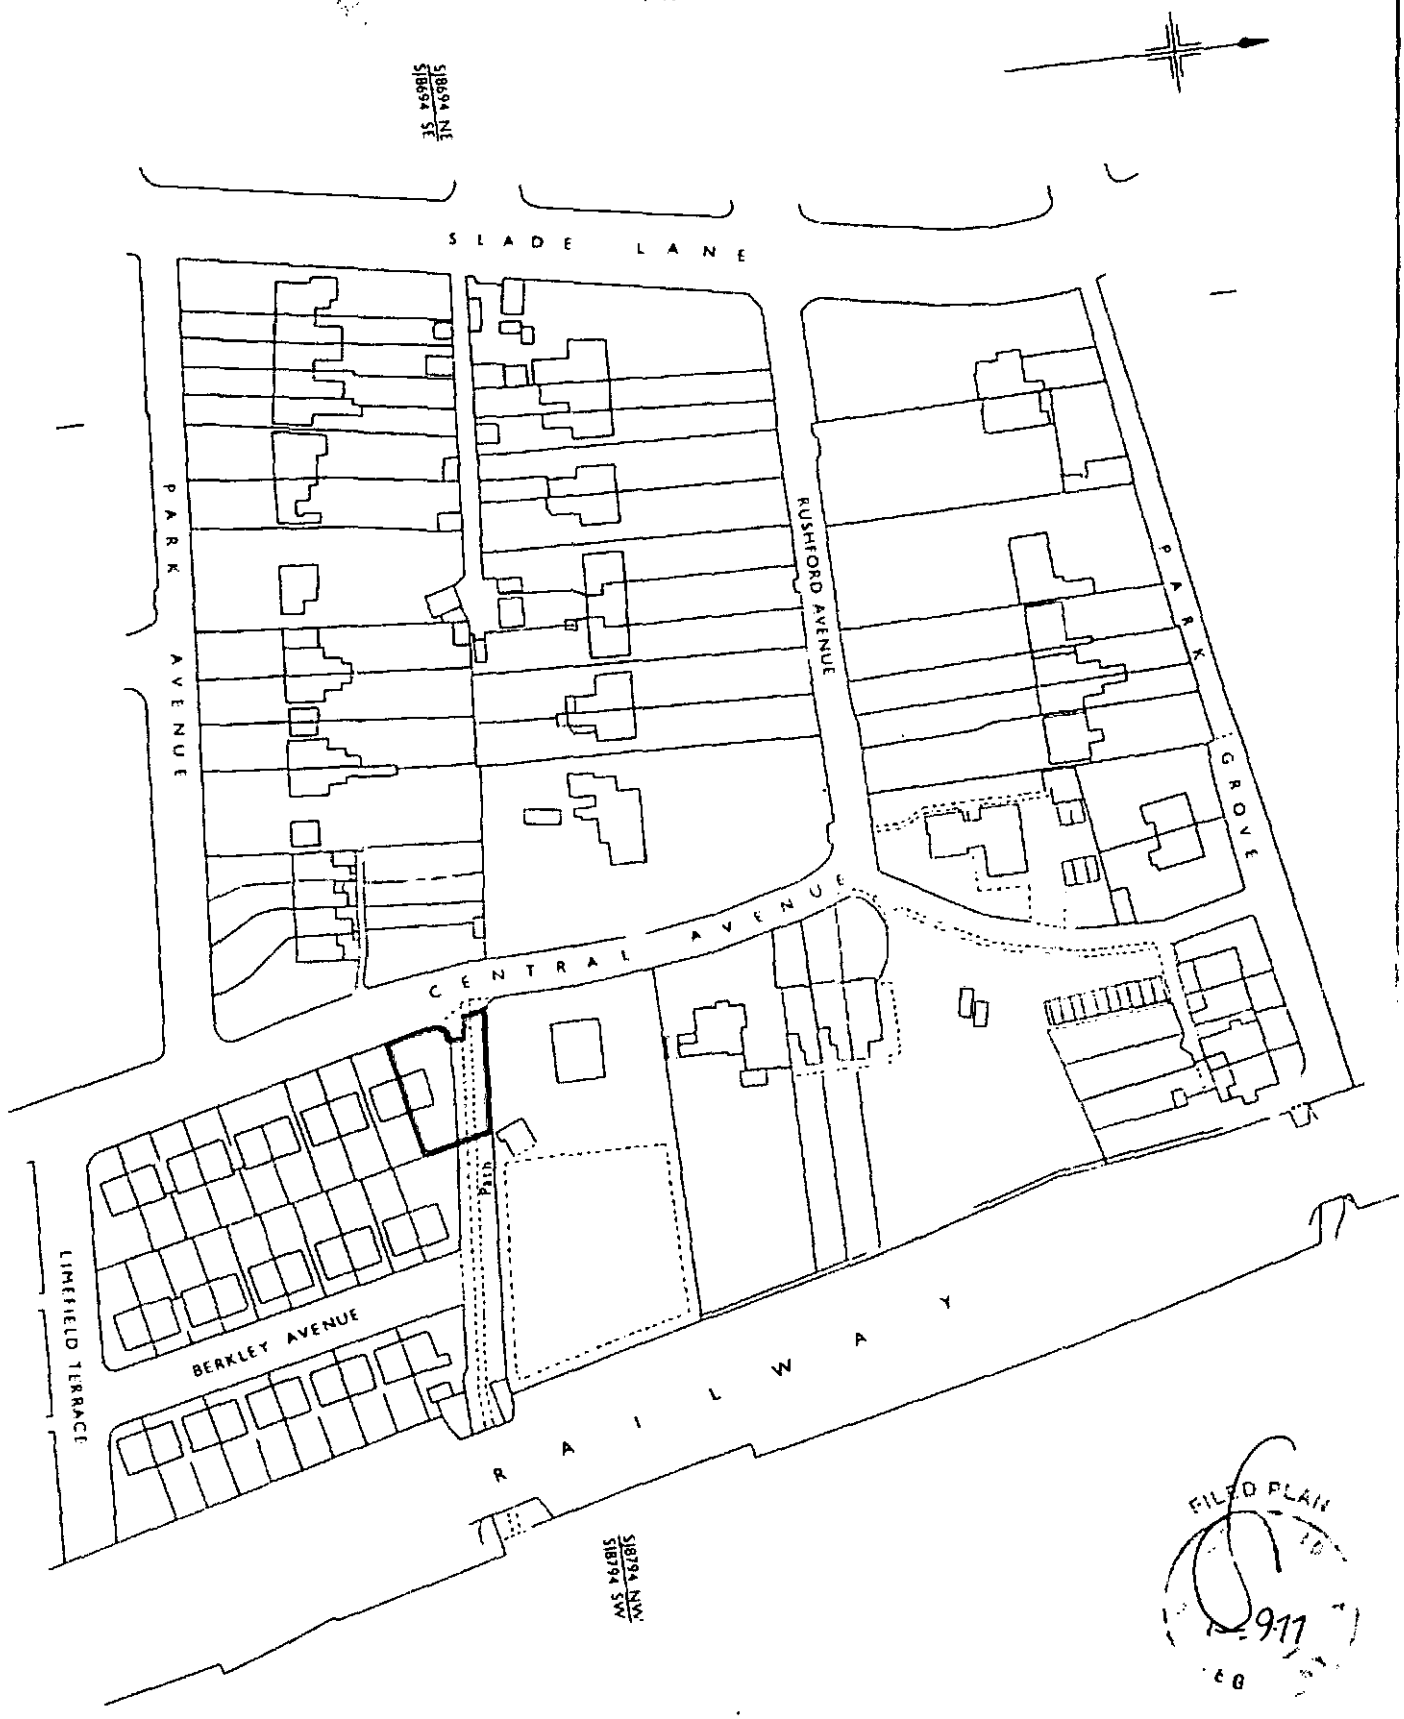

FILED PLAN

911

© Crown Copyright 1976

TITLE No. GM 116953

This official copy is incomplete without the preceding notes page.

DRG. N° 24/M19-2EN/FENCE/02 : PLAN OF EXISTING FENCE AND AS-BUILT ROOF OVERHANG

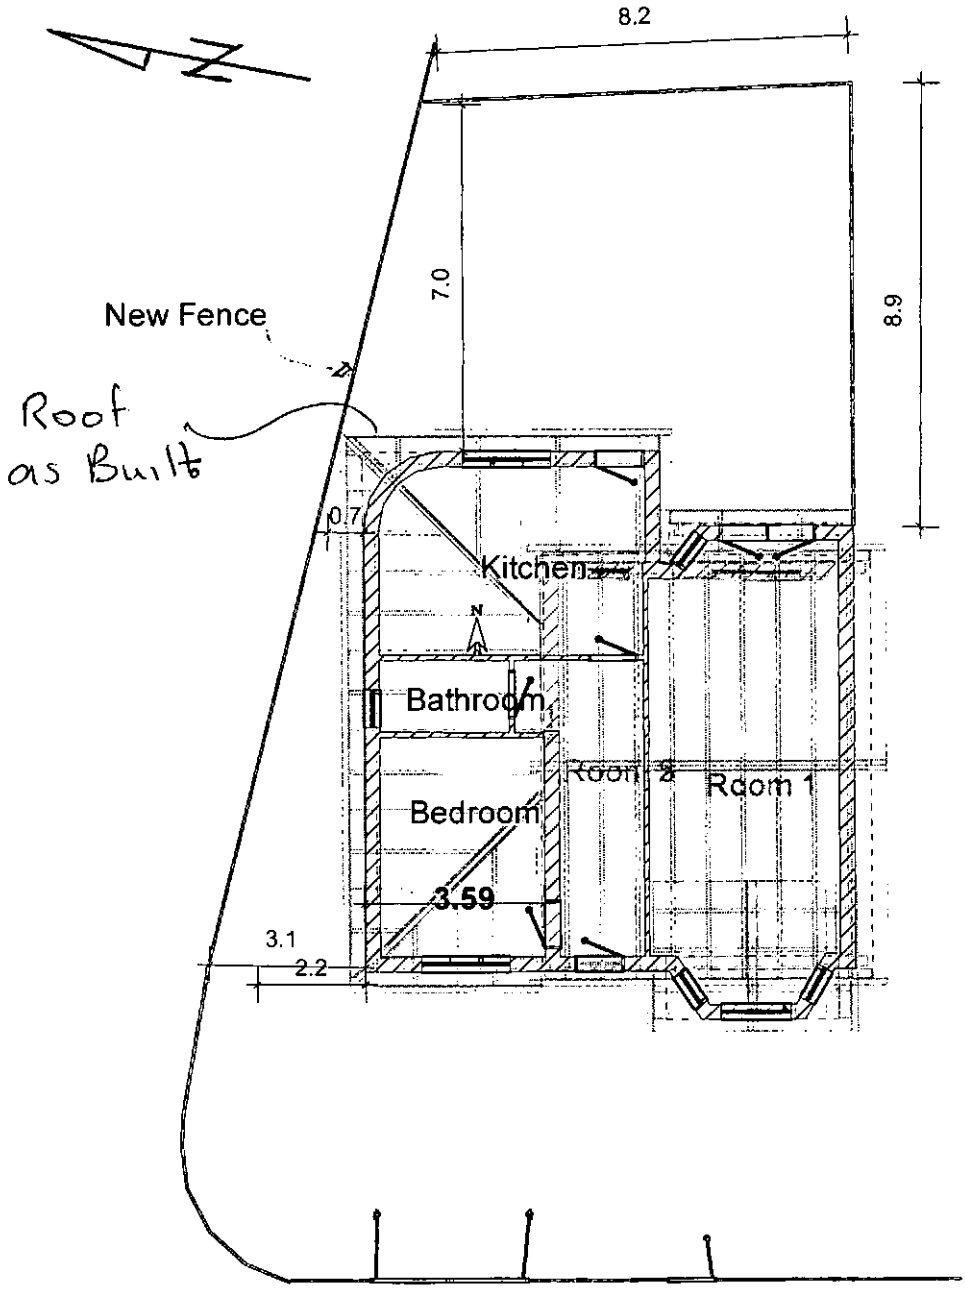

24 central avenue
Ground floor
06/11/2012
1 : 150
ELECO VISUAL ARCHITECTURE

DRG. NO. 24|M19-2EN|FENCE|03 : PLAN OF EXISTING AND OLD FENCE LINES

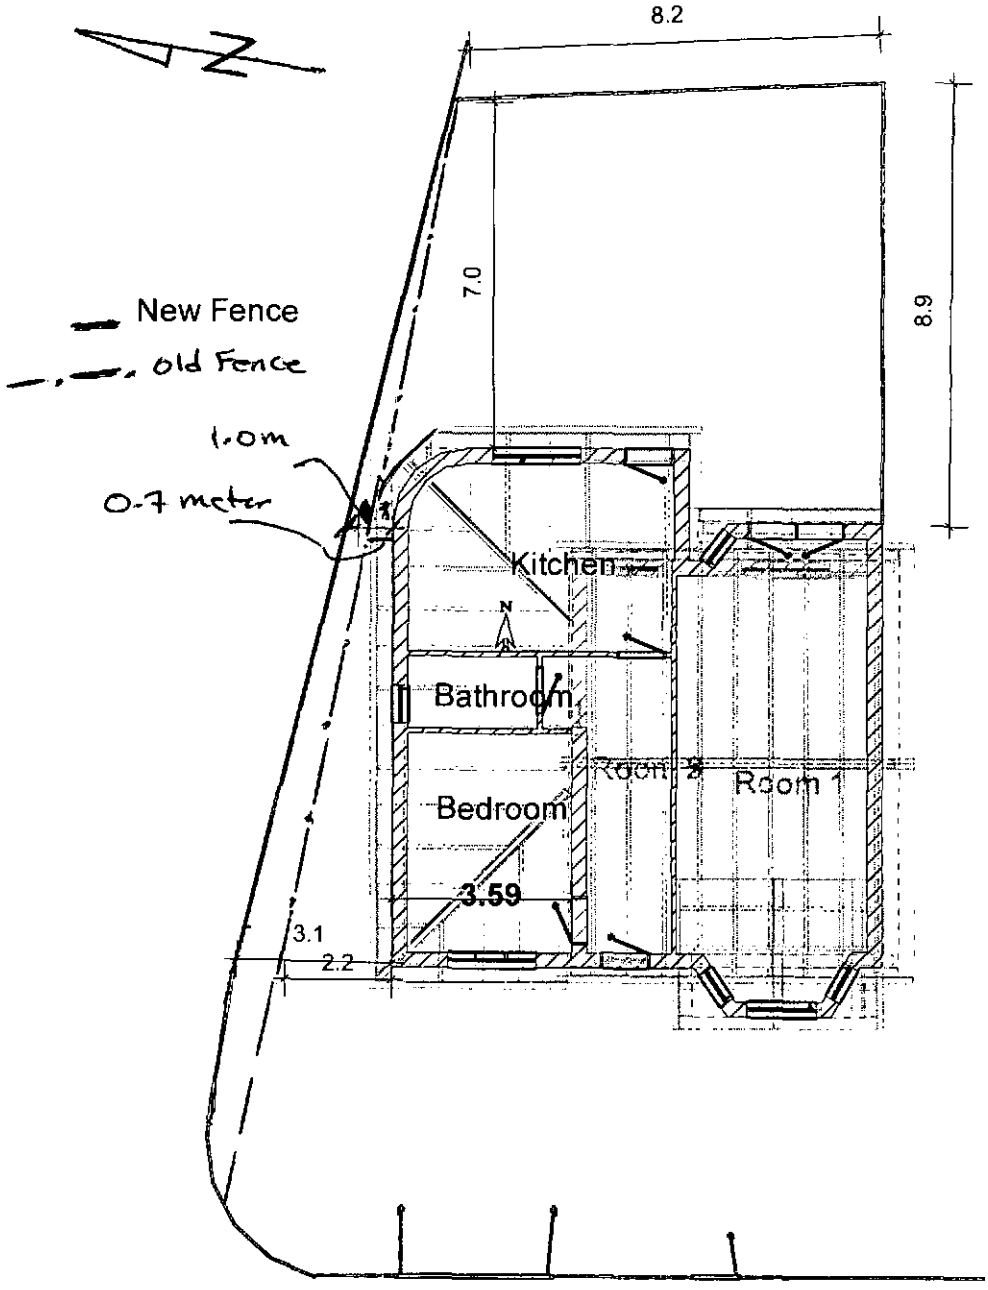

24 central avenue
Ground floor
06/11/2012
1 : 150

ELECO VISUAL ARCHITECTURE

DRG. NO, 24|M19-2EN|FENCE|04 : PLAN OF EXISTING FENCE LINE AND OLD FENCE LINE AND PROPOSED ROOF ALTERATION

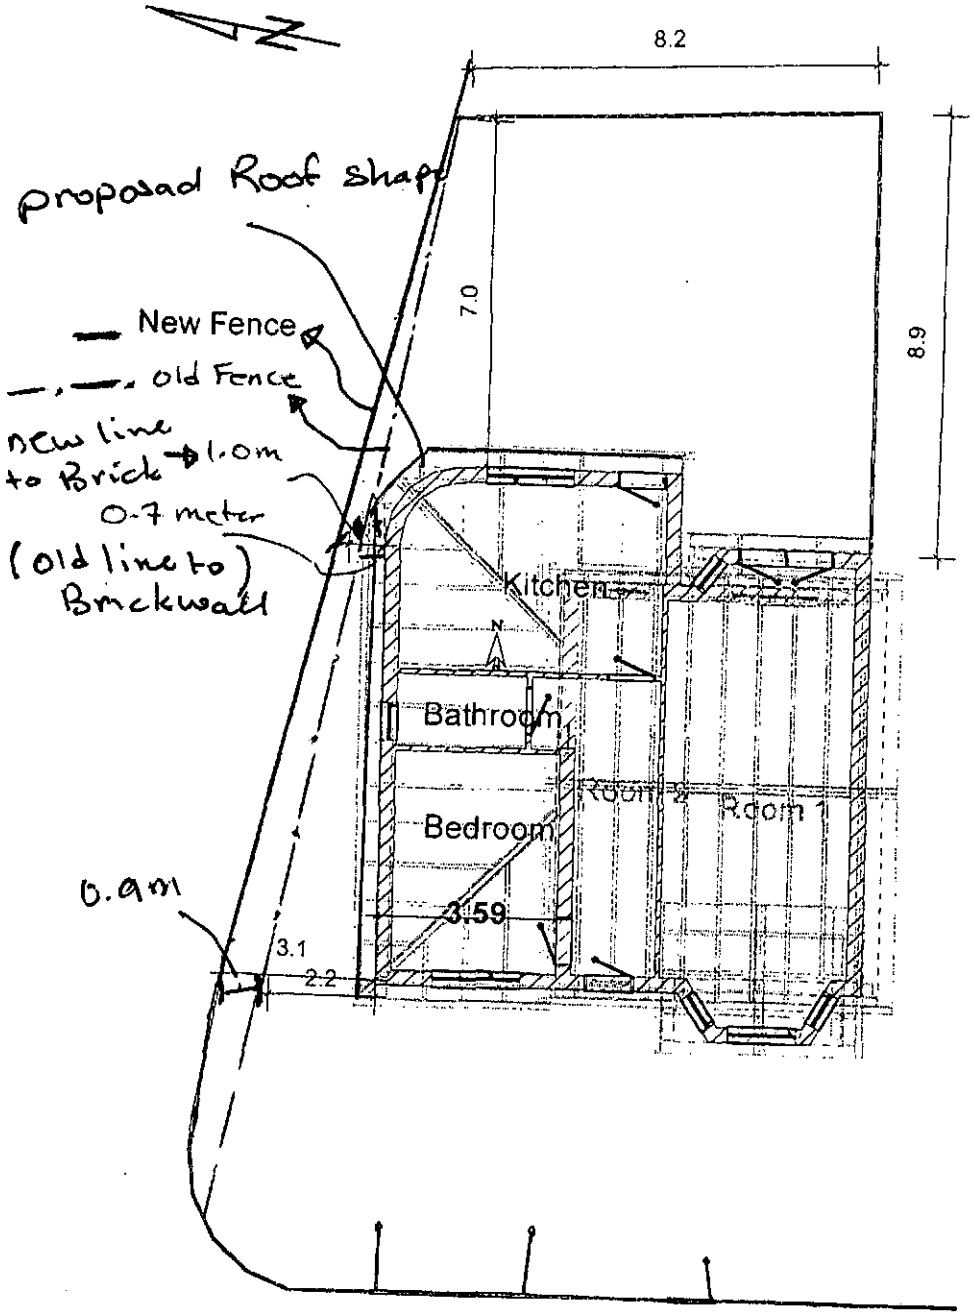

24 central avenue	
Ground floor	
06/11/2012	
1 : 150	ELECO VISUAL ARCHITECTURE

Side elevation for the ne fence

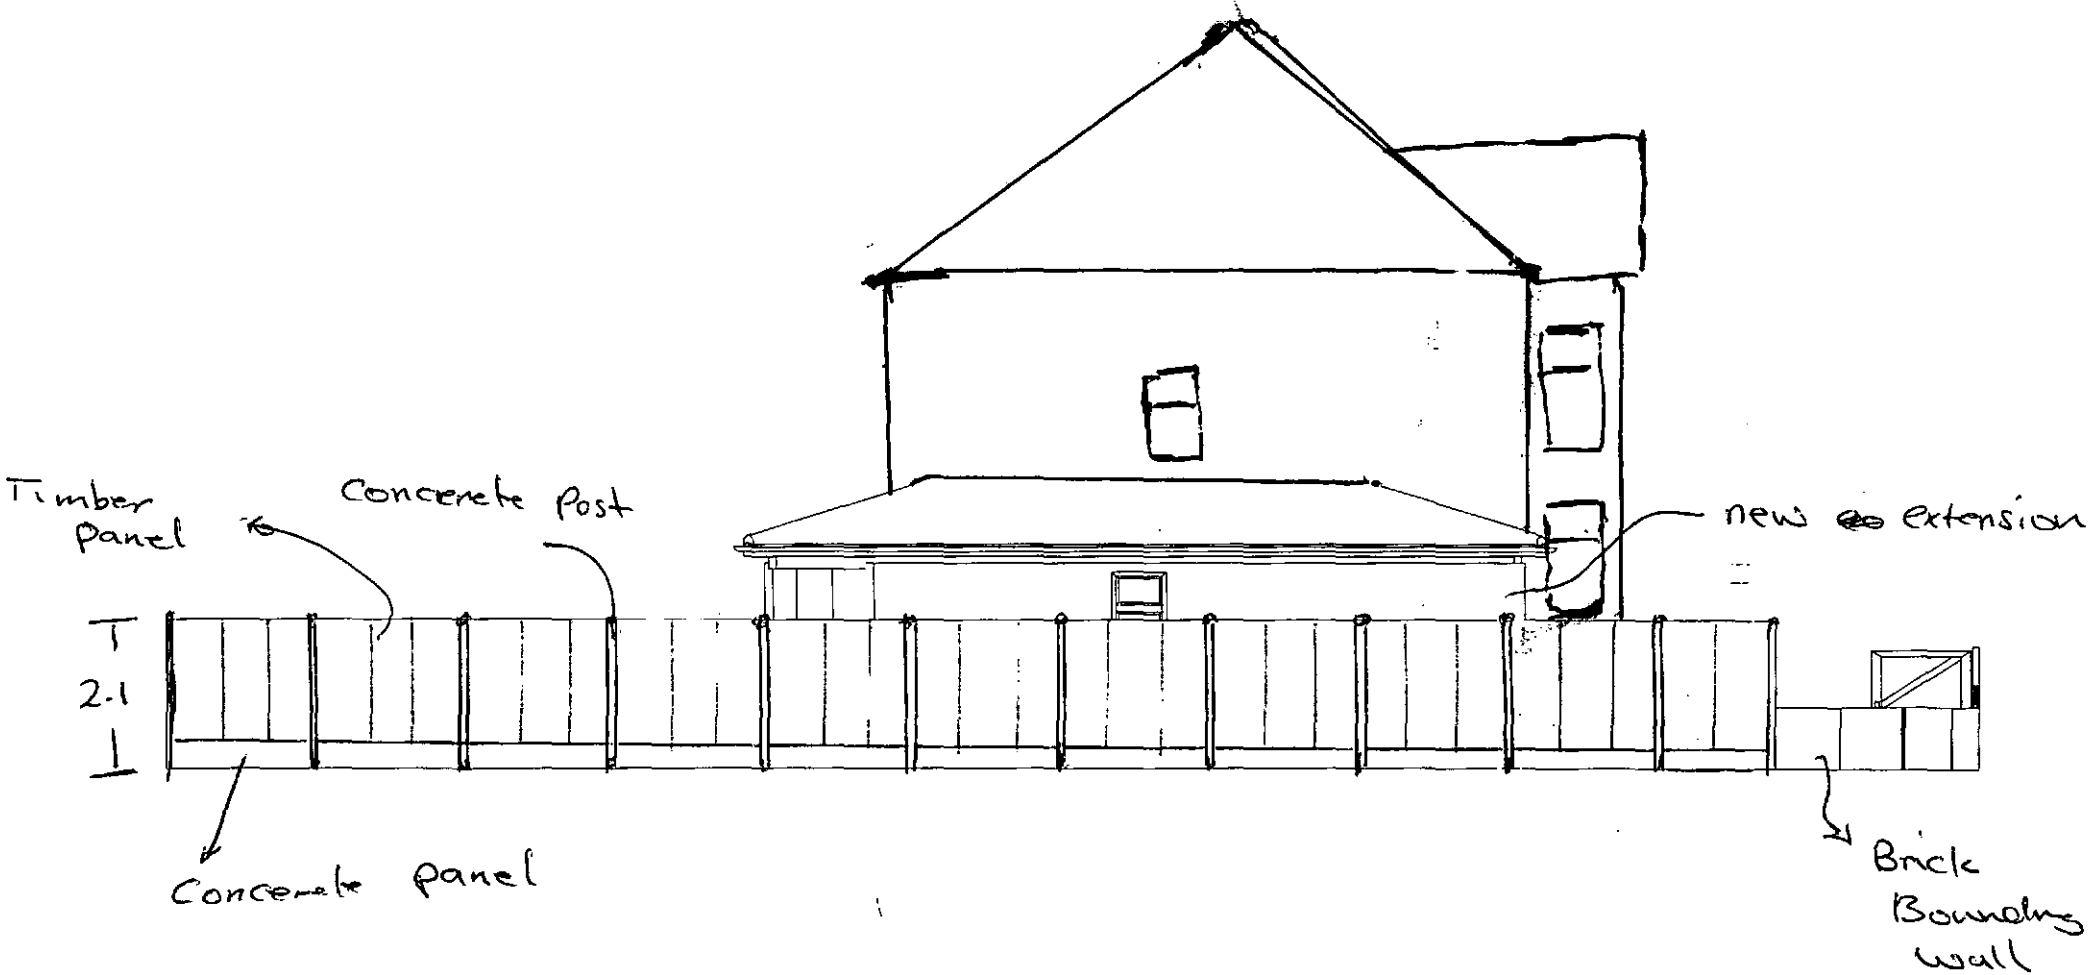

DRG. No 24/M19-2EN/FENCE/05 : SIDE ELEVATION OF AS-BUILT FENCE

24 central avenue
Side elevation for
06/11/2012
1 : 103
ELECO VISUAL ARCHITECTURE