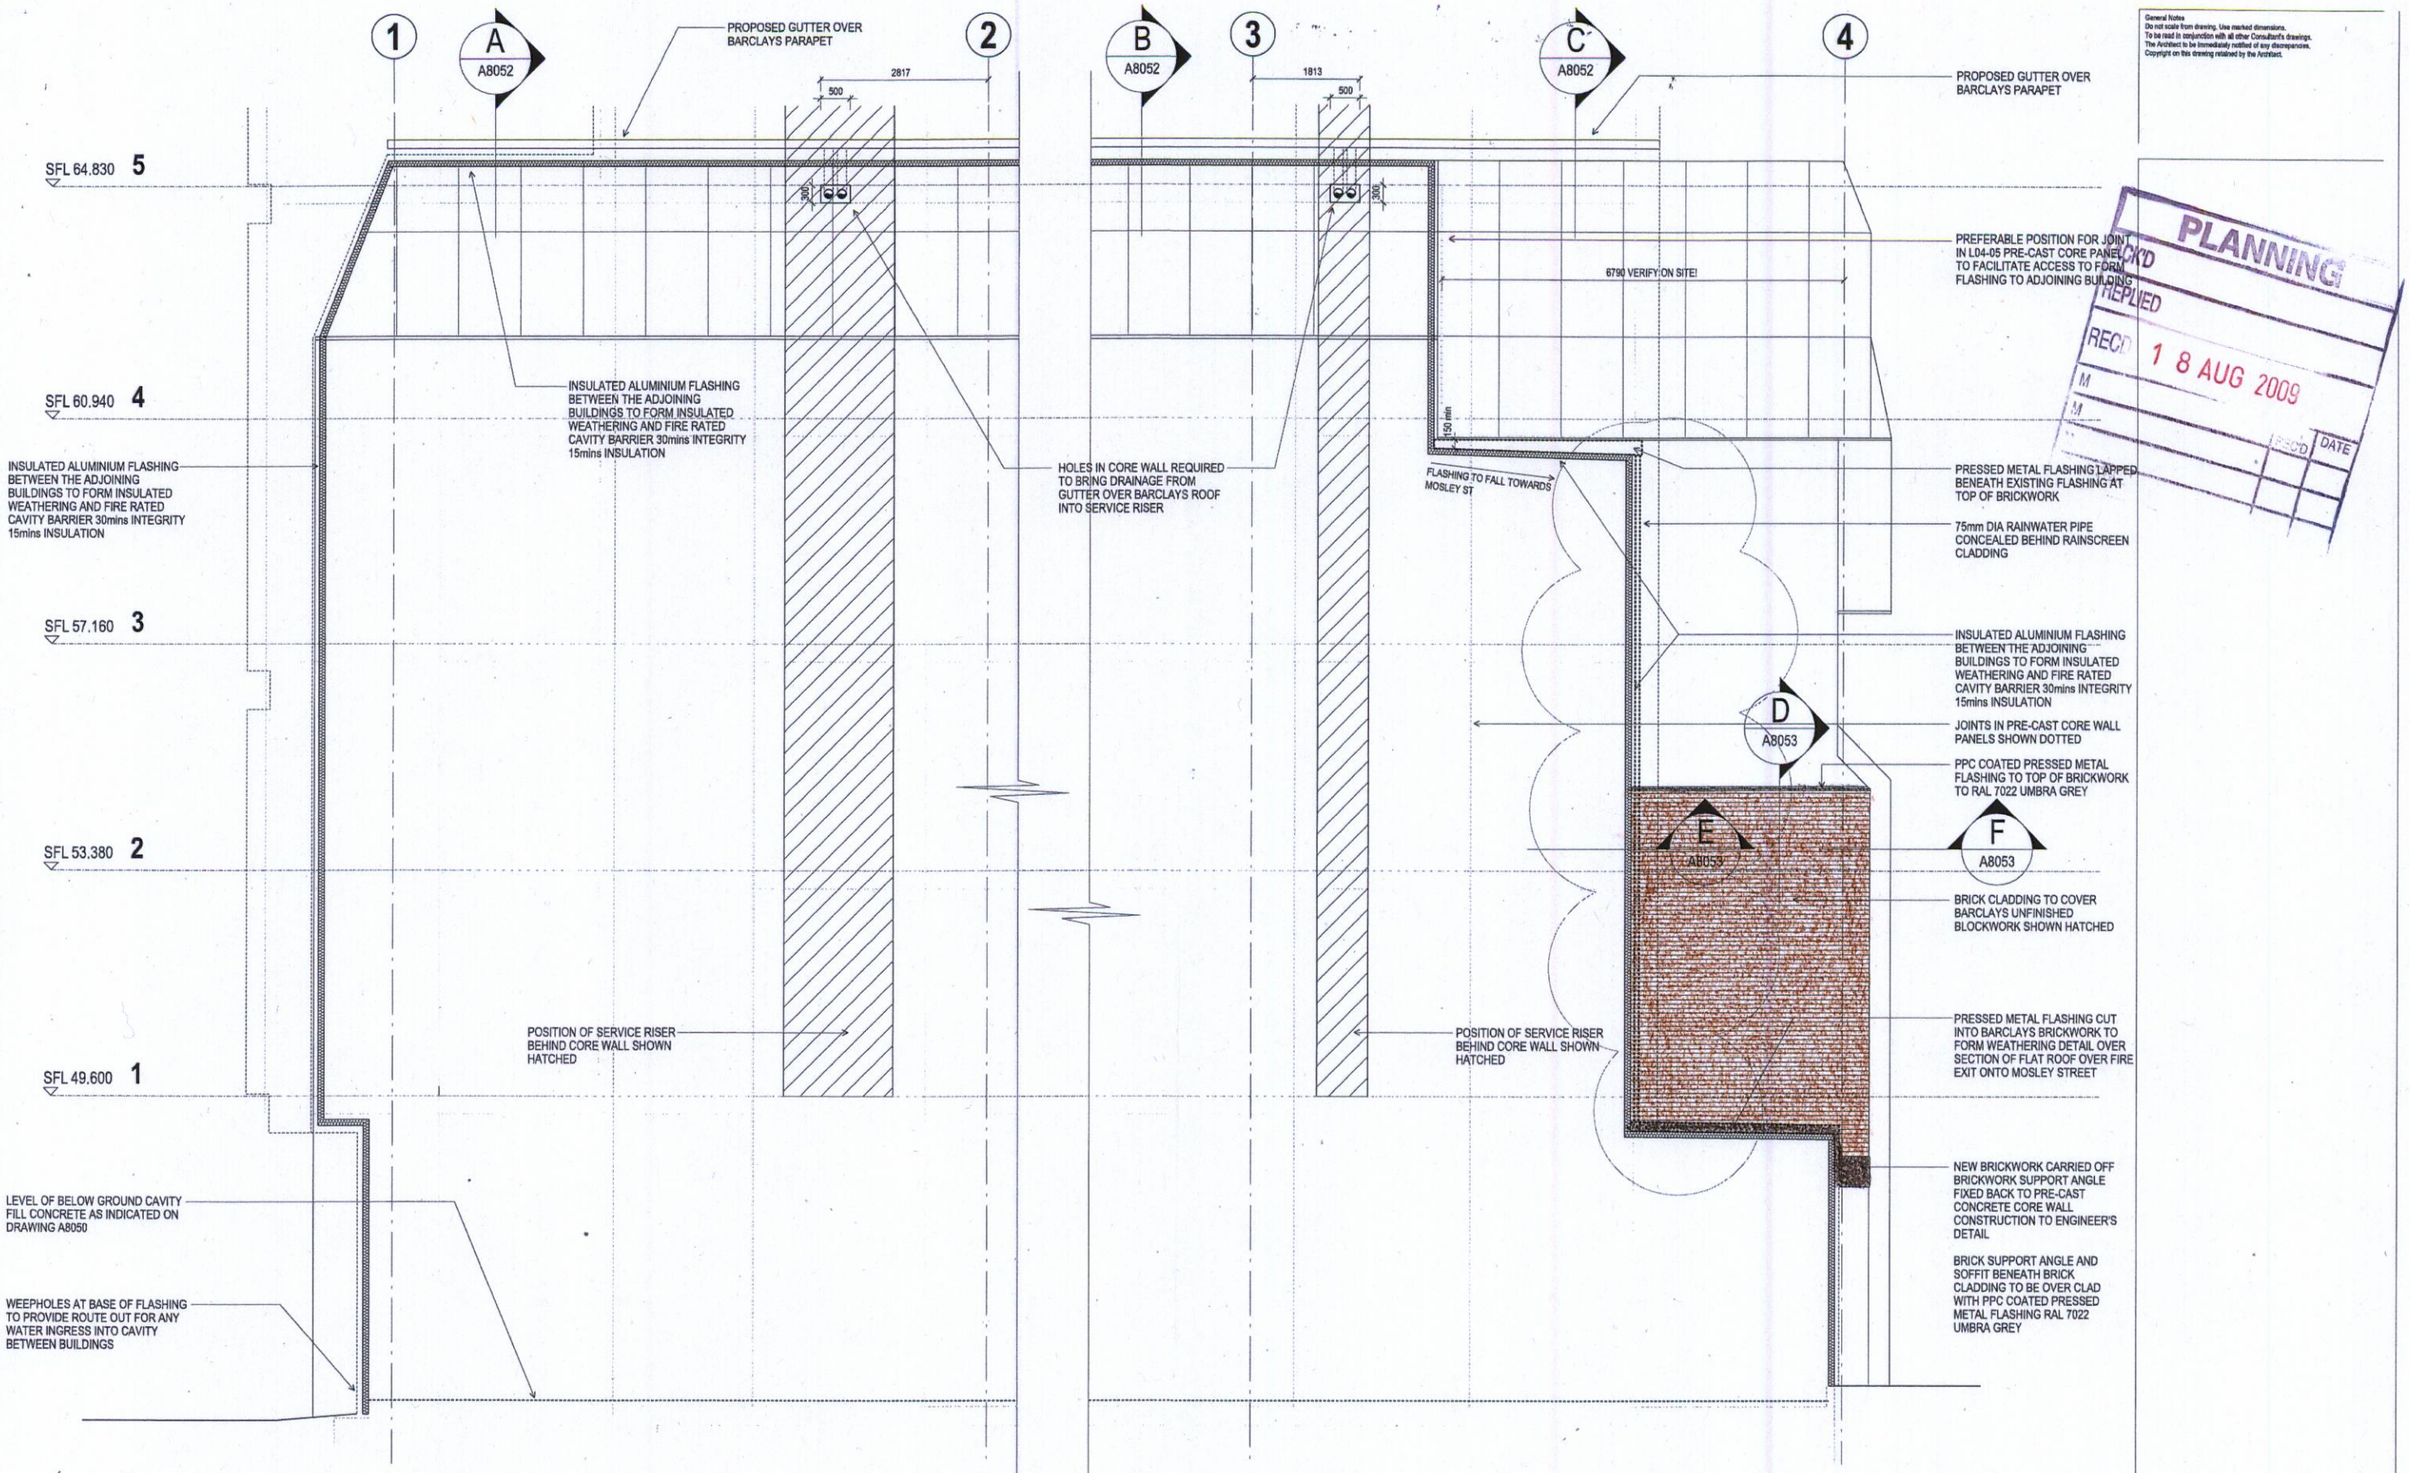

ELEVATION OF ADJOINING BUILDING

General Notes
Do not scale from drawing. Use marked dimensions.
To be read in conjunction with all other Consultant's drawings.
The Architect to be immediately notified of any discrepancies.
Copyright on this drawing retained by the Architect.

PLANNING
CK'D
REPLIED
RECD 18 AUG 2009
M
M
RECD DATE

Scale / North Point
1:50 @ A1 0 0.5 1 2M

No.	Date	Dwn	Chk.	App	Revision or reason for issue
X0	18/07/2008	TG	JR	SQ	DRAWING ISSUED TO PARTY WALL SURVEYORS / ENWINEERS / CONTRACTOR FOR COMMENT
X1	02/12/2008	TG	JR	SQ	DETAIL REFERENCES TO RENDERED AREA ADDED
X2	22/05/2009	TG	JR	SQ	RENDERED AREA AMENDED TO BRICKWORK (AS BUILT)
X3	11/06/2009	TG	JR	SQ	CONCEALED RAINWATER PIPE POSITION INDICATED

DENTON CORKER MARSHALL
Architect
Denton Corker Marshall Limited
Level 10 Lowry House
Spring Gardens
Manchester
M2 3AW
Telephone 0161 834 3511

Project Title
1 NEW YORK STREET MANCHESTER

Client
Brunswood Estates Limited
City Tower
Piccadilly Plaza
Manchester
M1 4BD
Telephone 0161 237 3663

Drawing Title
ABOVE GROUND ABUTMENT DETAILS TO BARCLAYS BANK

Project Number 6339
Drawing Number A8051
Drawing Status CONSTRUCTION
Revision X3