General Notes

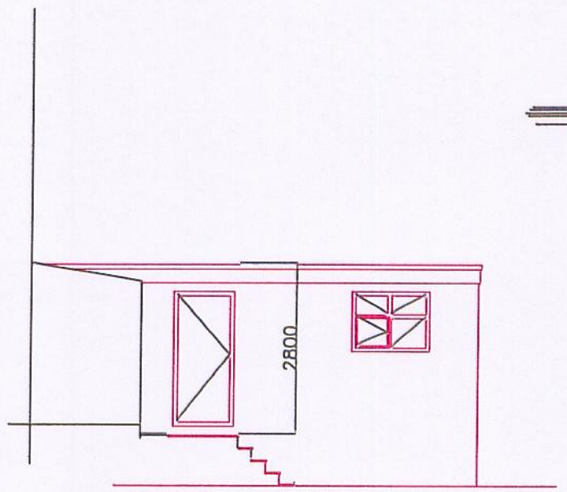

Inside flank

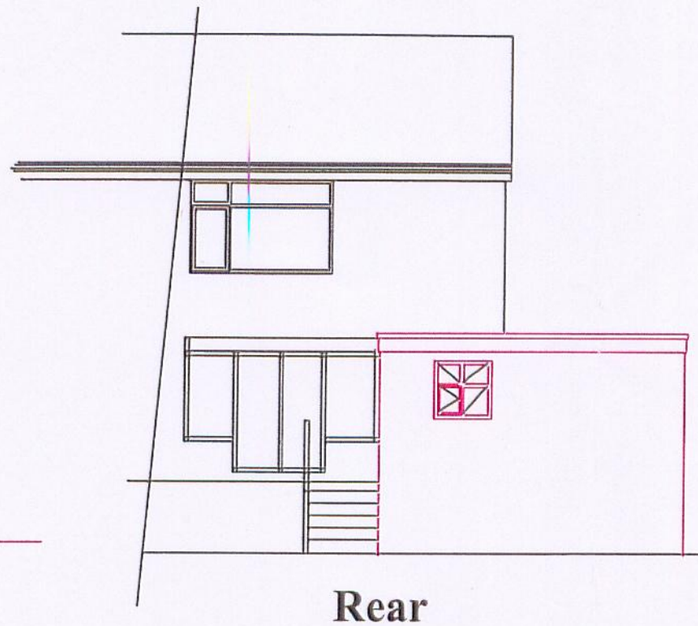

Rear



Outside flank

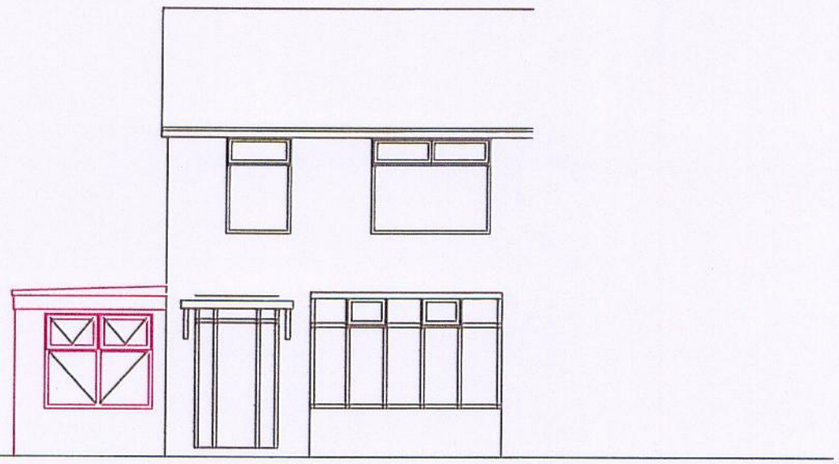

Front

PLANNING
ACKD
REPLIED
REC'D 26 FEB 2009
M
M
M
FOR ACTION
INIT. REC'D
DATE

Unauthorised

No.	Revision/Issue	Date
-	-	-/-/--
-	-	-/-/--

F SUMMERFIELD
BSc (hons), CEng, FICE, MIStructE
Chartered Consulting, Civil, Structural & Municipal Engineer,
Planning Supervisor & Party Wall Surveyor. (Part Of Terplan Ltd)
216 Heaton Moor Road, Stockport, SK4 4DU
Tel. 0161-443 1801 . Mobile: 07802-296627 . Fax 0161-431 8766 .
Web Site: http://www.terplan.co.uk/engineer, e-mail: fs@terplan.co.uk

Project, Name and Address
20 Homestead Crescent
Burnage, Manchester

Unauthorised elevations - As Built

Project	Sheet
09.01.29	02
Date: 28.01.09	
Scale: 1:100 @ A3	Rev A