

NOTE MACHINE

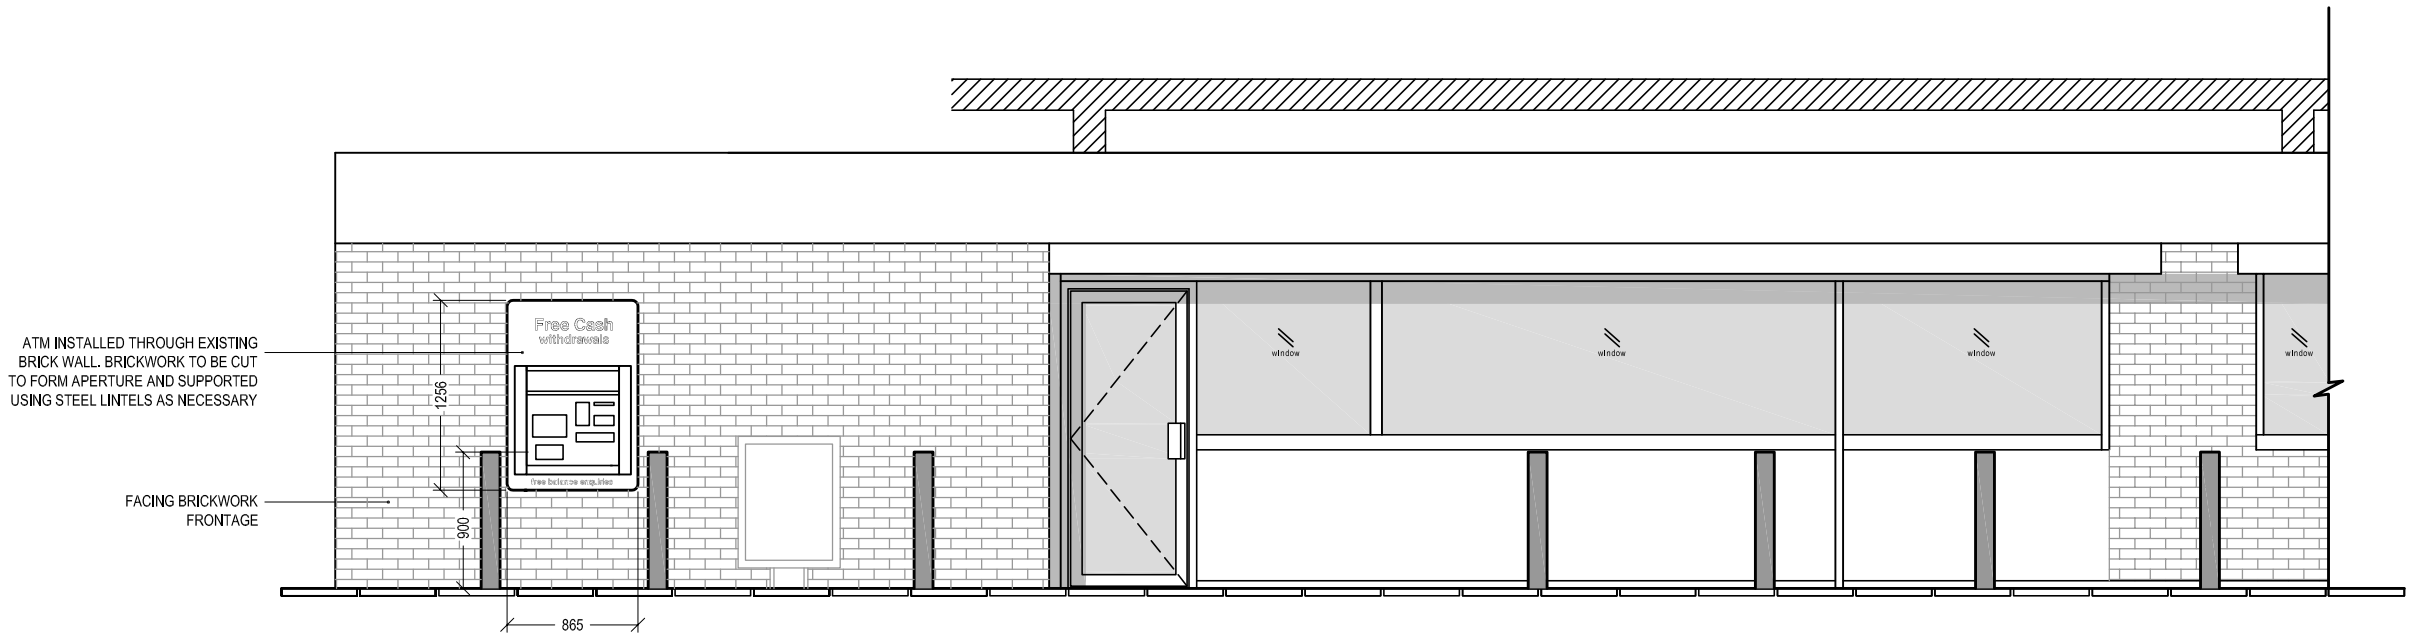

AS INSTALLED FRONT ELEVATION
Scale 1:50

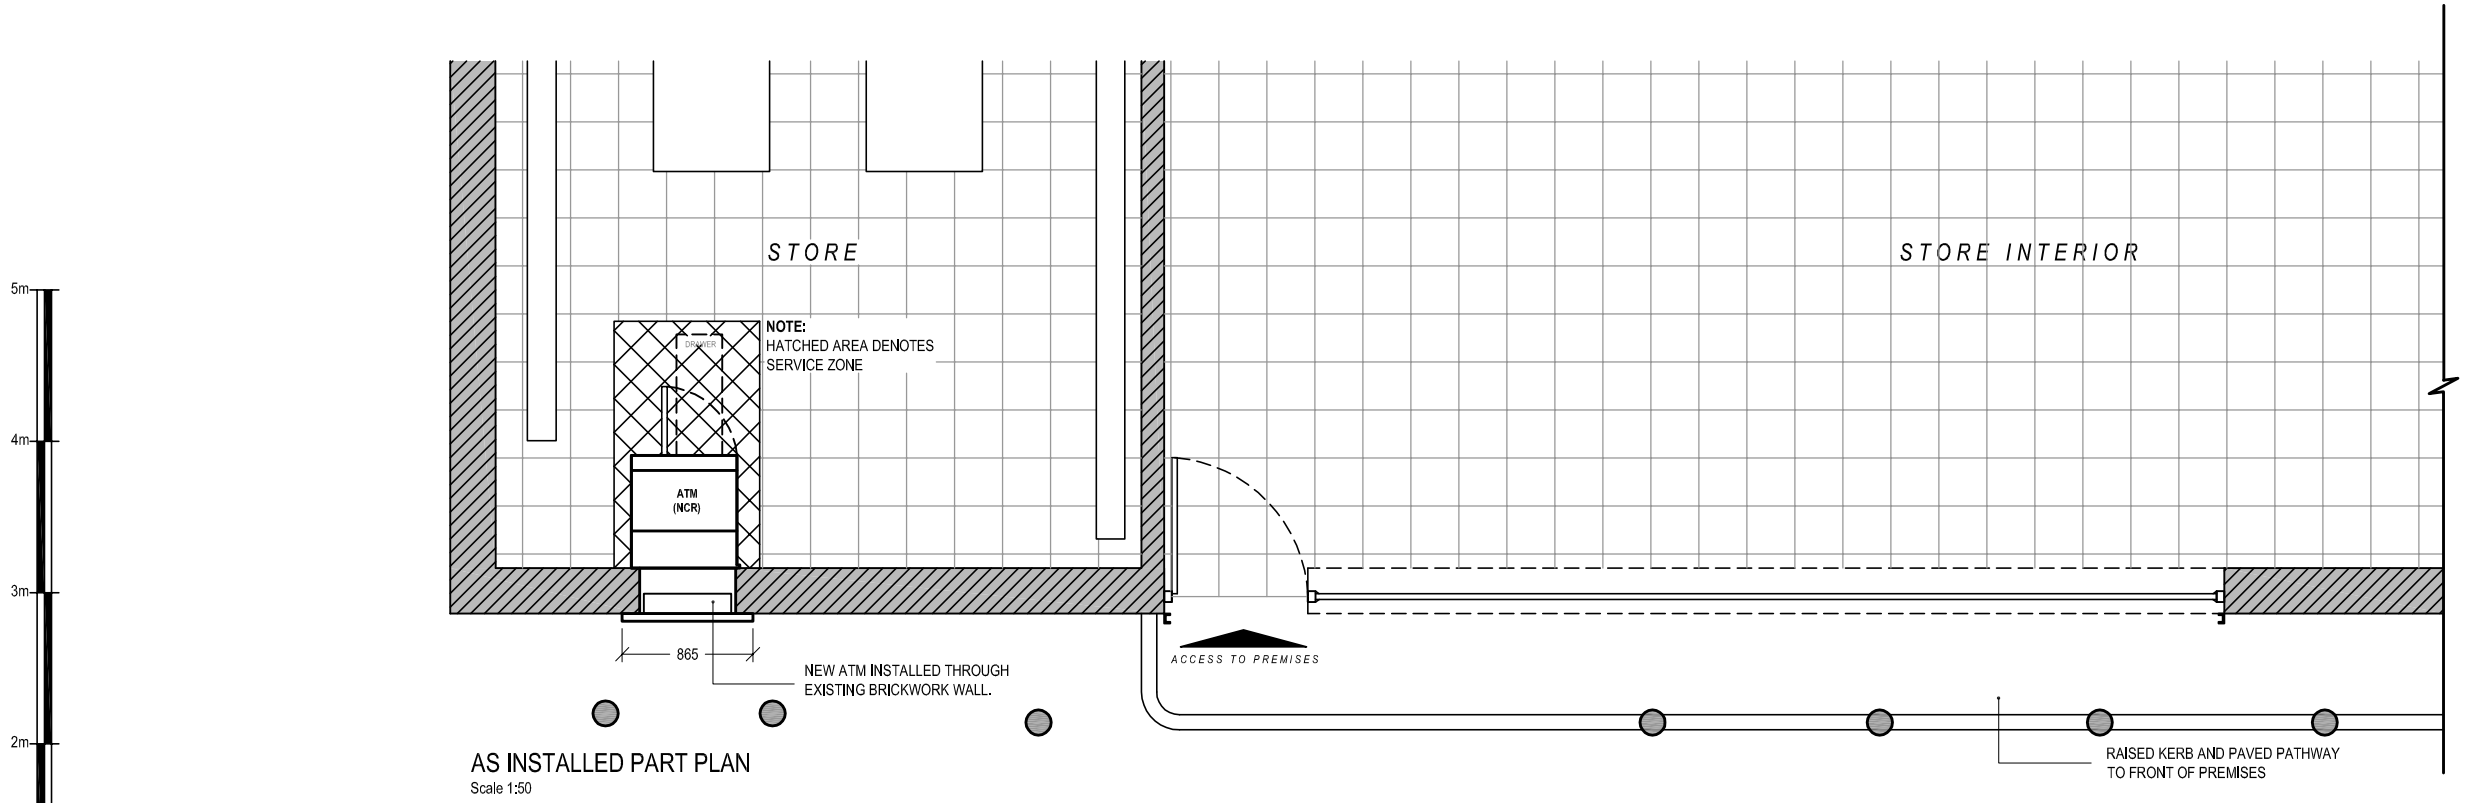

AS INSTALLED PART PLAN
Scale 1:50

Date:	Comments:	By:

GENERAL NOTES:

1) All dimensions in millimeters unless otherwise stated.

Site:
SHELL- OLDHAM ROAD

571 Oldham Road
Manchester
M40 5AF

Drawing Title:
As Installed Elevations and Plans

Ref:	Date:	Rev:
NM-06-2016-61-2	21-06-2016	
Scale:	**Paper:**	**Date Rev:**
1:50	A3	