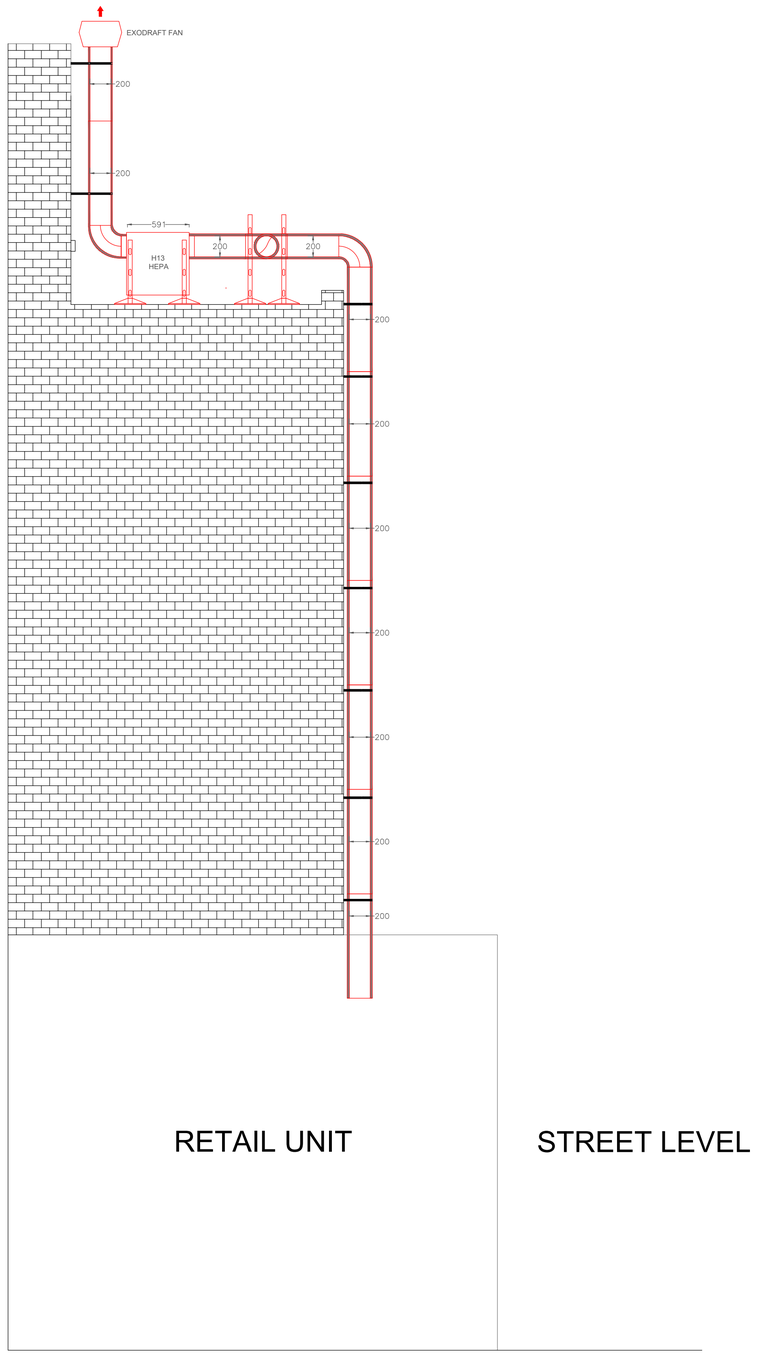


DO NOT SCALE

NOTES:

Rev	Date	Details Of Issue	Initials
1	29/01/16	HIGH LEVEL AIR CON DUCT REMOVED	MRC

Status

AS BUILT

CKDirect Ltd
Tel: 01733 302704
Email: info@ckdirect.co.uk Web: www.ckdirect.co.uk

This document and all information herein is confidential and the intellectual property of CK Direct. It is disclosed in confidence on terms that it will not be disclosed to any third party, used, sold, loaned, licensed, or reproduced in whole or in any part in any manner or form for manufacturing, tendering or for any other purpose without the written permission of CK Direct LTD. The copyright is retained by CK Direct LTD
© CK Direct Peterborough LTD

Client **INDIVIDUAL RESTAURANTS**

Project **PICCOLINO'S**
CLARENCE STREET MANCHESTER

Title **PIZZA TWIN WALL FLU ELEVATION**

Drawn	Date:	Scale (at A1)
MRC	**02/06/2016**	**1:40**

Drg no.	Revision No.
MNPIC-07	

A1