

Scale Bar 1:100 @ A2

© COPYRIGHT

The copyright in this drawing is vested in OBI Property LLP and no licence or assignment of any kind has been, or is, granted to any third party whether by provision of copies or originals of the drawings or otherwise unless otherwise agreed in writing.

DO NOT SCALE FROM THIS DRAWING

The contractor shall check and verify all dimensions on site and report any discrepancies in writing to OBI Property LLP before proceeding with work.


FOR ELECTRONIC DATA ISSUE

Electronic data / drawings are issued as "read only" and should not be interrogated for measurement. All dimensions and levels should be read, only from those values stated in text, on the drawing.

AREA MEASUREMENT

The areas are approximate and can only be verified by a detailed dimensional survey of the completed building. Any decisions to be made on the basis of these predictions, whether as to project viability, pre-letting, lease agreements or the like, should include due allowance for the increases and decreases inherent in the design development and building processes. Figures relate to the likely areas of the building at the current state of the design and using the Gross External Area (GEA) / Gross Internal Area (GIA) / Nett Internal Area (NIA) method of measurement from the Code of Measuring Practice, 5th Edition (RICS Code of Practice). All areas are subject to Town Planning and Conservation Area Consent, and detailed Rights to Light analysis.

NOTES:

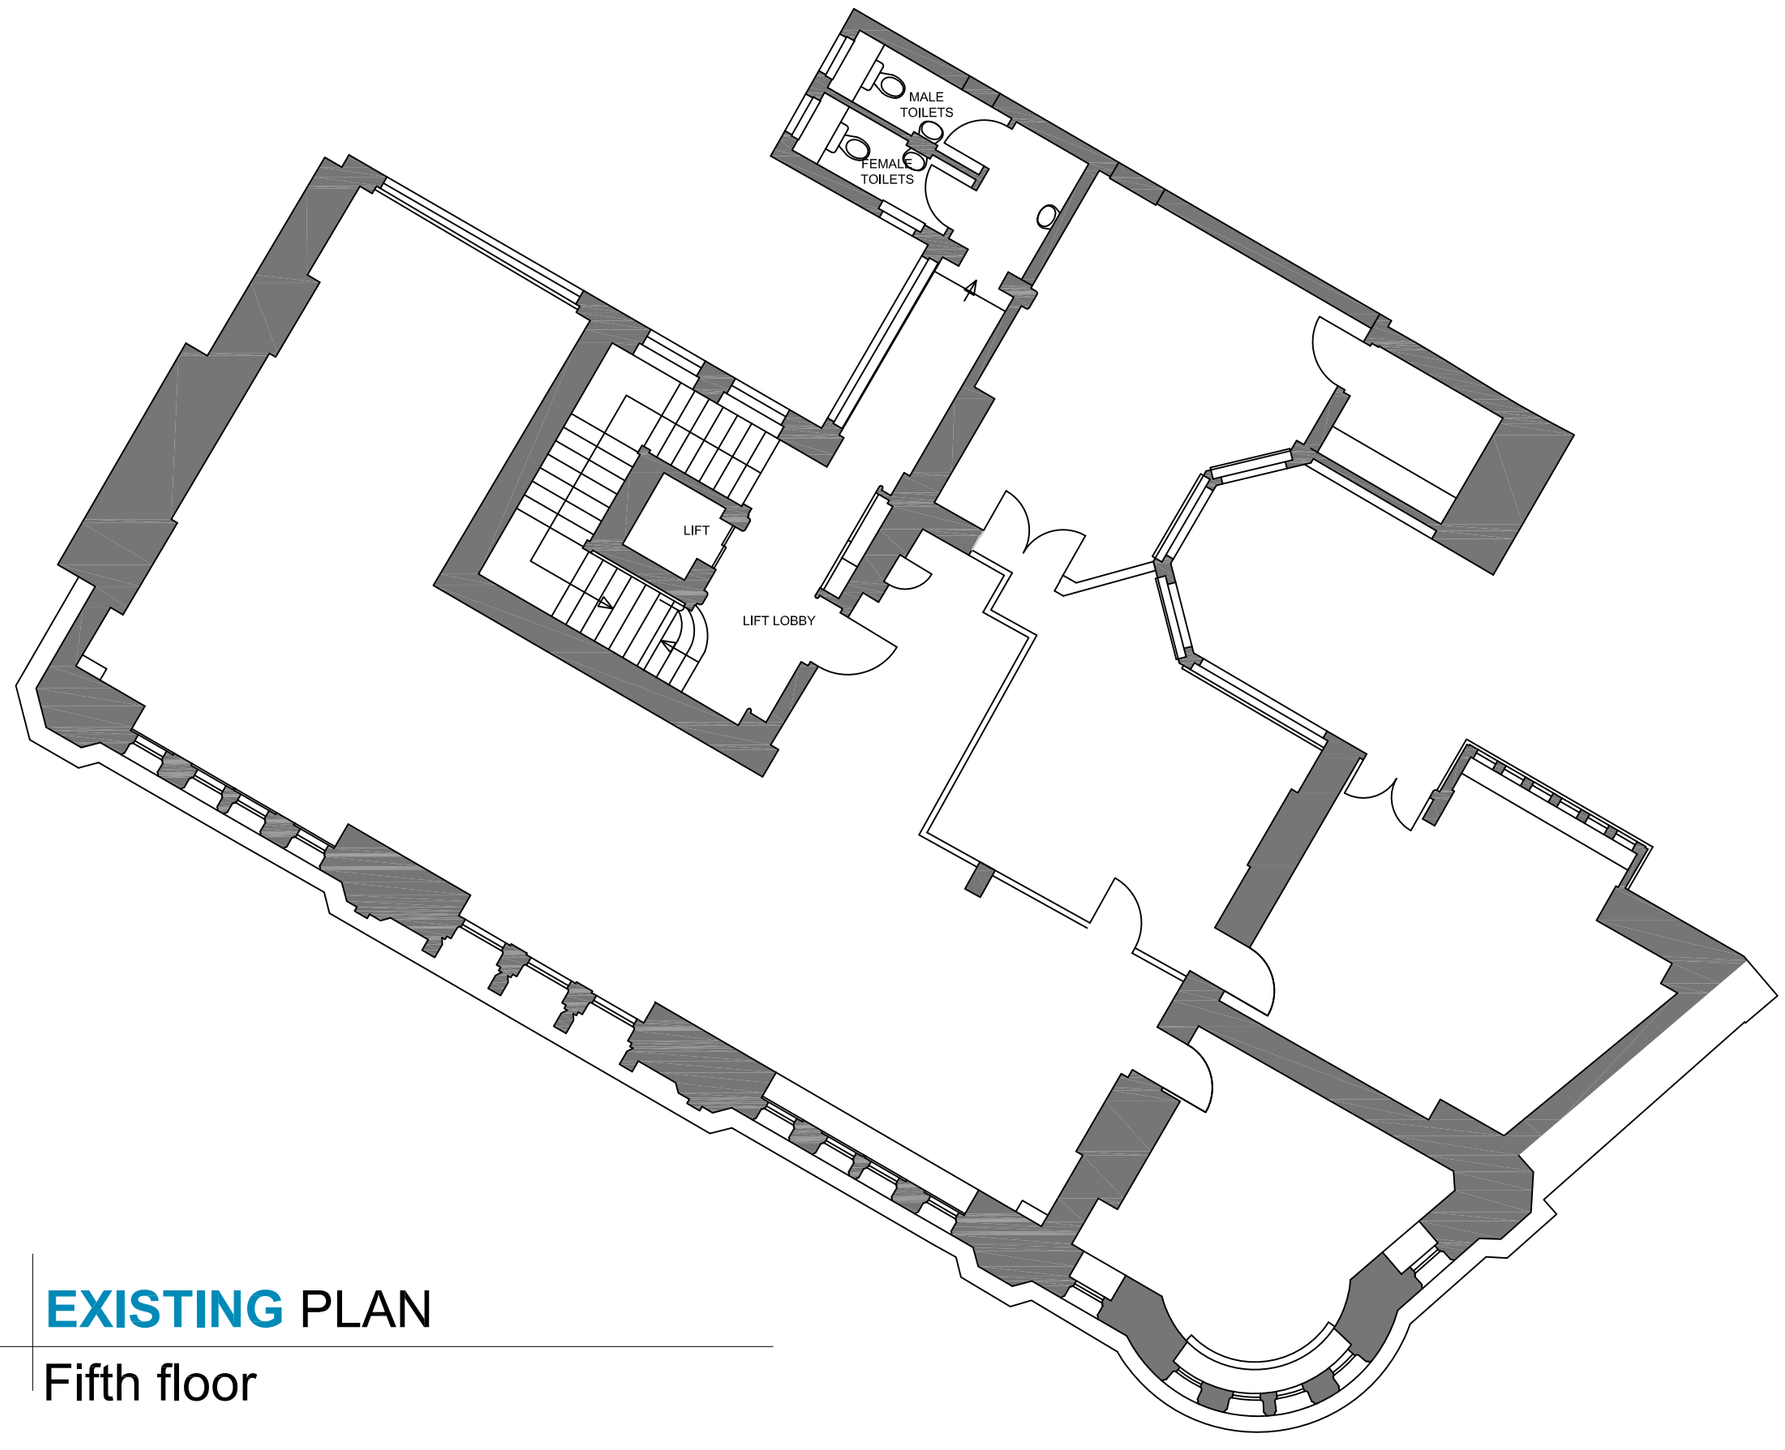

EXISTING PLAN

Fifth floor

drawing status

- approval
- construction
- preliminary
- record
- information
- comment
- TENDER

Client

LJ Partnership

Northern Assurance Building
5th Floor Plan


Drawing Title

Existing Plan


Job no	Date	Drn
OBI-10357-5.0	20.01.15	J C Scott
	Scale 1:100@A2	Rev A

OBI PROPERTY

80 Mosley Street . Manchester . M2 3FX . T: 0161 237 1717 . www.obiproperty.co.uk

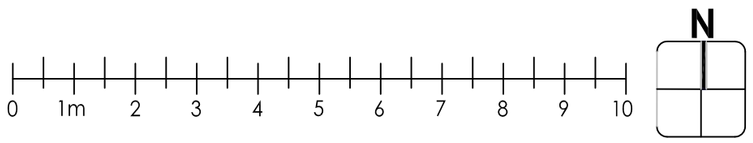

Scale Bar 1:100 @ A2

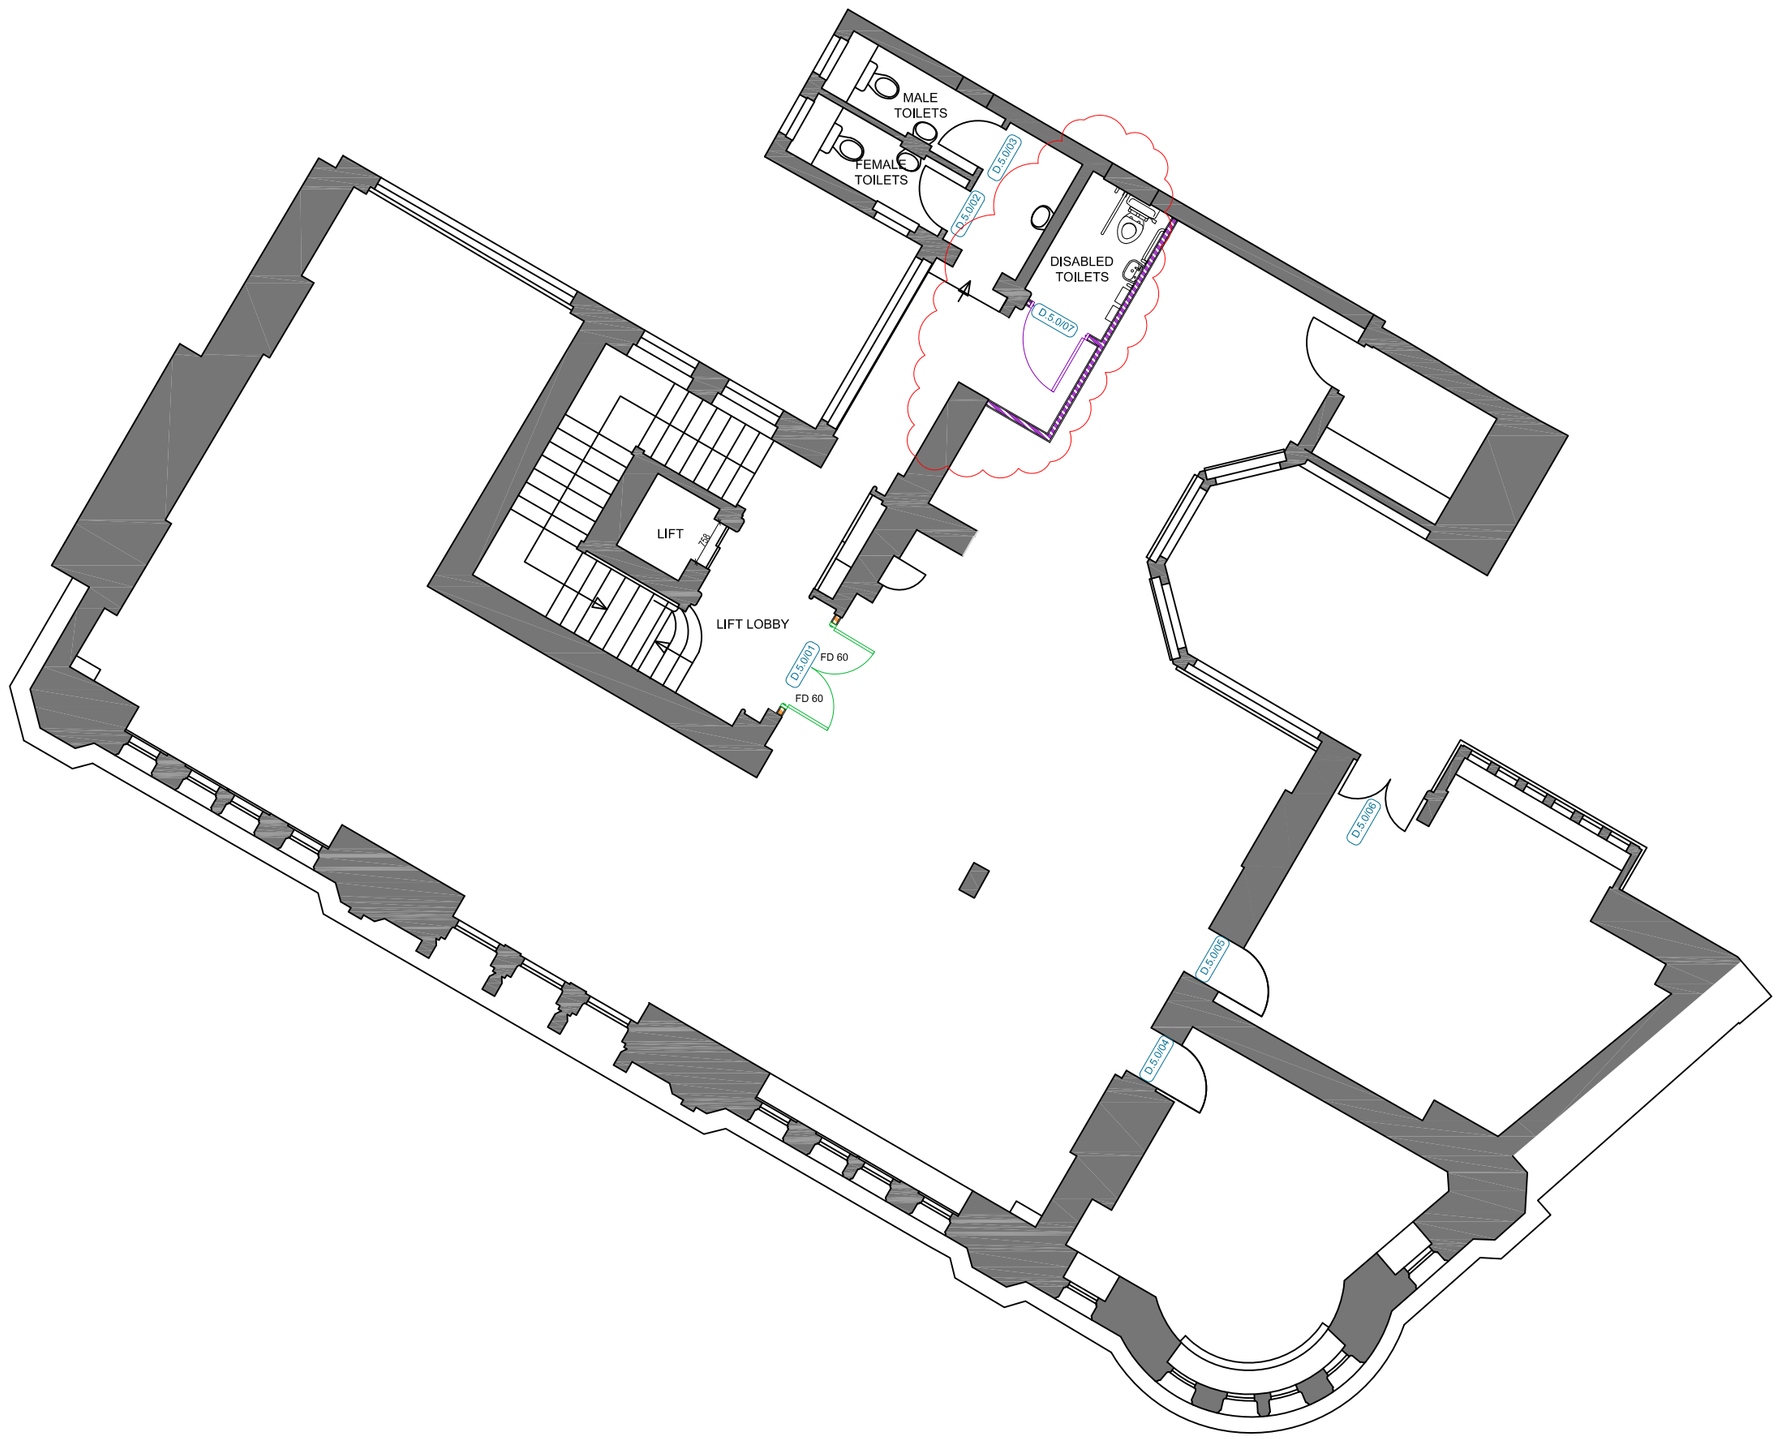

PROPOSED GENERAL ARRANGEMENT PLAN

Fifth floor

scale:-1:100

© COPYRIGHT

The copyright in this drawing is vested in OBI Property LLP and no licence or assignment of any kind has been, or is, granted to any third party whether by provision of copies or originals of the drawings or otherwise unless otherwise agreed in writing.

DO NOT SCALE FROM THIS DRAWING

The contractor shall check and verify all dimensions on site and report any discrepancies in writing to OBI Property LLP before proceeding with work.

FOR ELECTRONIC DATA ISSUE

Electronic data / drawings are issued as "read only" and should not be interrogated for measurement. All dimensions and levels should be read, only from those values stated in text, on the drawing.

AREA MEASUREMENT

The areas are approximate and can only be verified by a detailed dimensional survey of the completed building. Any decisions to be made on the basis of these predictions, whether as to project viability, pre-letting, lease agreements or the like, should include due allowance for the increases and decreases inherent in the design development and building processes. Figures relate to the likely areas of the building at the current state of the design and using the Gross External Area (GEA) / Gross Internal Area (GIA) / Nett Internal Area (NIA) method of measurement from the Code of Measuring Practice, 5th Edition (RICS Code of Practice). All areas are subject to Town Planning and Conservation Area Consent, and detailed Rights to Light analysis.

NOTES:

PARTITIONS/WALLS

Existing external walls

Existing interior wall/partition

Existing external windows

Proposed solid partition, Fire Rating 30mins

Proposed full height solid partition, Fire Rating 60mins

Proposed toilet partition

Proposed new 60min fire rated glass screen in a slim-line black steel frame, design tbc

General partitioning notes:

- All internal glazing to be 6.4mm laminated or 6mm toughened safety glass.

- All full height glass glazing to include a minimum of 2 levels of manifestation as per Doc M.

DOOR SETS

Existing single door

Proposed single solid timber door

Proposed double suite entrance door set.

General door notes:

- Fire doors to be fitted with automatic self closing device.
- All full height glass doors to include a minimum of 2 levels of manifestation as per Doc M.
- All timber doors to have 926mm door leaf and all glass doors to have 900mm door leaf to provide effective 825mm clear width unless otherwise stated.
- All timber doors to be of a contrasting colour to surrounding wall.

drawing status

- approval
- construction
- preliminary
- record
- information
- comment
- TENDER

For door details see door and ironmongery schedule.

Client

LJ Partnership

Northern Assurance Building
Fifth Floor Plan


Drawing Title

General Arrangement Plan

Job no	Date	Drn
OBI-10357-5.1	21.01.15	J C Scott
	Scale 1:100@A2	Rev A

OBI PROPERTY

80 Mosley Street . Manchester . M2 3FX . T: 0161 237 1717 . www.obiproperty.co.uk

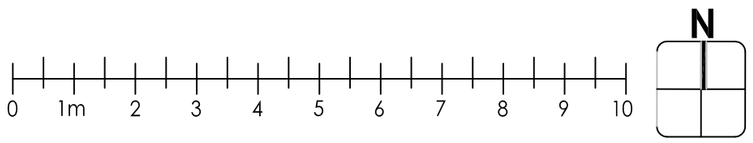

Scale Bar 1:100 @ A2



PROPOSED REFLECTIVE CEILING PLAN

Fifth floor scale:-1:100

© COPYRIGHT

The copyright in this drawing is vested in OBI Property LLP and no licence or assignment of any kind has been, or is, granted to any third party whether by provision of copies or originals of the drawings or otherwise unless otherwise agreed in writing.

DO NOT SCALE FROM THIS DRAWING

The contractor shall check and verify all dimensions on site and report any discrepancies in writing to OBI Property LLP before proceeding with work.

FOR ELECTRONIC DATA ISSUE

Electronic data / drawings are issued as "read only" and should not be interrogated for measurement. All dimensions and levels should be read, only from those values stated in text, on the drawing.

AREA MEASUREMENT

The areas are approximate and can only be verified by a detailed dimensional survey of the completed building. Any decisions to be made on the basis of these predictions, whether as to project viability, pre-letting, lease agreements or the like, should include due allowance for the increases and decreases inherent in the design development and building processes. Figures relate to the likely areas of the building at the current state of the design and using the Gross External Area (GEA) / Gross Internal Area (GIA) / Nett Internal Area (NIA) method of measurement from the Code of Measuring Practice, 5th Edition (RICS Code of Practice). All areas are subject to Town Planning and Conservation Area Consent, and detailed Rights to Light analysis.

NOTES:

LIGHTING DETAILS

Supplier: iGuzzini
Type: iRoll Ceiling Mounted Light
Size: Small
Colour: White

Supplier: Martin Huxford
Type: Matrix Chandelier
Finish: Brushed Brass

Supplier: Martin Huxford
Type: Matrix Wall Light
Finish: Brushed Brass

Supplier: iGuzzini
Type: System Easy MH Round
Size: dia 232x115
Colour: White

Supplier: iGuzzini
Type: iN 60 Pendant Light
Size: Varies
Colour: White

Supplier: JCC, www.jcc.co.uk
Type: Skytile Surface 6200
Size: 1500mm x 300mm

Supplier: Armstrong
Type: Metal Clip-In with acoustic fleece 2749MF
Size: 1500 x 300 mm
New bulkhead formed to house linear diffusers, lighting and ceiling tiles.

Note: Emergency lights to be added and designed by electrical contractor also electrical contractor to determine final wiring schematics.

Fire Alarm layout to be design by Electrical contractor.

Pendant light heights to be determined on site.

drawing status

- approval
- construction
- preliminary
- record
- information
- comment
- TENDER


Client
LJ Partnership
Northern Assurance Building
5th Floor Plan

Drawing Title
Proposed Reflective Ceiling Plan


Job no	Date	Dm
OBI-10357-5.2	21.01.15	J C Scott
	Scale 1:100@A2	Rev A

OBI PROPERTY

80 Mosley Street . Manchester . M2 3FX . T: 0161 237 1717 . www.obiproperty.co.uk

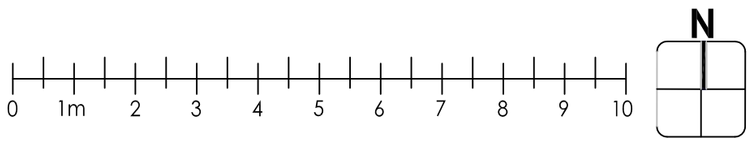

Scale Bar 1:100 @ A2

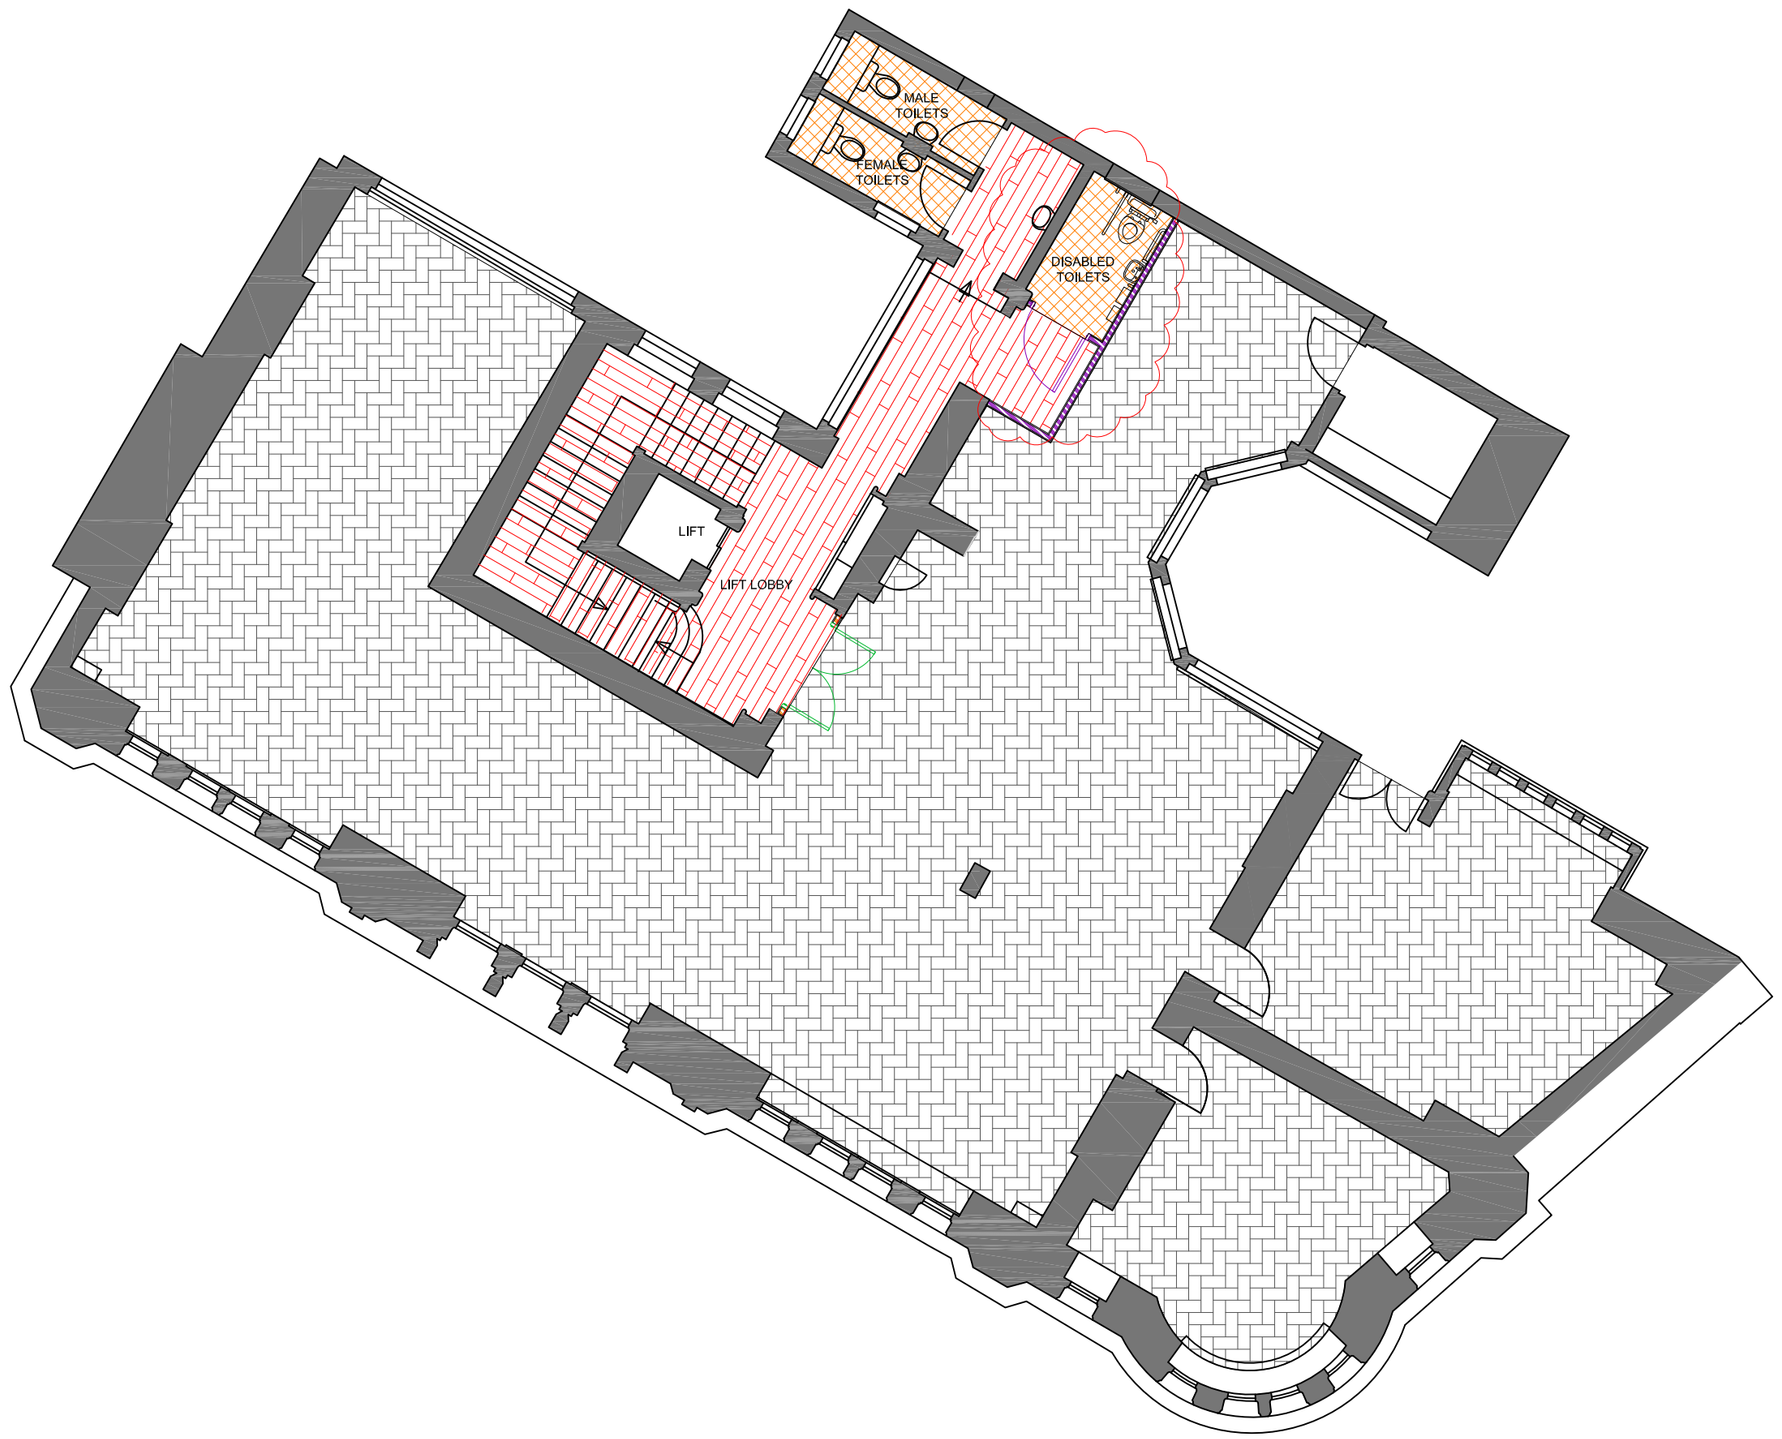

PROPOSED FLOOR FINISHES PLAN

Fifth floor scale:-1:100

© COPYRIGHT

The copyright in this drawing is vested in OBI Property LLP and no licence or assignment of any kind has been, or is, granted to any third party whether by provision of copies or originals of the drawings or otherwise unless otherwise agreed in writing.

DO NOT SCALE FROM THIS DRAWING

The contractor shall check and verify all dimensions on site and report any discrepancies in writing to OBI Property LLP before proceeding with work.

FOR ELECTRONIC DATA ISSUE

Electronic data / drawings are issued as "read only" and should not be interrogated for measurement. All dimensions and levels should be read, only from those values stated in text, on the drawing.


AREA MEASUREMENT

The areas are approximate and can only be verified by a detailed dimensional survey of the completed building. Any decisions to be made on the basis of these predictions, whether as to project viability, pre-letting, lease agreements or the like, should include due allowance for the increases and decreases inherent in the design development and building processes. Figures relate to the likely areas of the building at the current state of the design and using the Gross External Area (GEA) / Gross Internal Area (GIA) / Nett Internal Area (NIA) method of measurement from the Code of Measuring Practice, 5th Edition (RICS Code of Practice). All areas are subject to Town Planning and Conservation Area Consent, and detailed Rights to Light analysis.


NOTES:

FLOOR FINISHES

Supplier:www.jordanandrews.com
Range: ISTORIA PREMIUM
Type: Herringbone Parquet UV Oiled
Size: 21mm x 170mm x 490mm
Grade: Prime Grade
Colour: Black Rock

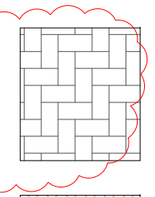

Supplier: Caesars Ceramics
Range: Series Europa
(mat glazed porcelain)
Colour: Grey
Size: 630x310mm

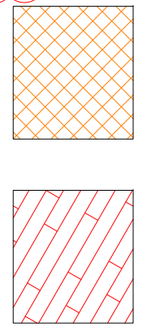

Supplier:www.jordanandrews.com
Range: ISTORIA PREMIUM
Type: Oak 1 strip engineered UV Oiled
Size: 21mm x 180mm x 1900mm
Grade: Prime Grade
Colour: Black Rock

notes:

Stair tread to have bullnose nosing in the same range of flooring.

Toilets to have tiles upstand to match floor tiles.

drawing status

- approval
- construction
- preliminary
- record
- information
- comment
- TENDER


Client
LJ Partnership
Northern Assurance Building
Fifth Floor Plan

Drawing Title
Proposed Floor Finishes Plan


Job no	Date	Drn
OBI-10357-5.3	21.01.15	J C Scott
	Scale 1:100@A2	Rev A

OBI PROPERTY

80 Mosley Street . Manchester . M2 3FX . T: 0161 237 1717 . www.obiproperty.co.uk

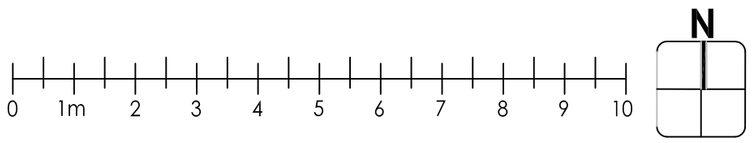

Scale Bar 1:100 @ A2

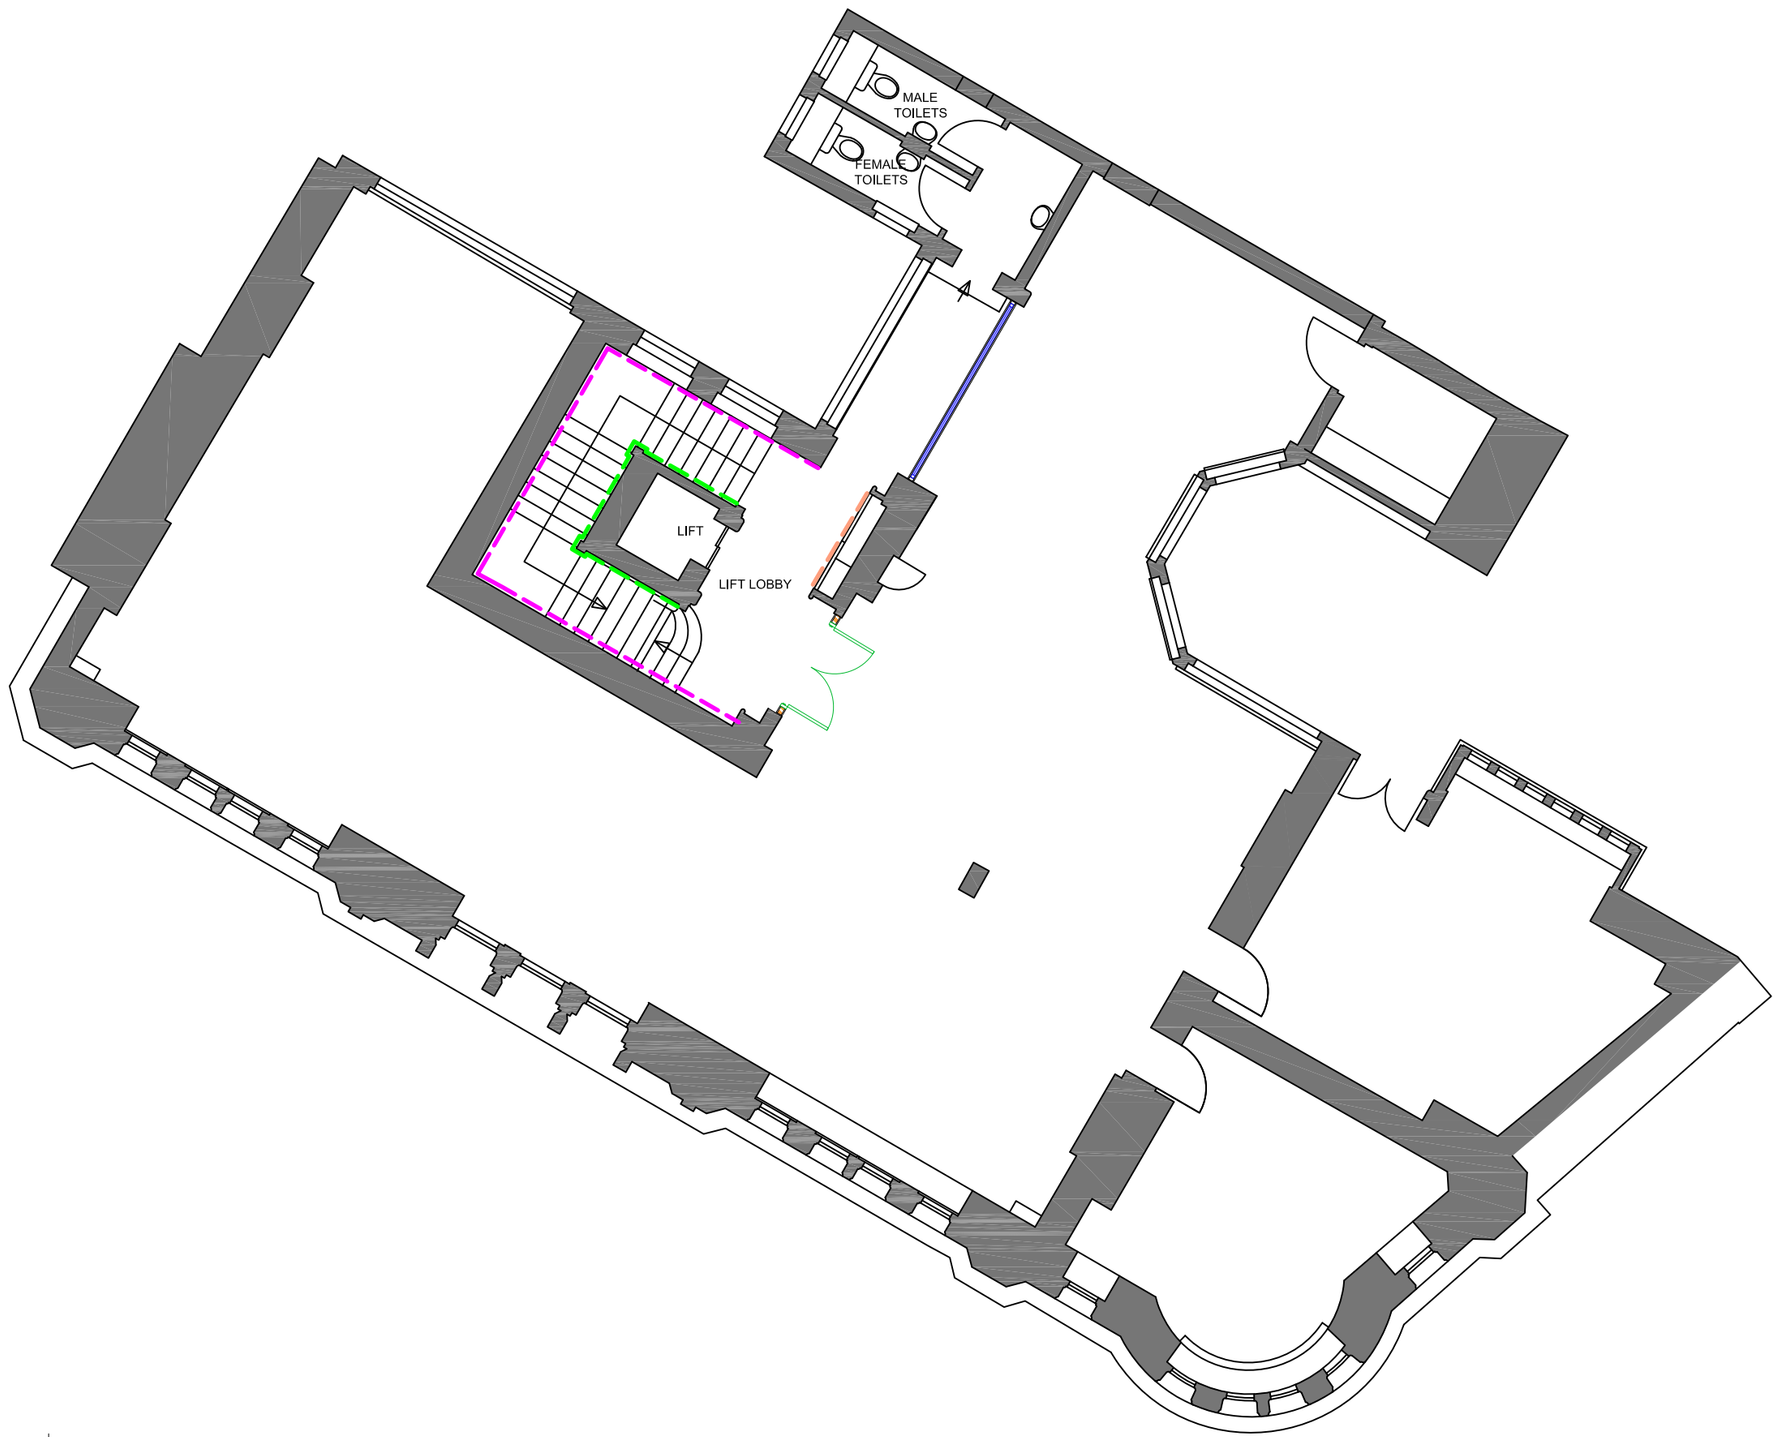

PROPOSED WALL FINISHES PLAN

Fifth floor scale:-1:100

© COPYRIGHT

The copyright in this drawing is vested in OBI Property LLP and no licence or assignment of any kind has been, or is, granted to any third party whether by provision of copies or originals of the drawings or otherwise unless otherwise agreed in writing.

DO NOT SCALE FROM THIS DRAWING

The contractor shall check and verify all dimensions on site and report any discrepancies in writing to OBI Property LLP before proceeding with work.

FOR ELECTRONIC DATA ISSUE

Electronic data / drawings are issued as "read only" and should not be interrogated for measurement. All dimensions and levels should be read, only from those values stated in text, on the drawing.

AREA MEASUREMENT

The areas are approximate and can only be verified by a detailed dimensional survey of the completed building. Any decisions to be made on the basis of these predictions, whether as to project viability, pre-letting, lease agreements or the like, should include due allowance for the increases and decreases inherent in the design development and building processes. Figures relate to the likely areas of the building at the current state of the design and using the Gross External Area (GEA) / Gross Internal Area (GIA) / Nett Internal Area (NIA) method of measurement from the Code of Measuring Practice, 5th Edition (RICS Code of Practice). All areas are subject to Town Planning and Conservation Area Consent, and detailed Rights to Light analysis.

NOTES:

WALL FINISHES

Supplier: Farrow & Ball
Finish: Modern Emulsion (7% sheen)
Colour: Wevet 273

Supplier: Farrow & Ball
Finish: Estate Eggshell (20% sheen)
Colour: Pavillion Grey 242

Supplier: TBC
Finish: Modern Emulsion
Colour: White

General door notes:

Wall to be painted from floor to ceiling unless otherwise stated..

drawing status

- approval
- construction
- preliminary
- record
- information
- comment
- TENDER

Client

LJ Partnership

Northern Assurance Building
Fifth Floor Plan


Drawing Title

Wall Finishes Plan


Job no	Date	Drn
OBI-10357-5.4	Oct 2015	J C Scott
	Scale 1:100@A2	Rev

OBI PROPERTY

80 Mosley Street . Manchester . M2 3FX . T: 0161 237 1717 . www.obiproperty.co.uk

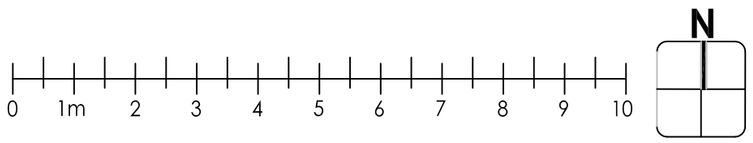

Scale Bar 1:100 @ A2

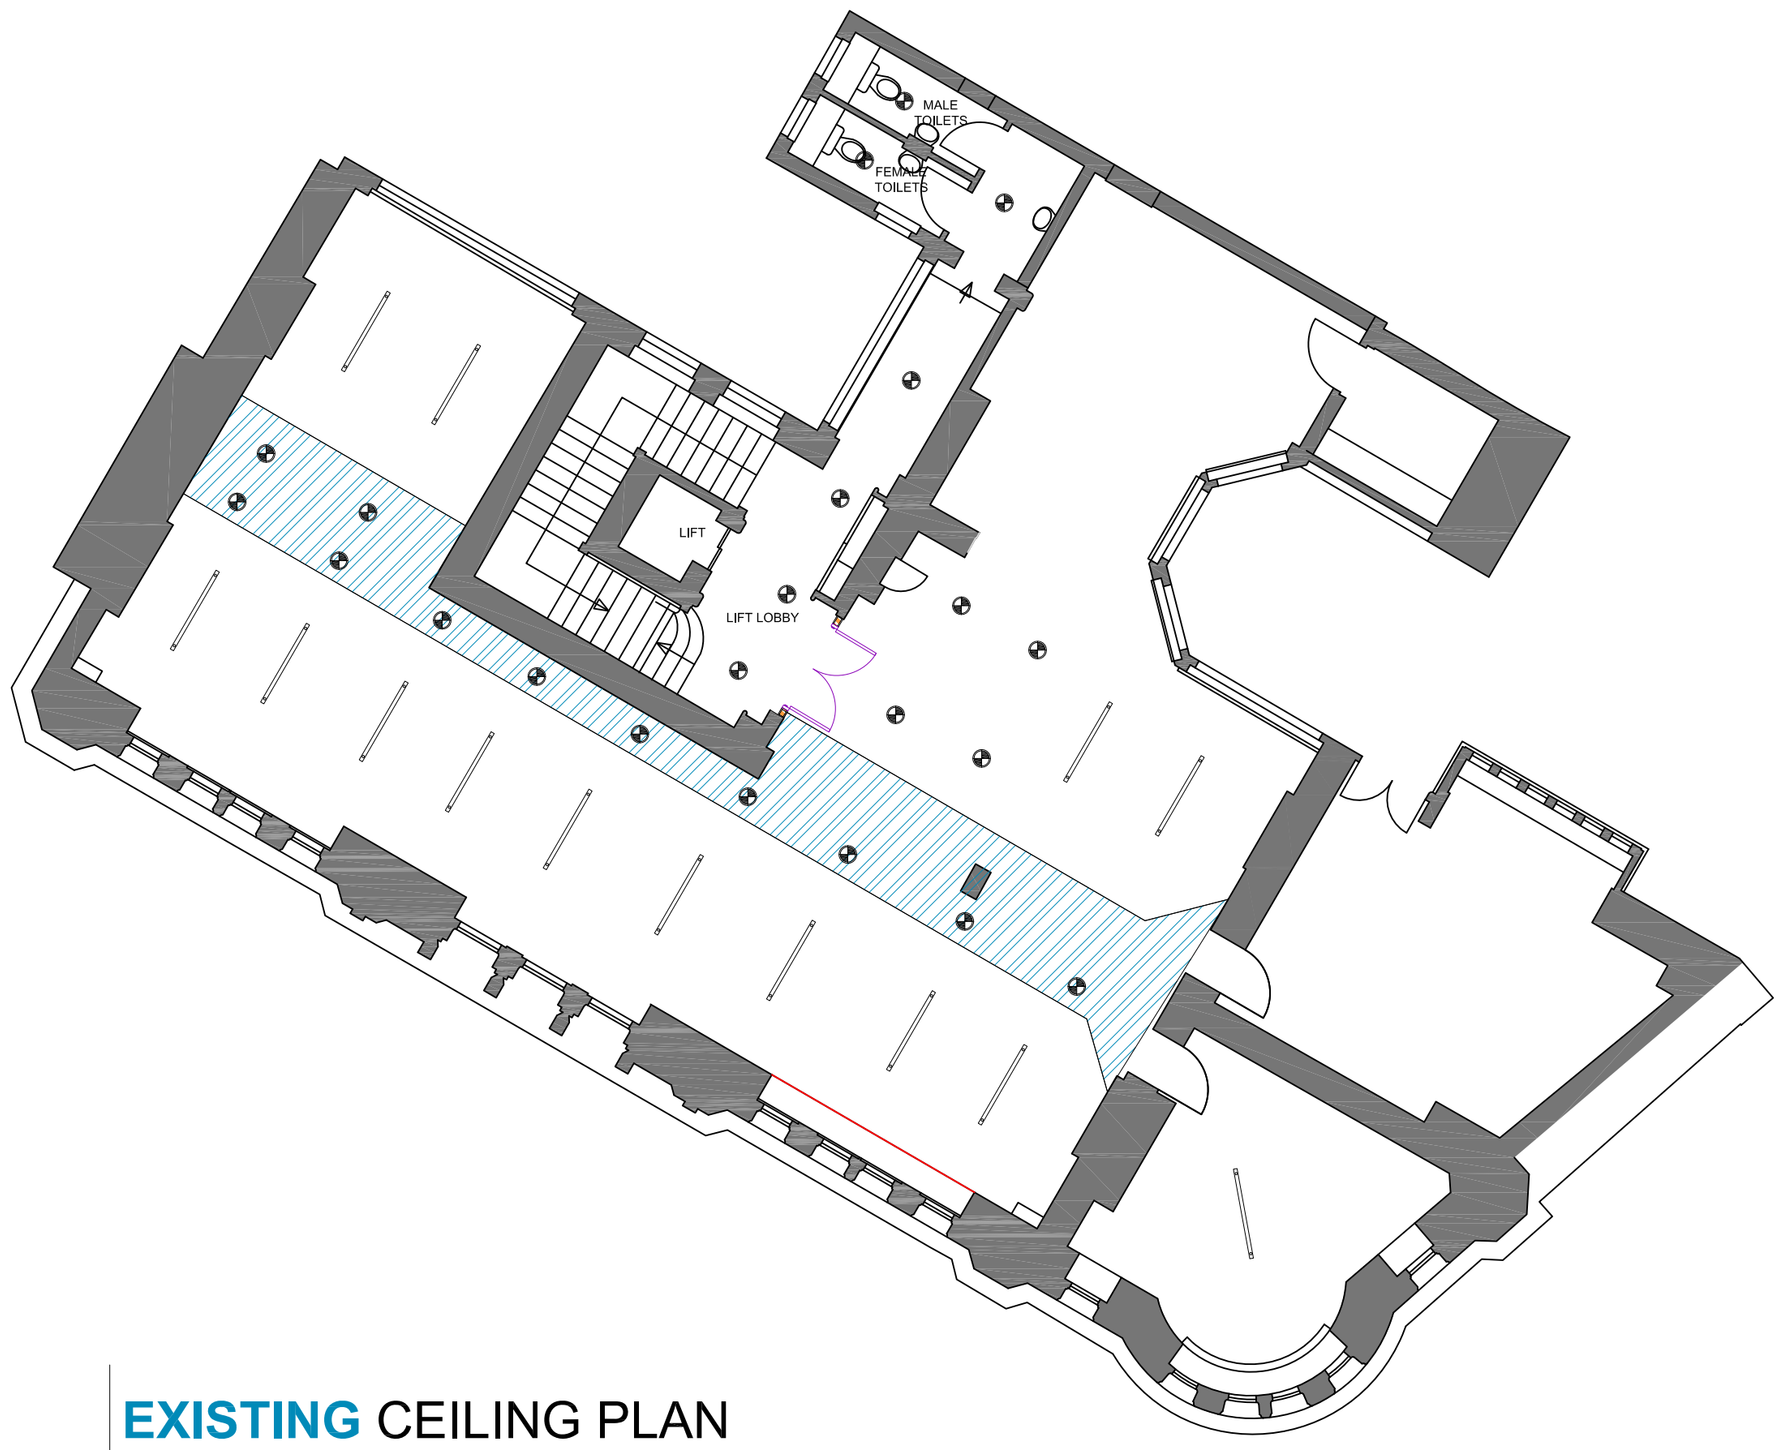

EXISTING CEILING PLAN

Fifth floor

© COPYRIGHT

The copyright in this drawing is vested in OBI Property LLP and no licence or assignment of any kind has been, or is, granted to any third party whether by provision of copies or originals of the drawings or otherwise unless otherwise agreed in writing.

DO NOT SCALE FROM THIS DRAWING

The contractor shall check and verify all dimensions on site and report any discrepancies in writing to OBI Property LLP before proceeding with work.

FOR ELECTRONIC DATA ISSUE

Electronic data / drawings are issued as "read only" and should not be interrogated for measurement. All dimensions and levels should be read, only from those values stated in text, on the drawing.

AREA MEASUREMENT

The areas are approximate and can only be verified by a detailed dimensional survey of the completed building. Any decisions to be made on the basis of these predictions, whether as to project viability, pre-letting, lease agreements or the like, should include due allowance for the increases and decreases inherent in the design development and building processes. Figures relate to the likely areas of the building at the current state of the design and using the Gross External Area (GEA) / Gross Internal Area (GIA) / Nett Internal Area (NIA) method of measurement from the Code of Measuring Practice, 5th Edition (RICS Code of Practice). All areas are subject to Town Planning and Conservation Area Consent, and detailed Rights to Light analysis.

NOTES:

LIGHTING DETAILS

Existing flush ceiling light

Existing suspended light

Existing low level MF ceiling

Existing original ceiling

Note:

drawing status

- approval
- construction
- preliminary
- record
- information
- comment
- TENDER

Client

LJ Partnership

Northern Assurance Building
5th Floor Plan


Drawing Title

Existing Ceiling Plan


Job no	Date	Drn
OBI-10357-5.5	Oct 2015	J C Scott
	Scale 1:100@A2	Rev

OBI PROPERTY

80 Mosley Street . Manchester . M2 3FX . T: 0161 237 1717 . www.obiproperty.co.uk

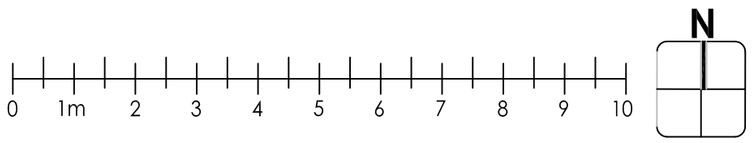

Scale Bar 1:100 @ A2

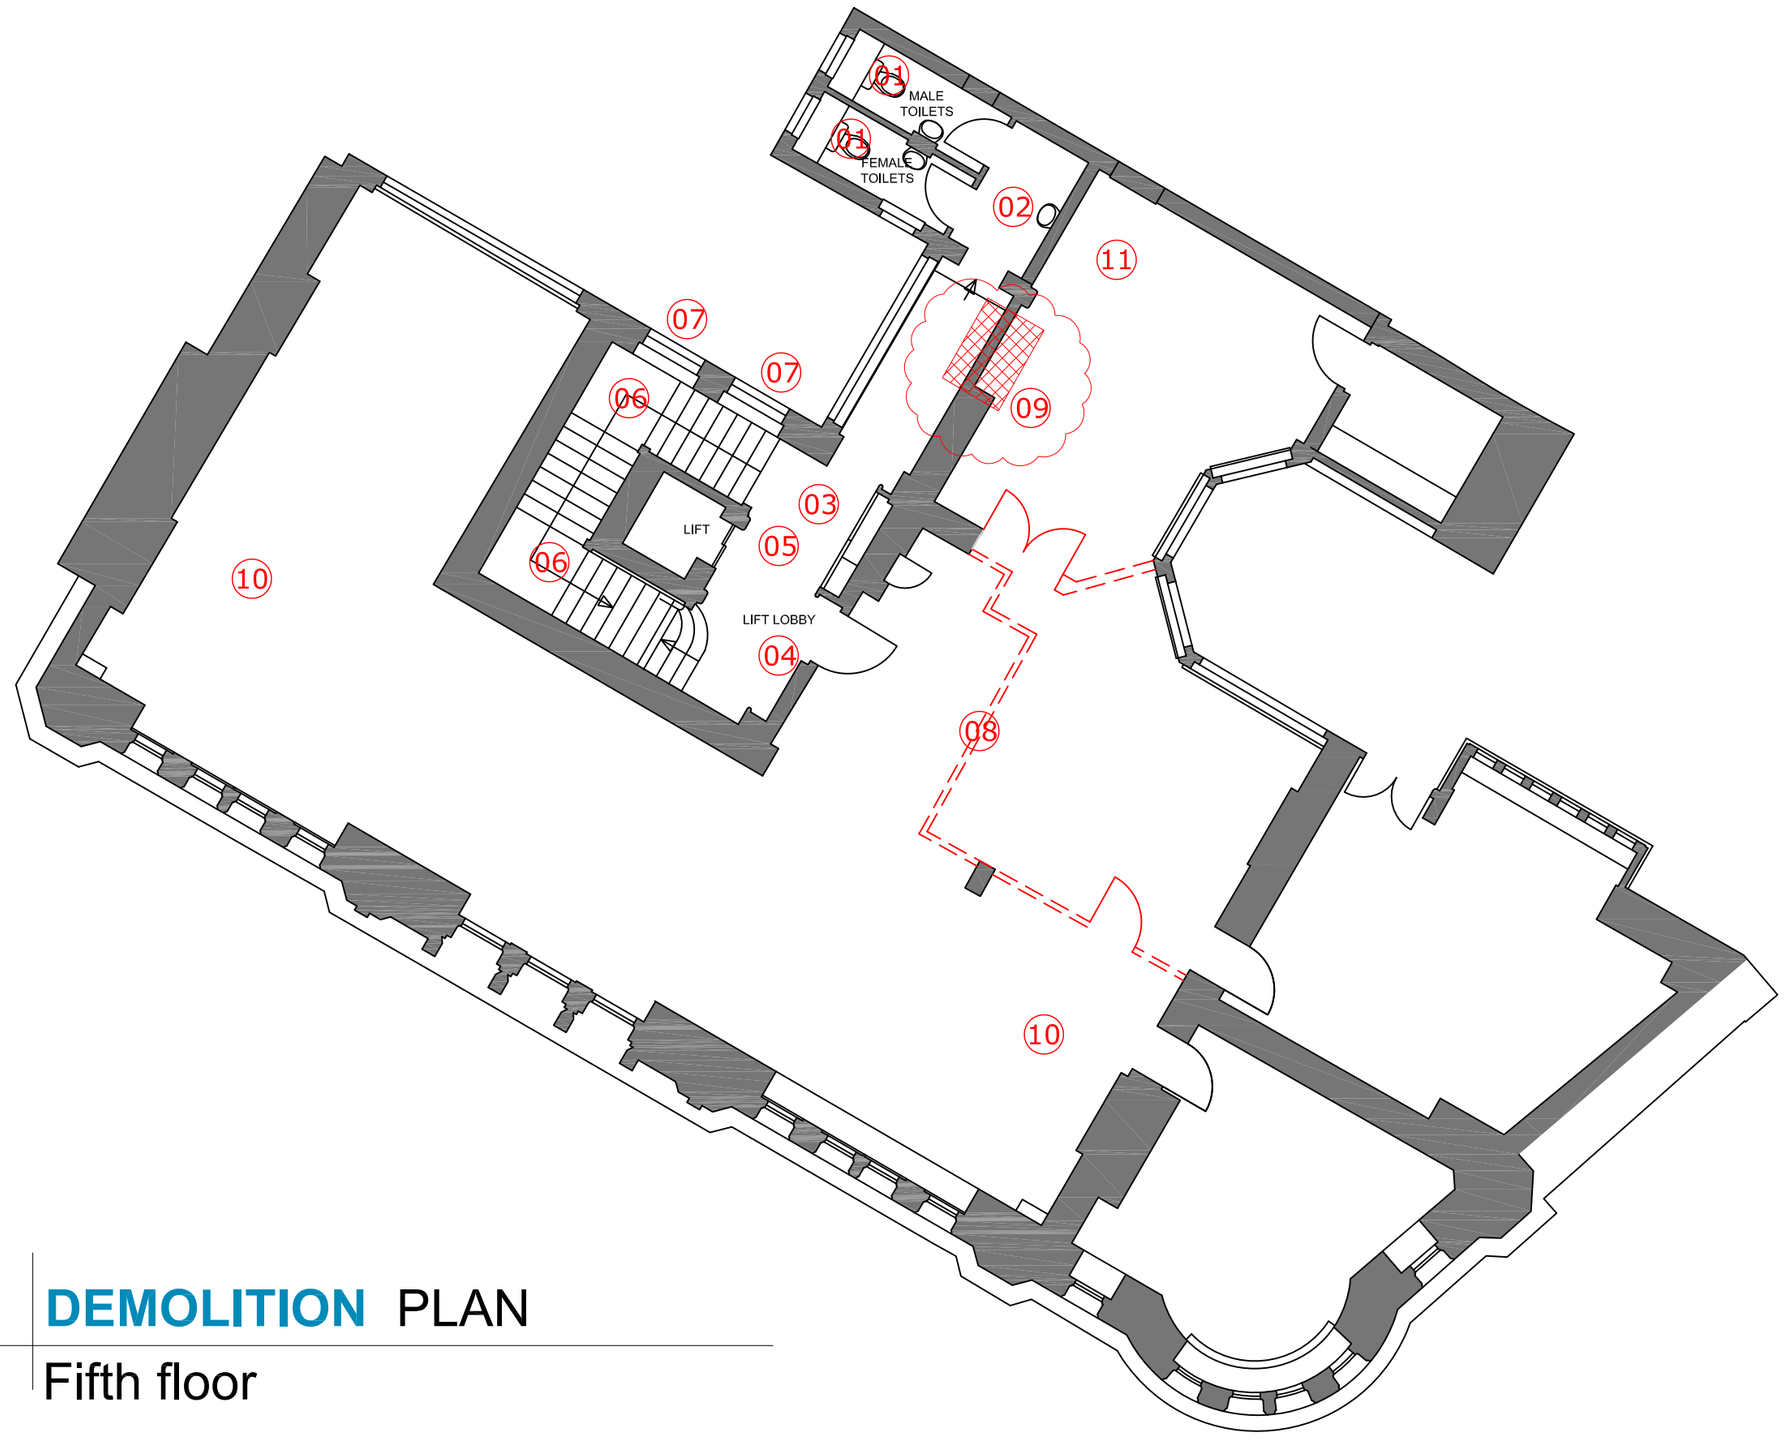

DEMOLITION PLAN

Fifth floor

© COPYRIGHT

The copyright in this drawing is vested in OBI Property LLP and no licence or assignment of any kind has been, or is, granted to any third party whether by provision of copies or originals of the drawings or otherwise unless otherwise agreed in writing.

DO NOT SCALE FROM THIS DRAWING

The contractor shall check and verify all dimensions on site and report any discrepancies in writing to OBI Property LLP before proceeding with work.

FOR ELECTRONIC DATA ISSUE

Electronic data / drawings are issued as "read only" and should not be interrogated for measurement. All dimensions and levels should be read, only from those values stated in text, on the drawing.

AREA MEASUREMENT

The areas are approximate and can only be verified by a detailed dimensional survey of the completed building. Any decisions to be made on the basis of these predictions, whether as to project viability, pre-letting, lease agreements or the like, should include due allowance for the increases and decreases inherent in the design development and building processes. Figures relate to the likely areas of the building at the current state of the design and using the Gross External Area (GEA) / Gross Internal Area (GIA) / Nett Internal Area (NIA) method of measurement from the Code of Measuring Practice, 5th Edition (RICS Code of Practice). All areas are subject to Town Planning and Conservation Area Consent, and detailed Rights to Light analysis.

NOTES:

STRIP OUT NOTES

> 01 Strip out existing non-original toilets and install new.

> 02 Existing non-original sink striped out.

> 03 Existing non-original flooring removed and new flooring laid.

> 04 Existing non-original suite entrance removed and new entrance formed.

> 05 Remove existing non-original light fittings and replace with lighting scheme.

> 06 Existing non-original stair tread to be replaced with new timber treads.

> 07 Remove existing frosted glass and replace with new clear glass, subject to conservation officer approval.

> 08 All existing partitions and doors to be removed as shown in red dotted line.

> 09 Remove existing wall to form new lobby for disabled toilet.

> 10 Strip out existing mf ceiling and create new as per proposed ceiling layout.

GENERAL:
All existing light fittings to be striped out and replaced with a new lighting scheme.

drawing status

- approval
- construction
- preliminary
- record
- information
- comment
- TENDER

Client

LJ Partnership

Northern Assurance Building
5th Floor Plan

Drawing Title

Demolition Plan

Job no	Date	Drn
OBI-10357-5.0	20.01.15	J C Scott
	Scale 1:100@A2	Rev A

OBI PROPERTY

80 Mosley Street . Manchester . M2 3FX . T: 0161 237 1717 . www.obiproperty.co.uk