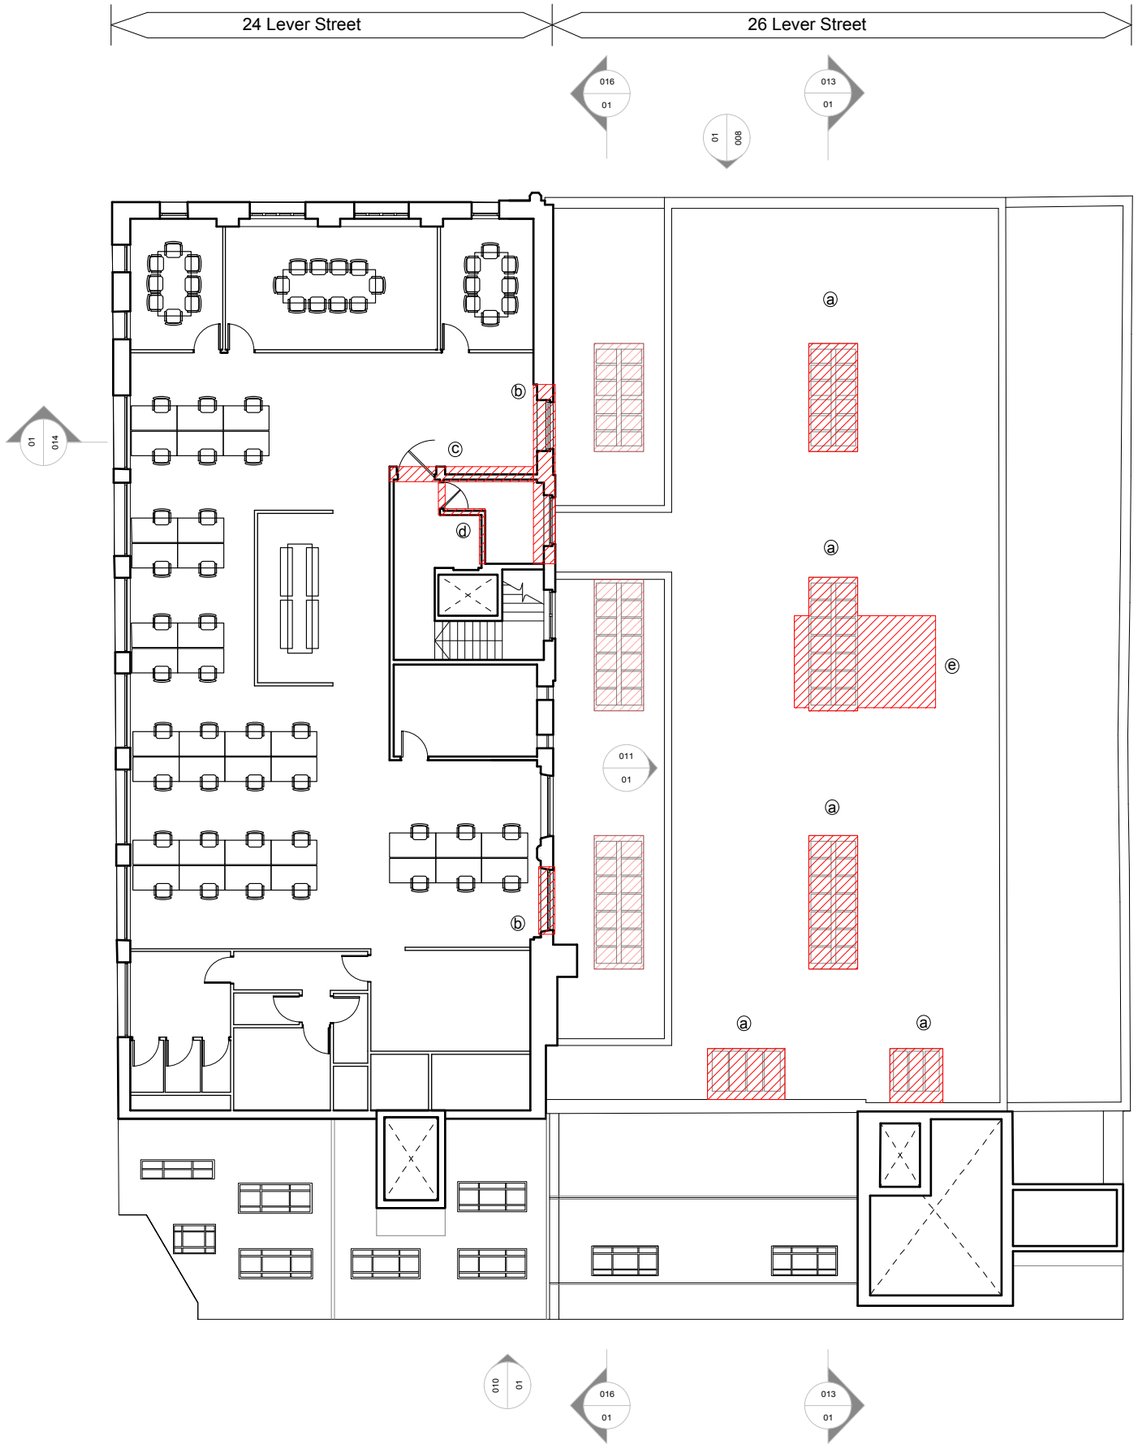


1 Modifications to Fourth Floor Plan
1:200

0 5 10 M

N

Copyright Hawkins Brown Architects LLP

No implied license exists. This drawing should not be used to calculate areas for the purposes of valuation. Do not scale this drawing. All dimensions to be checked on site by the contractor and such dimensions to be their responsibility. All work must comply with relevant British Standards and Building Regulations requirements. Drawing errors and omissions to be reported to the architect.

Revisions

KEY

ⓐ - Roof Lights to be removed

ⓑ - Areas of wall carefully removed, working where possible with existing window aperture and lowering to form the connection between 24 and 26 Lever Street

ⓒ - Internal partions to be removed

ⓓ - Historic partions removed to be relocated

ⓔ - Area of roof removed to create connection to third floor

Note: This drawing does not represent as-built information and is based on historic survey information supplied by others, the accuracy of which cannot be guaranteed by Hawkins\Brown. 24 Lever Street is a listed building and particular care and attention should be paid to the above in the design and execution of any building works.

Hawkins\Brown

3C Tariff Street
Manchester
M1 2FF
0161 641 5522

mail@
hawkinsbrown.co.uk
www.
hawkinsbrown.co.uk

Project
The Rooftop at 26 Lever Street

Drawing
Modifications to Fourth Floor Plan

Scale	Date
1:200	April 2016
Drawn by	Checked by
KMR	KT
Job Number	Status
HB1618	Planning

Drawing No. & Revision
1618_DWG_PL_006