



AS INSTALLED FRONT ELEVATION

Scale 1:50

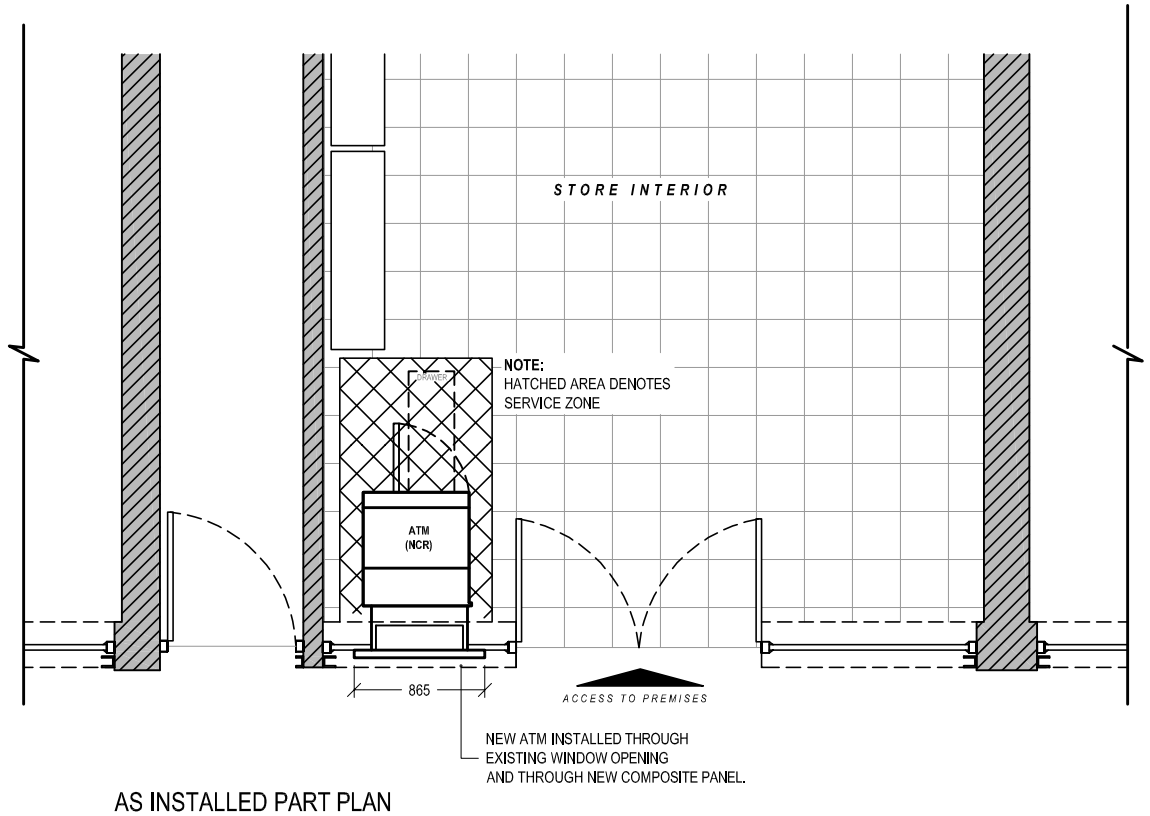

AS INSTALLED PART PLAN

Scale 1:50

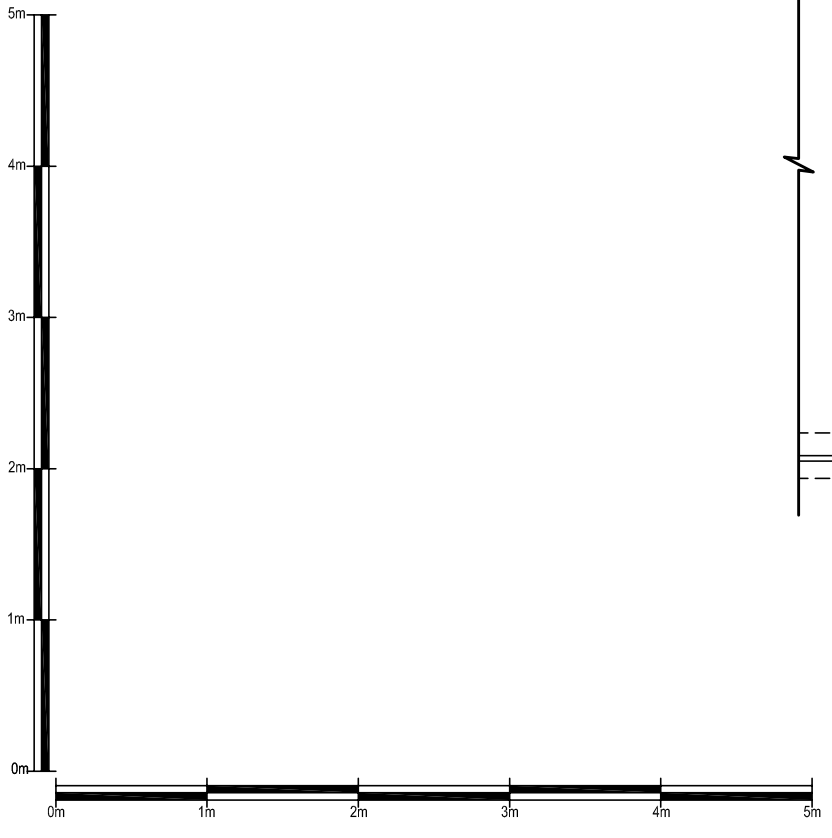

NOTE MACHINE

Date:	Comments:	By:

GENERAL NOTES:

1) All dimensions in millimeters unless otherwise stated.

Site:
SINGH & SONS

99 Princess Road
Manchester
M14 4TH

Drawing Title:

As Installed Elevations and Plans

Ref:	Date:	Rev:
NM-10-2015-102-2	31-10-2015	
Scale: 1:50	**Paper:** A3	**Date Rev:**