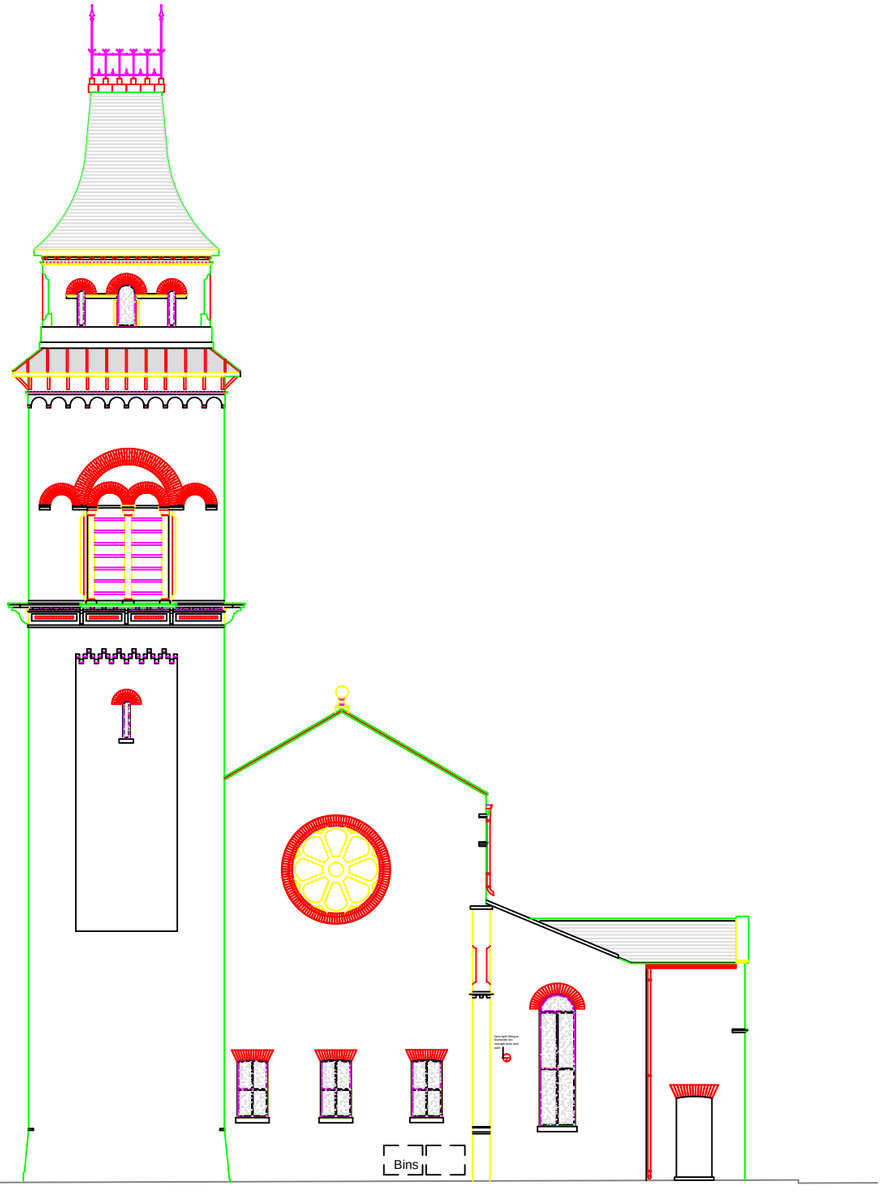

West Elevation

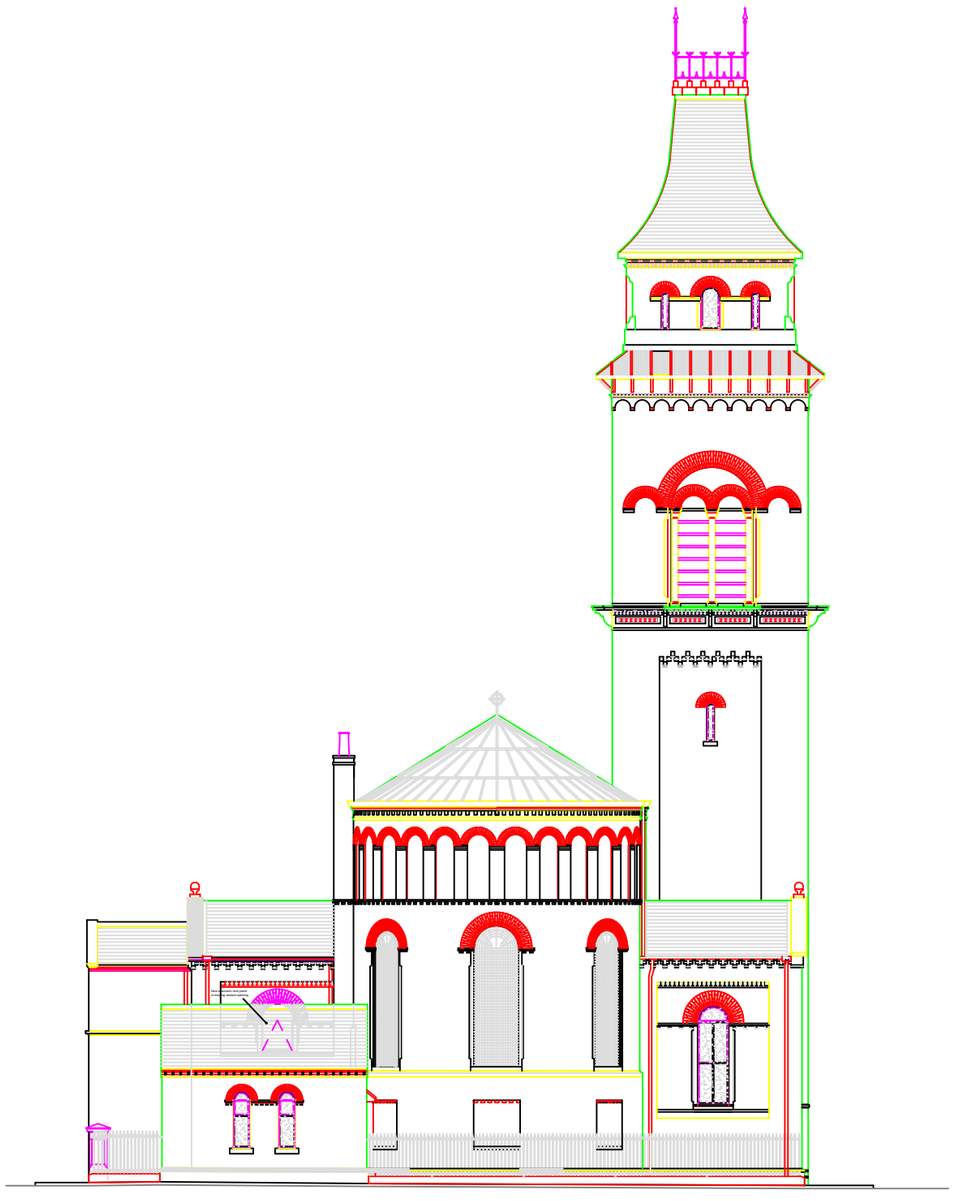

East Elevation

For identification purposes only. All dimensions to be checked on site and used in preference to those given or scaled from the drawing, and must be brought to the attention of the Surveyor.

Notes

Date	Revision

Drawing No. C-0181312/AB003 Revision

Address.
ST PETERS CHURCH
ANCOATS
MANCHESTER

Title.
EAST AND WEST ELEVATIONS
AS BUILT

Client
HALLE

Date	Drawn by	Scale A3 @
25/02/13	JD	DNS
	File No.	

Copyright Reserved