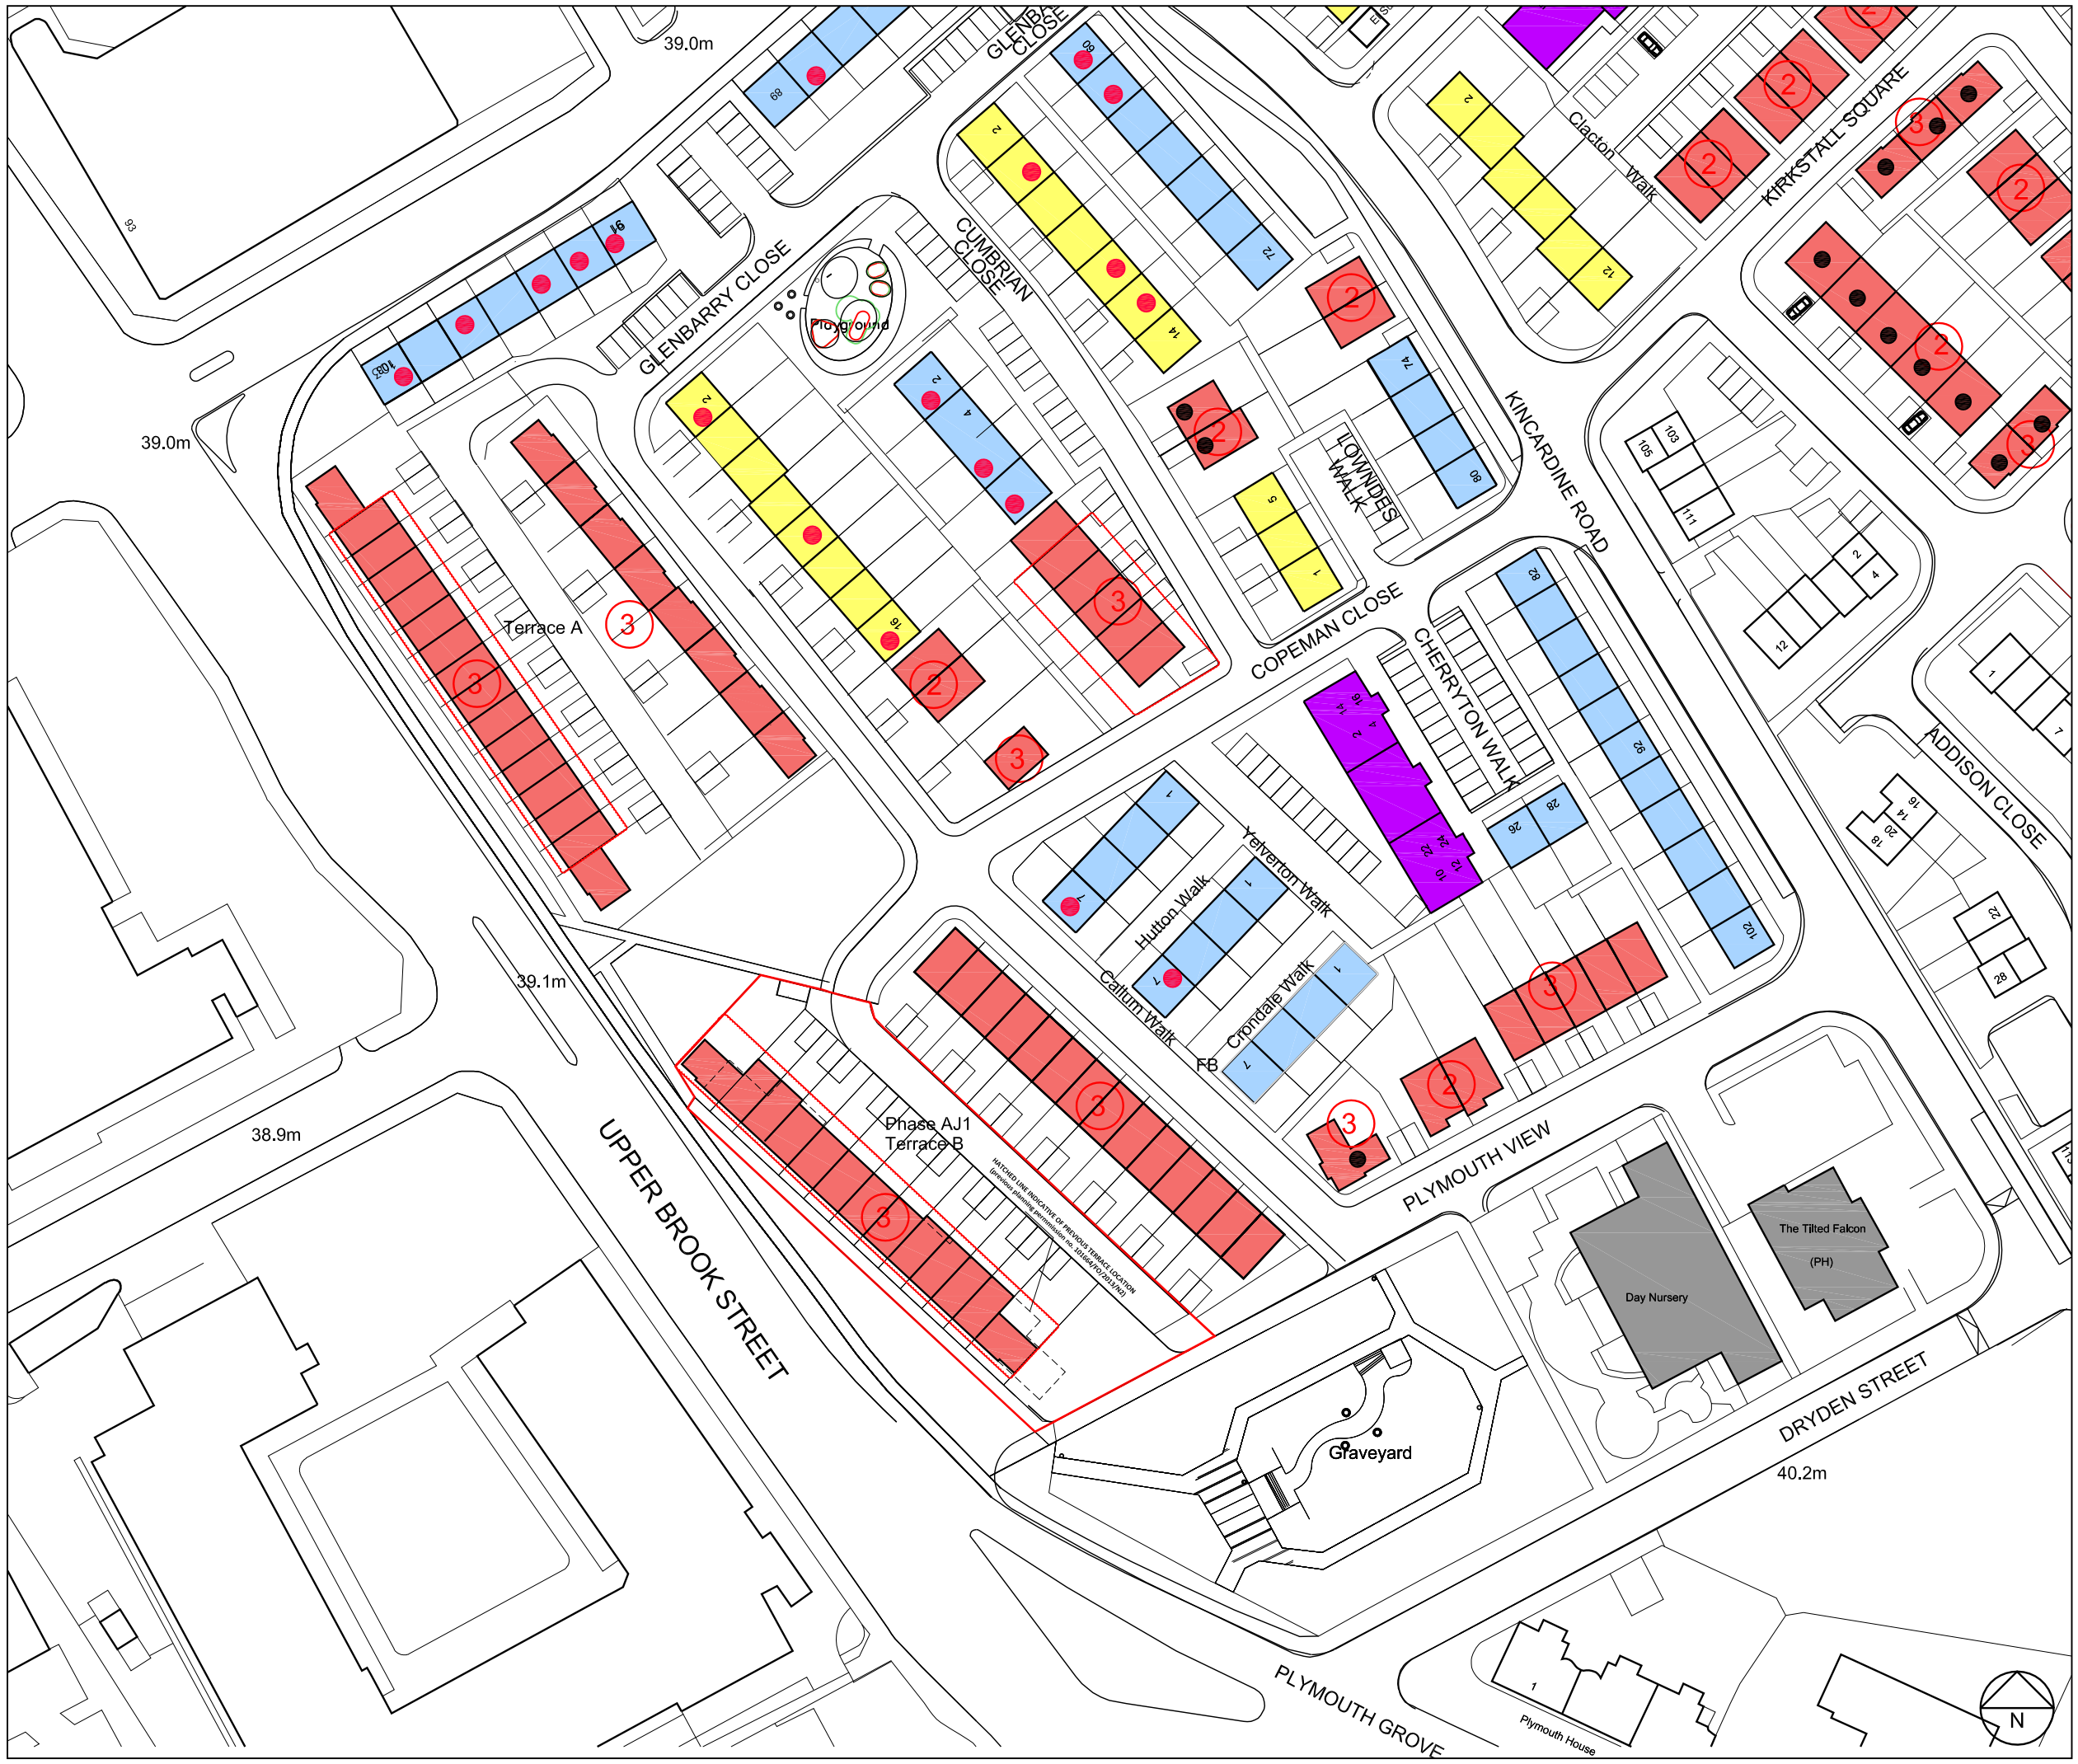

Do not scale from drawing
Dimensions are to be checked on site
If in doubt please ask

- Planning Application Red Line Area
- Existing Property
  REFURBISHED
- Existing Maisonettes
  REFURBISHED
- Existing Property
  REVERSED
- Proposed New Building
  RESIDENTIAL - DFA 2 COMPLIANT - PRIVATE FOR SALE
- Proposed New Building
  RESIDENTIAL - DFA 2 COMPLIANT - RENTED SOCIAL LANDLORD
- Existing Right to Buy Property
  RESIDENTIAL
- (3) CIRCLED NUMBER INDICATES PROPOSED STOREY HEIGHTS
- Proposed New Building
  RESIDENTIAL - NON DFA 2 COMPLIANT - PRIVATE FOR SALE

S4B

BRUNSWICK PFI

Proposed Site Plan - Resiting of Terrace B
13 Residential Units, Upper Brook Street
Phase AJ1 - Terrace B

Drwg. No: **7550 (04) 002** Rev: **A**

Date : 17.02.2014 Scale: 1:1000 @A3 Checked by : MG

buttress fuller alsop williams - architects

31-33 Princess Street, Manchester, M2 4BF - telephone + 44 (0)161 236 3303
fax + 44(0)161 236 3603 - web site:www.bfaw.co.uk - email:contact@bfaw.co.uk
Buttress Fuller Alsop Williams Ltd is Registered in England and Wales: 5363573