PLAN REF : P001

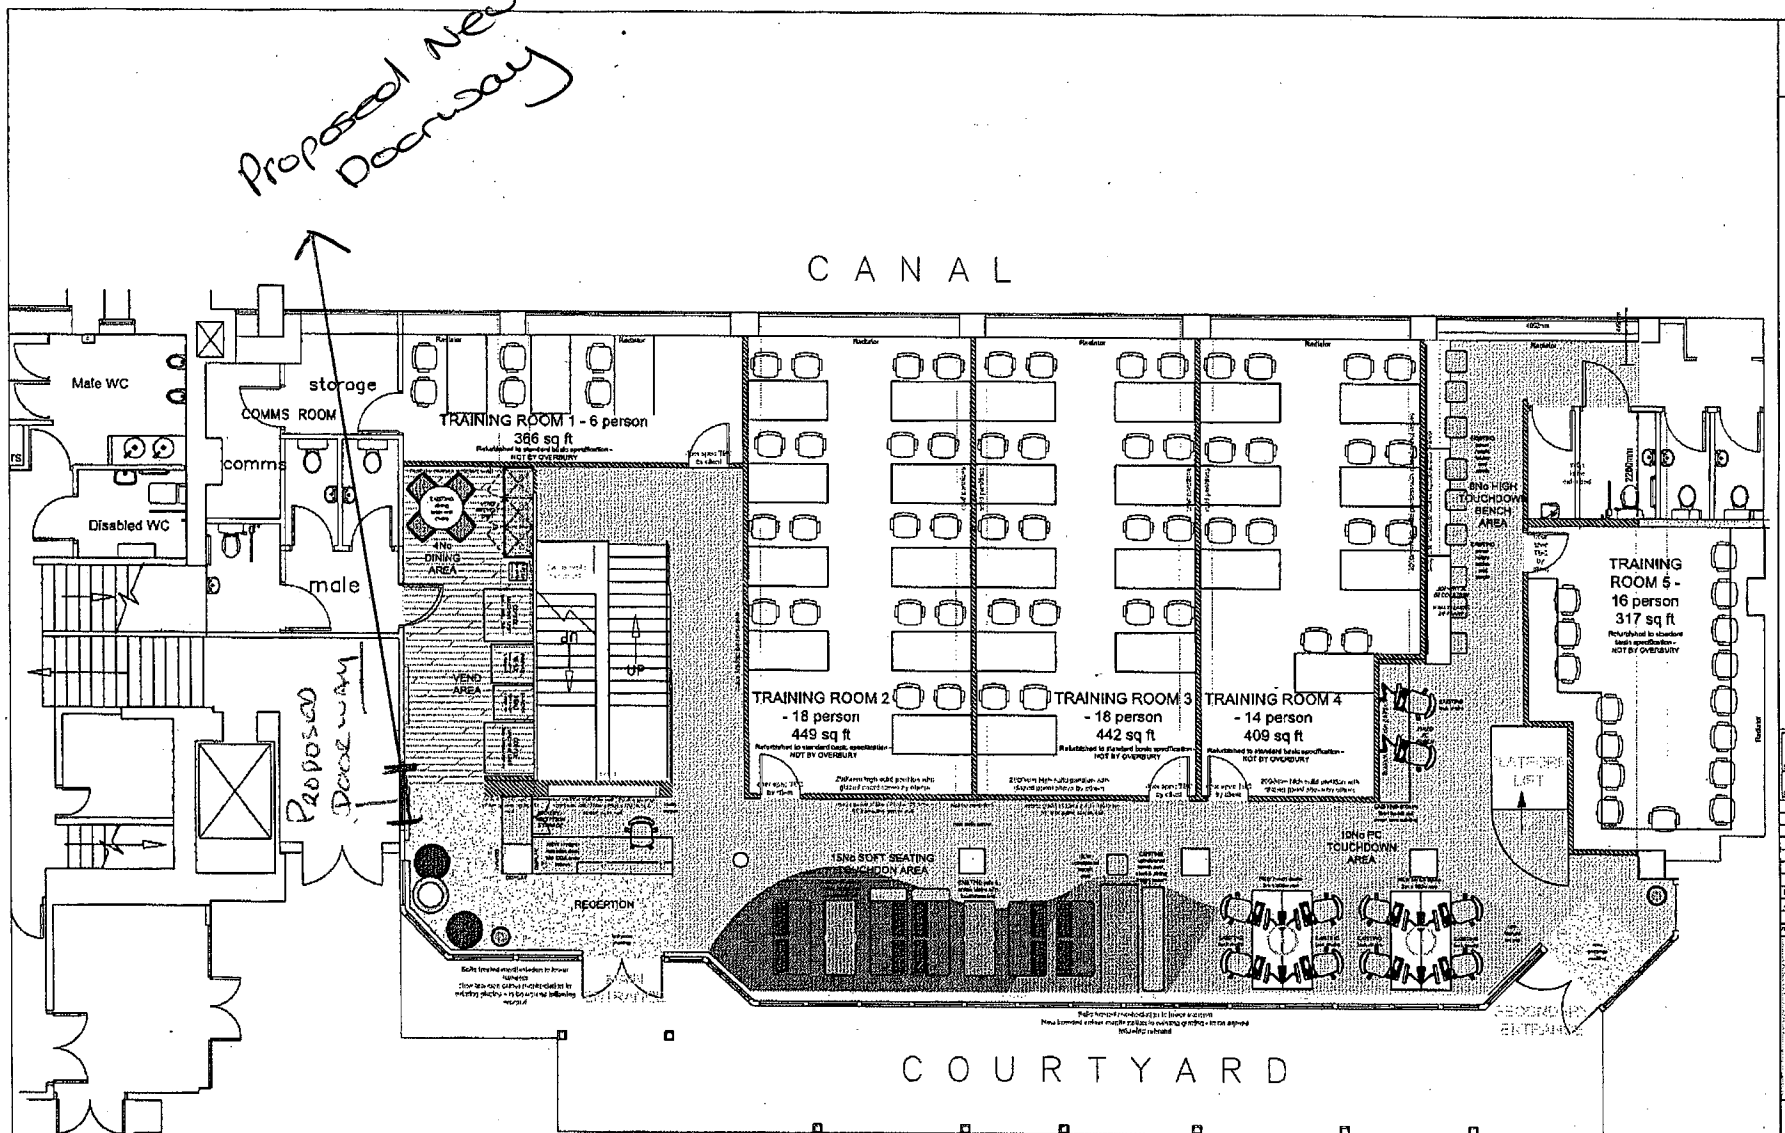

This drawing is protected under Copyright and at no time must any portion of this drawing be reproduced or copied in anyway without the permission of Overbury.

All dimensions must be checked on site and NOT scaled from this drawing.

Building layout shown subject to site survey
Check dimensioned survey undertaken only
Building parameters undertaken from drawings provided by client
Building parameters based on full site survey

Environment provides:

Schedule of Accommodation

STATUS
- PRE-CONTRACT / TENDER
- CONTRACT
- CONSTRUCTION
- APPROVAL/COMMENT
- AS-BUILT
- BUILDING CONTROL

overbury
a passion for perfection

Client
Manchester Solutions

Project
Churchgate House
Oxford Street
Manchester

Title
Ground Floor
Feasibility Layout

Scale	Date	Design n/Drawn By	Checked By/ Dte
1:50@A1	18 03 13	CM	

Project No.	Subphase	Level	Drawing No.	Rev
ND134	CGH	G	OG-FO-01	B

OG FLOOR FEASIBILITY LAYOUT

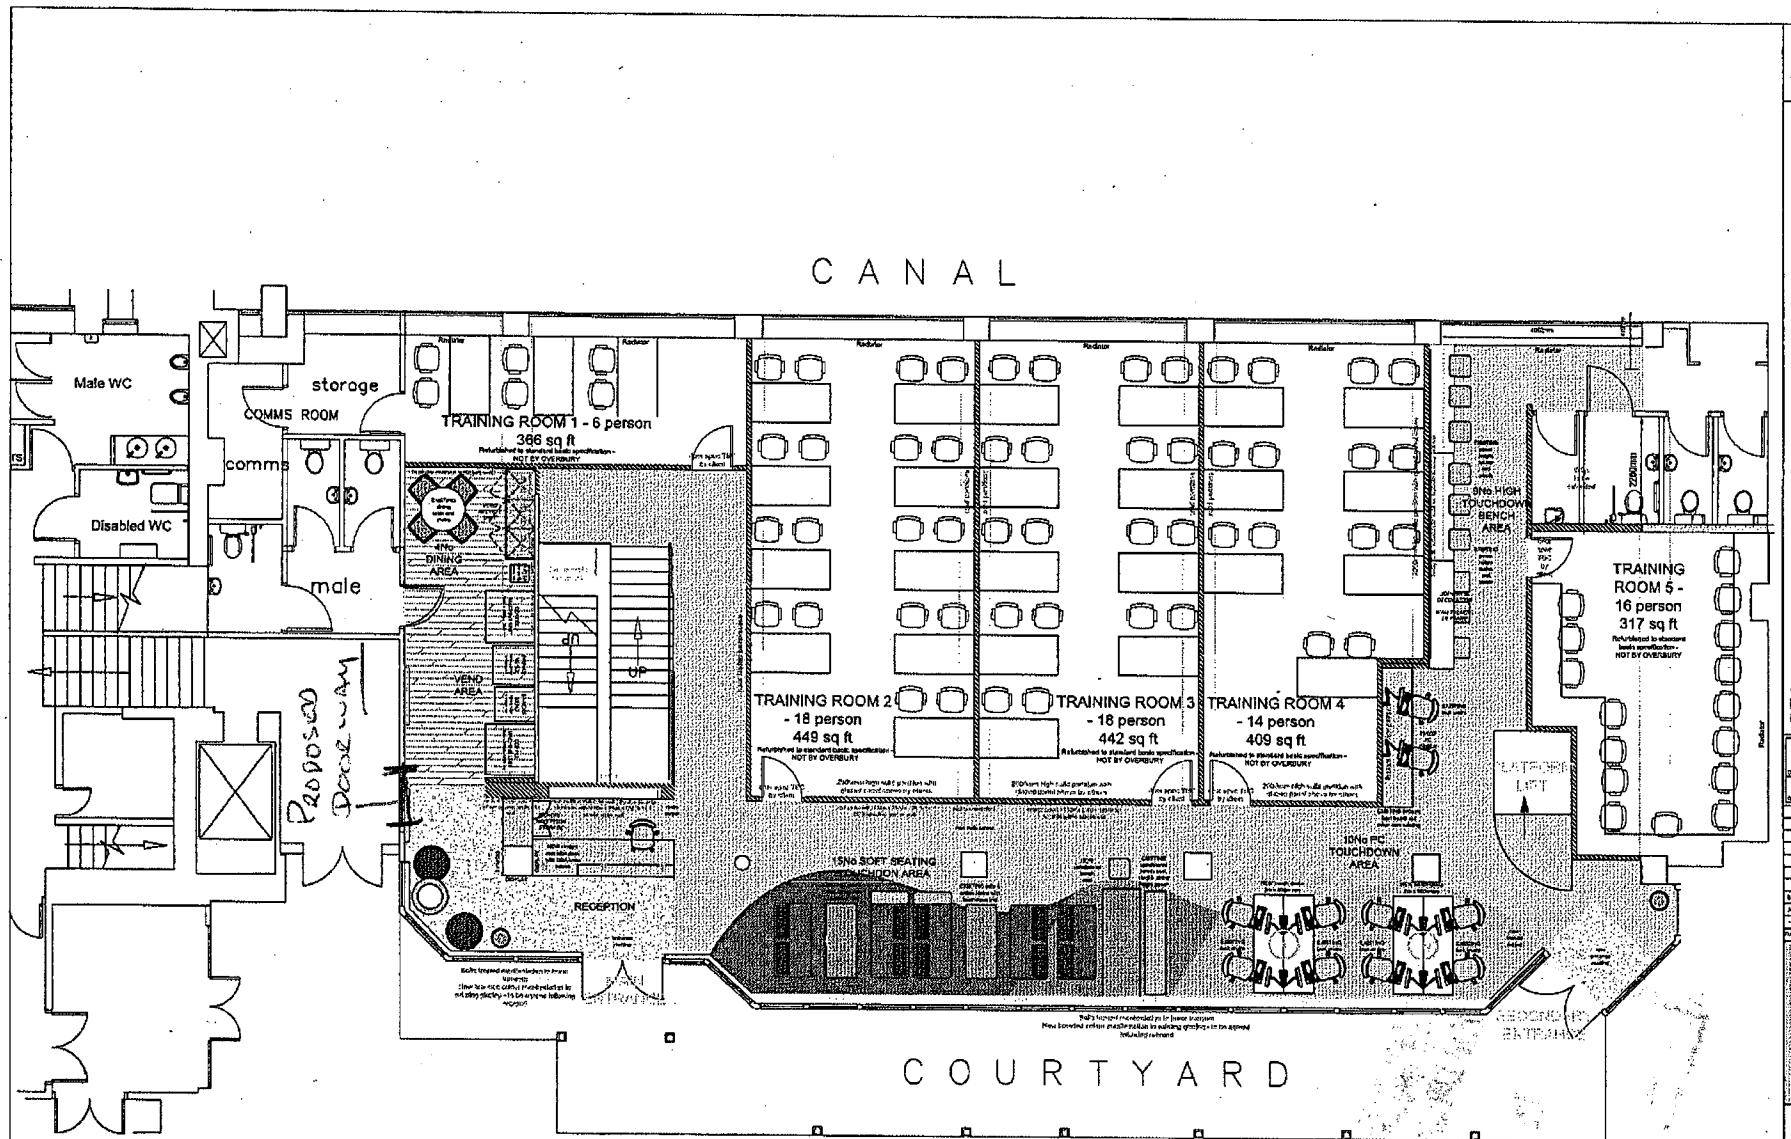

OG FLOOR FEASIBILITY LAYOUT

This drawing is protected under Copyright and at no time must any portion of this drawing be reproduced or copied in anyway without the permission of Overbury.

All dimensions must be checked on site and NOT scaled from this drawing.

Building layout shown subject to site survey
Check dimensioned survey undertaken only
Building parameters undertaken from drawings provided by client
Building parameters based on full site survey

Environment provides:

Schedule of Accommodation:

STATUS

PRE-CONTRACT / FEASIBILITY	APPROVAL/COMMENT
CONTRACT	AS-BUILT
CONSTRUCTION	BUILDING CONTROL

Overbury
a passion for perfection

Client
Manchester Solutions

Project
Churchgate House
Oxford Street
Manchester

Title
Ground Floor
Feasibility Layout

Scale	Date	Drawn/Checked By	Checked By / Date
1:50@A1	18 03 13	CM	

Drawing Number

Project No.	Building	Level	Drawing No.	Rev
ND134	CGH	G	OG-FO-01	B