A3 Size

FOR PLANNING PURPOSES ONLY. USE FIGURED DIMENSIONS ONLY. SUBJECT TO SITE SURVEY AND ALL NECESSARY CONSENTS. ALL DIMENSIONS TO BE CHECKED BY USER AND ANY DISCREPANCIES, ERRORS OR OMMISSIONS TO BE REPORTED TO THE ARCHITECT BEFORE THE WORK COMMENCES. THIS DRAWING IS TO BE READ WITH ALL OTHER RELEVANT MATERIALS.

Revision	Notes	Date	Drawn
A	Updated following meeting with LPA	13.3.14	PD

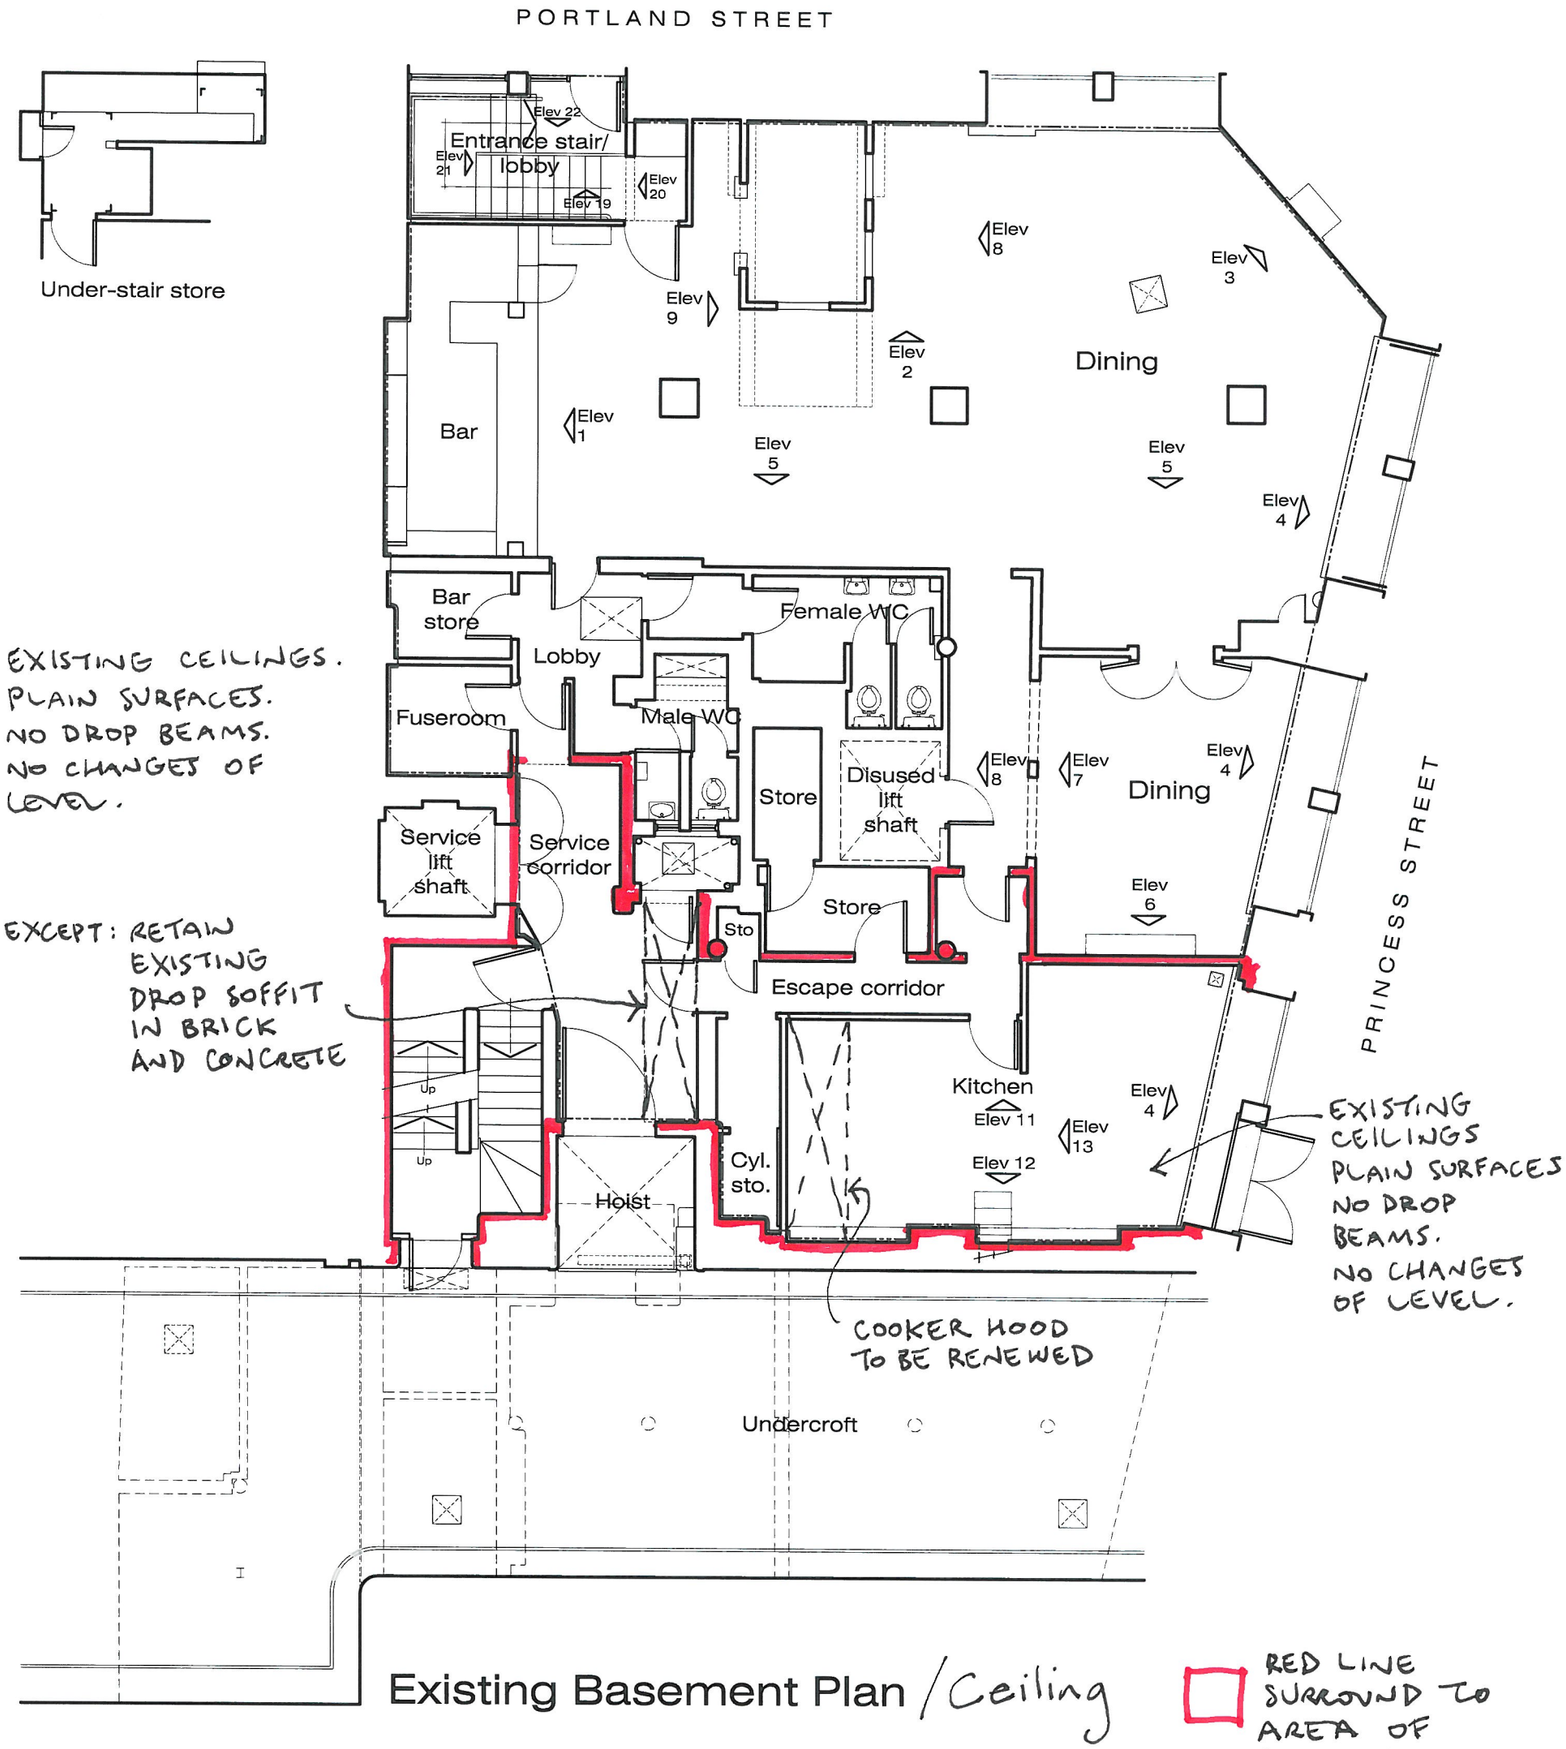

Existing Basement Plan / Ceiling

RED LINE SURROUND TO AREA OF CEILINGS WHERE DUCT INSTALLATION WILL TAKE PLACE

Scale 1:100

0 1m 2m 3m 4m 5m 10m

FA+D

Fuzed A+D Ltd, 74A Water Street, Radcliffe, Manchester, M26 4DF • Tel/Fax: 0161 724 8006 • Email: fuzed@talktalk.net

Project	Basement, No.103 Portland Street, Manchester
Client	Daniel Chen
Content	Existing Plans

Scale	Drawn	Checked	Date	Contract No.	Dwg No.	Rev
1:100 @ A3	PD	-	Nov '13	1129	012.01	A