
THIS DRAWING IS THE PROPERTY OF WORK INC LIMITED AND MUST NOT BE COPIED OR OTHERWISE REPRODUCED.
ALL DIMENSIONS MUST BE CHECKED ON SITE BEFORE COMMENCING WORK. NO DIMENSIONS TO BE SCALED FROM THIS DRAWING.
WORK INTERIORS ARE NOT RESPONSIBLE FOR THE ACCURACY OF INFORMATION RECEIVED FROM OTHERS TO PRODUCE THIS DRAWING UNLESS A FULL SITE SURVEY IS UNDERTAKEN. DRAWING TO BE READ IN CONJUNCTION WITH BUDGETS FOR FINAL SPECIFICATION. ALL DIMENSIONS ARE IN MILLIMETERS.
THIS DRAWING WAS PRODUCED USING AUTOCAD RELEASE 2006.

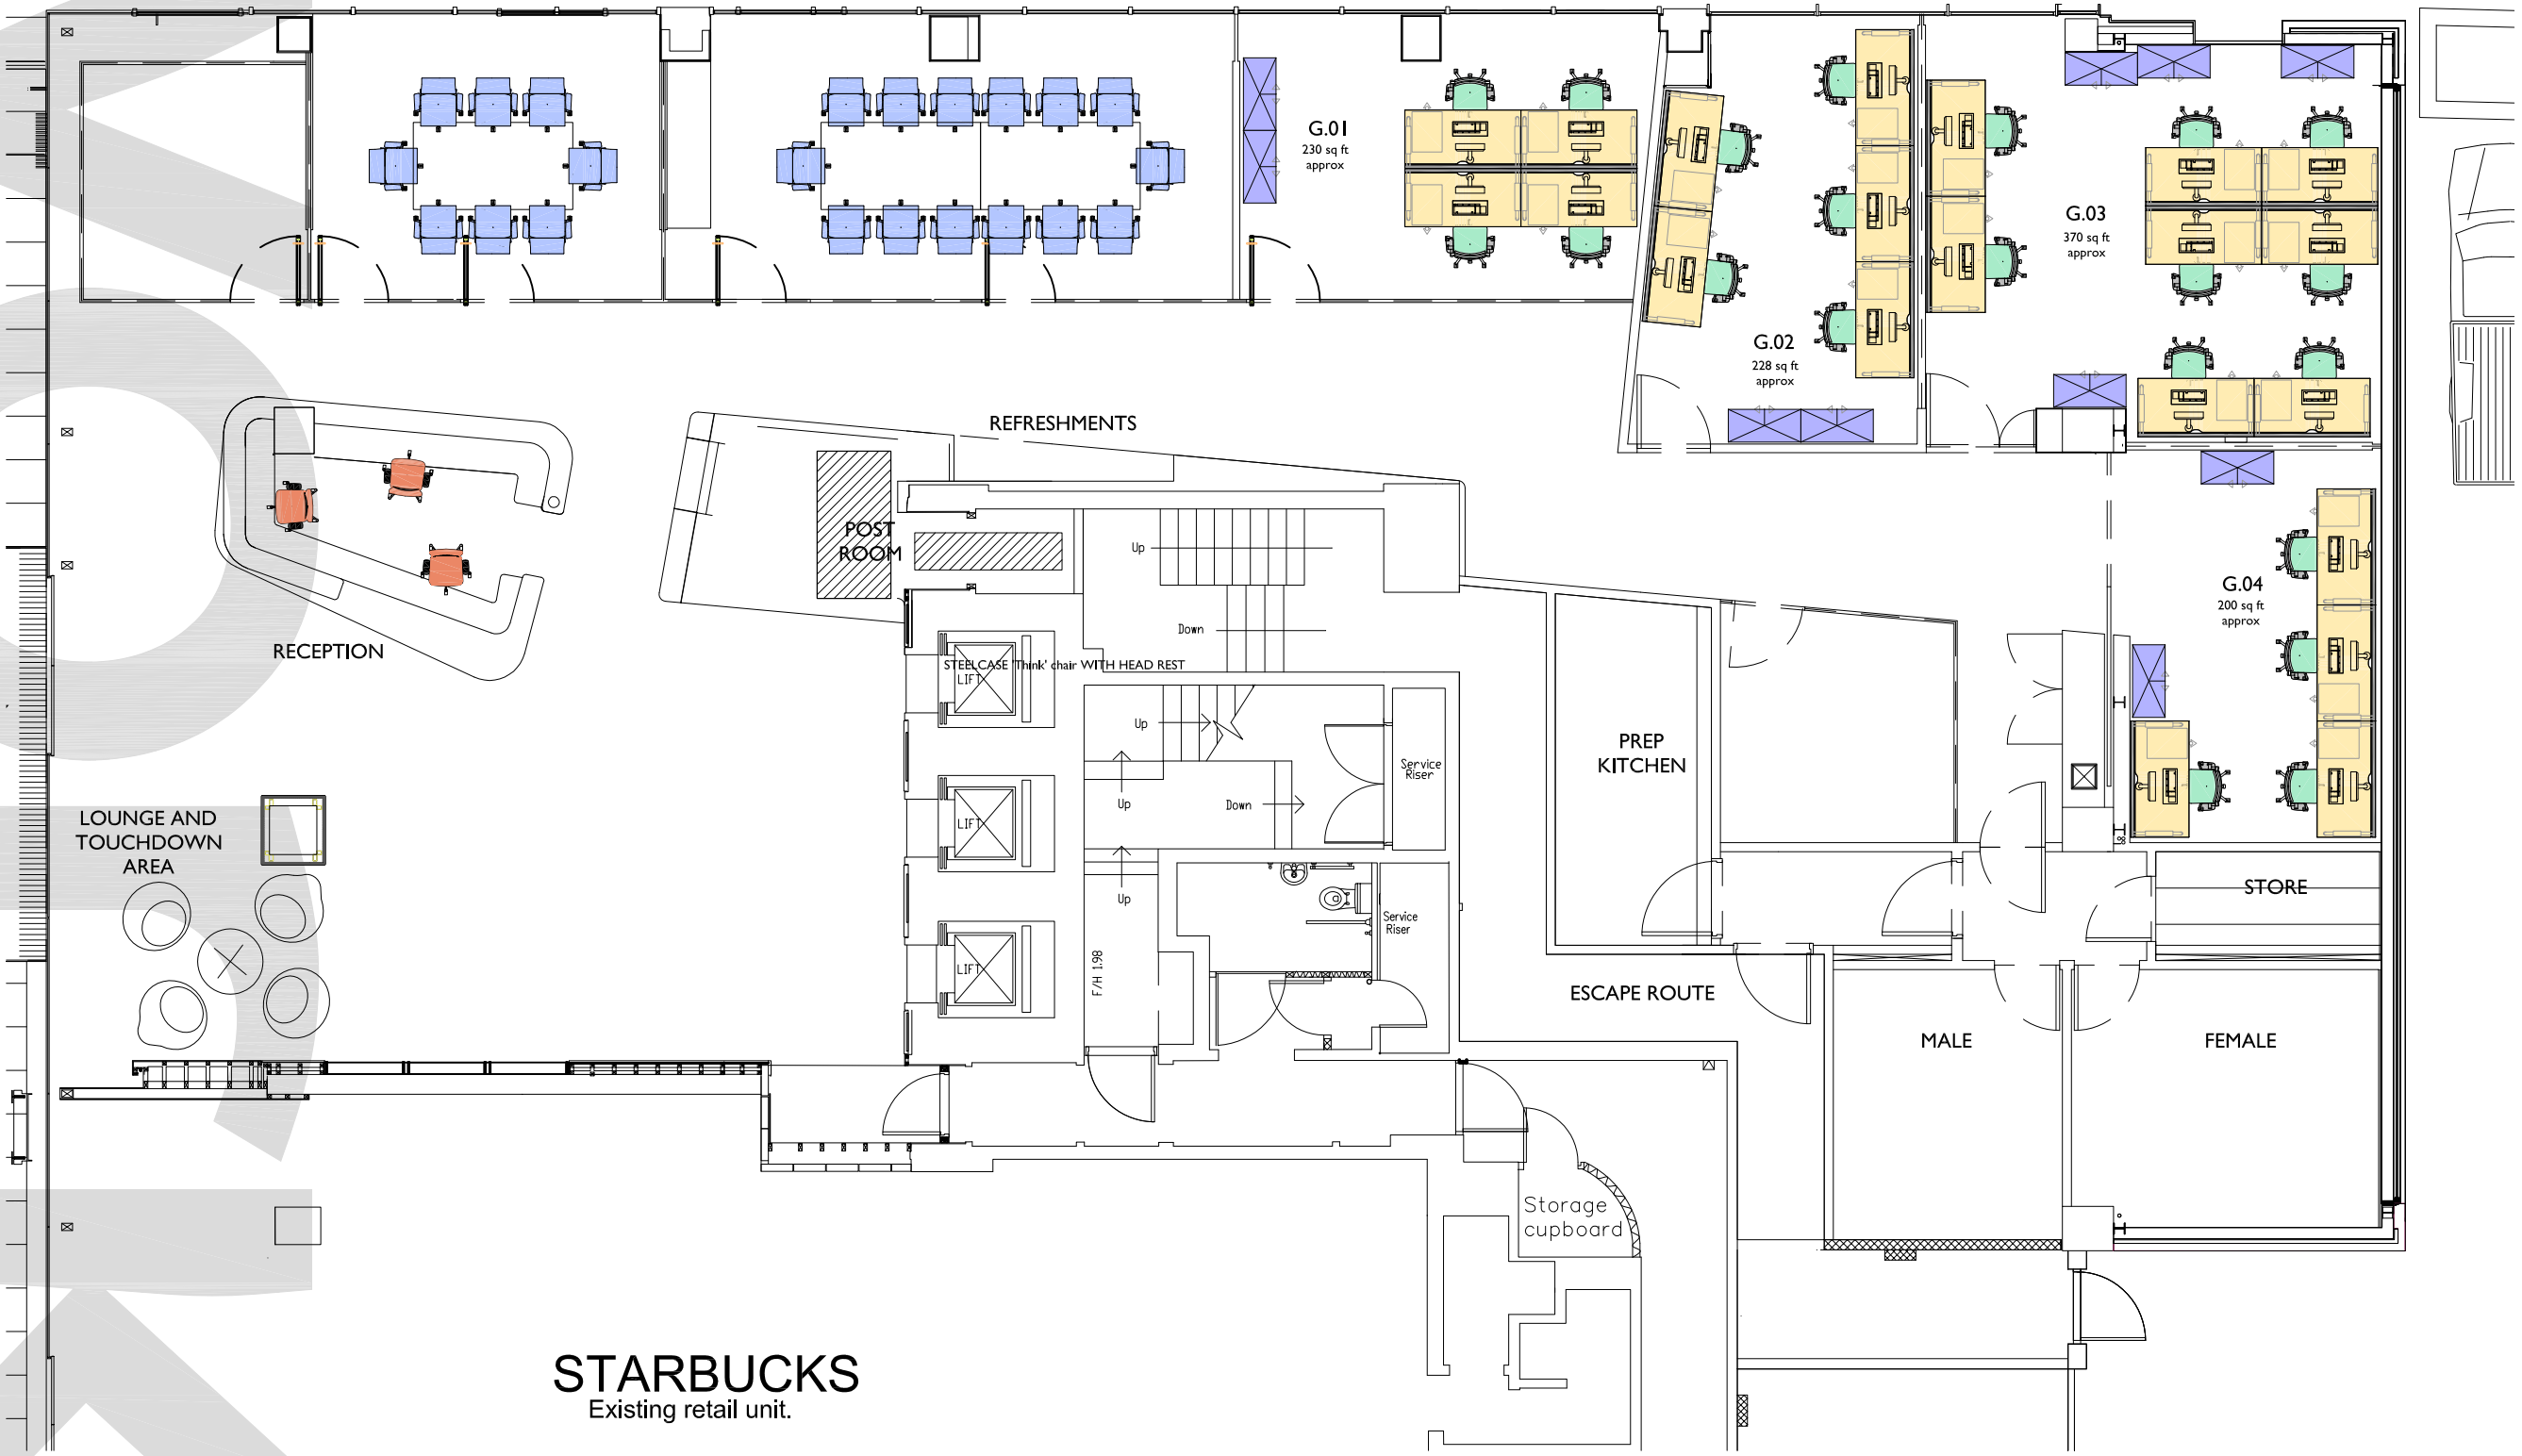

DRAWING TO INDICATE 'AS FITTED' FURNITURE LAYOUT PROVIDED BY WORK INTERIORS. FIT-OUT BY OTHERS. SITE DIMENSIONS TO BE TAKEN PRIOR TO ANY AMENDMENTS.

B	26.09.07	ROOM NUMBERS INDICATED	CRH
A	24.09.07	FIRST FITTED	CRH

REVISIONS

AS BUILT

workINTERIORS

THE KENNELS
HAREWOOD YARD
HAREWOOD
LEEDS
LS17 9LF

TELEPHONE: 0113 288 6111
FACSIMILE: 0113 288 6321

WWW.WORK-INTERIORS.CO.UK

BRUNTWOOD ESTATES LTD

CENTURION HOUSE
DEANSGATE
MANCHESTER

FURNITURE PROPOSAL
GROUND FLOOR PHASE 1 AS BUILT

7650-WD-10G

DRAWN BY	DRAWING DATE	APPROVED BY
CRH	15.12.06	~

SCALE
1:50 AT A1

REVISION
B

© Work Inc Limited 2007

K:\JOBS_Bruntwood\BW-13-Centurion House\BW-13-02_7650 Centurion House ground floor furniture\06-As-Built information