

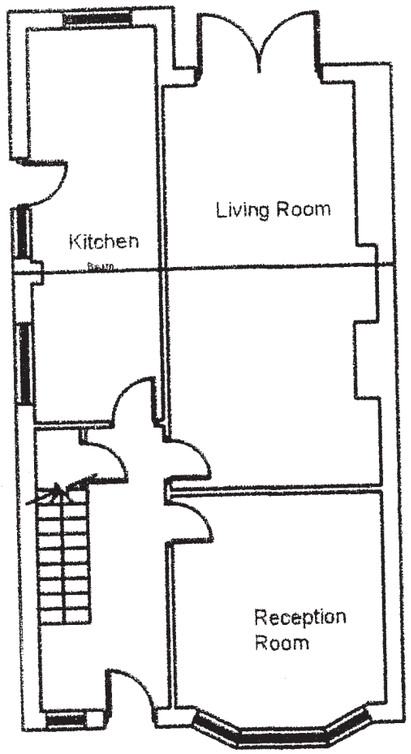



Ground Floor Plan
EXISTING

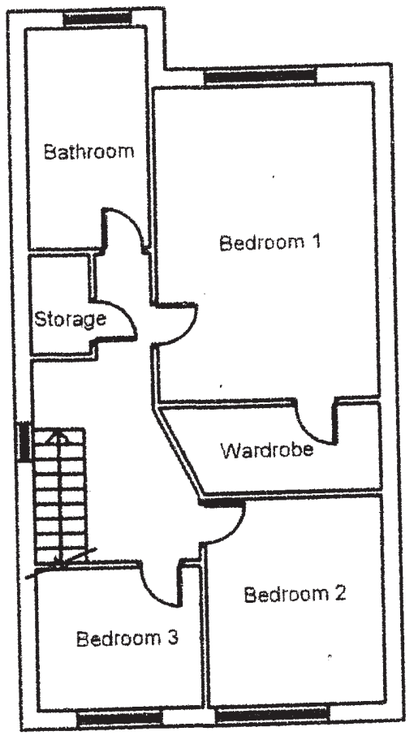

First Floor Plan
EXISTING

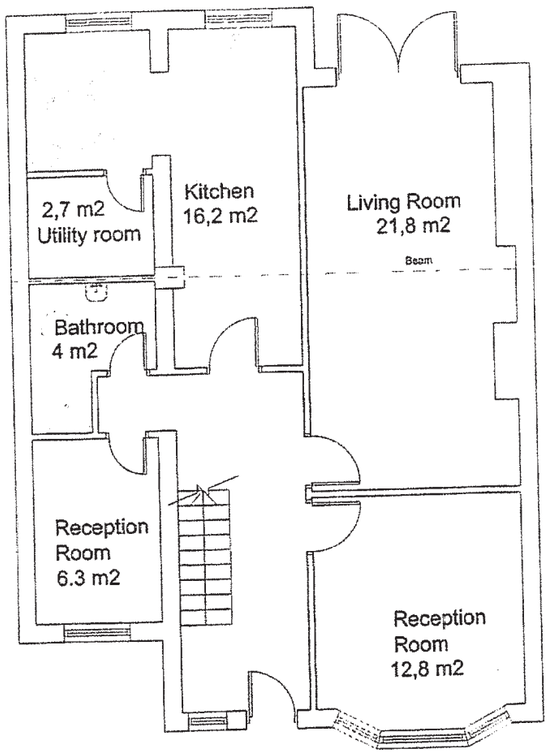

Proposed Ground Floor Plan

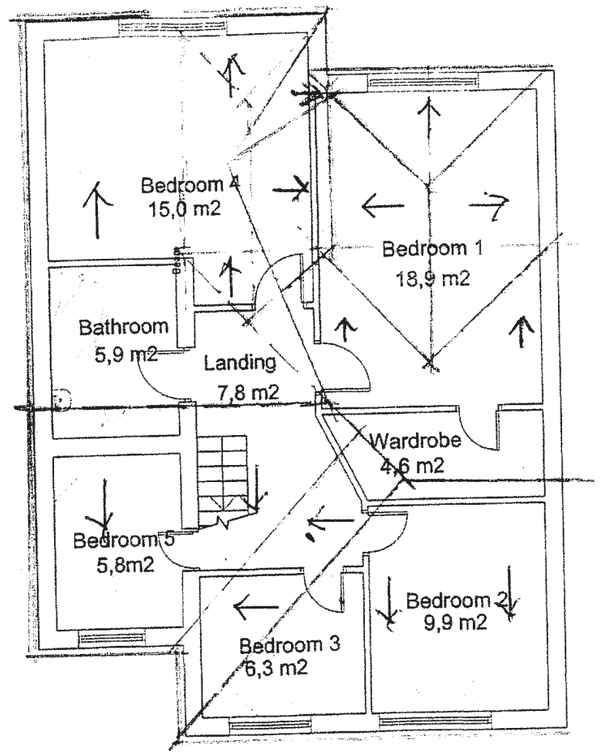

Proposed First Floor Plan

PLANS AS EXISTING, AS CONSTRUCTED
ROOF PLAN AS PROPOSED

Scale 1:100 @ A3

69 EGERTON ROAD SOUTH
CHORLTON M21 0YW

MS/11/01.