



Front Elevation



Side Elevation

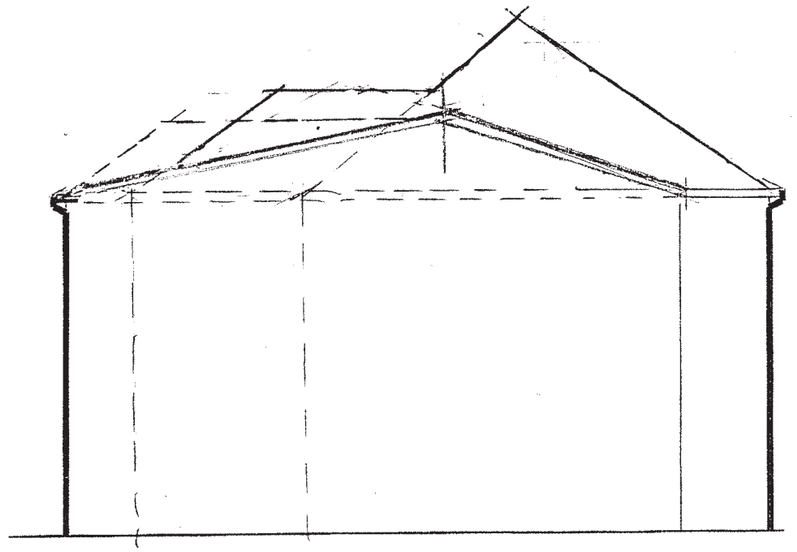

Rear Elevation

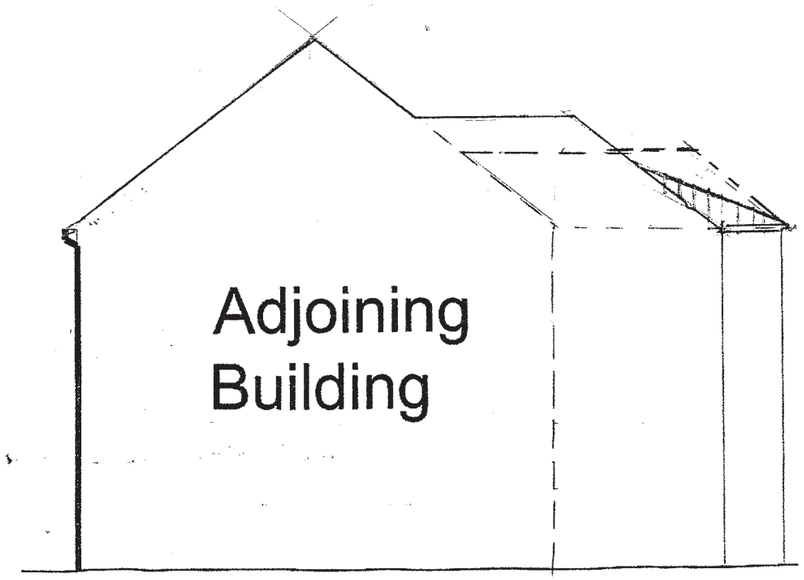

Side Elevation

ELEVATIONS AS CONSTRUCTED

67 EGERTON ROAD SOUTH
CHORLTON M21 0YW

Scale 1:100 @ A3

MAR/14/04