DO NOT SCALE

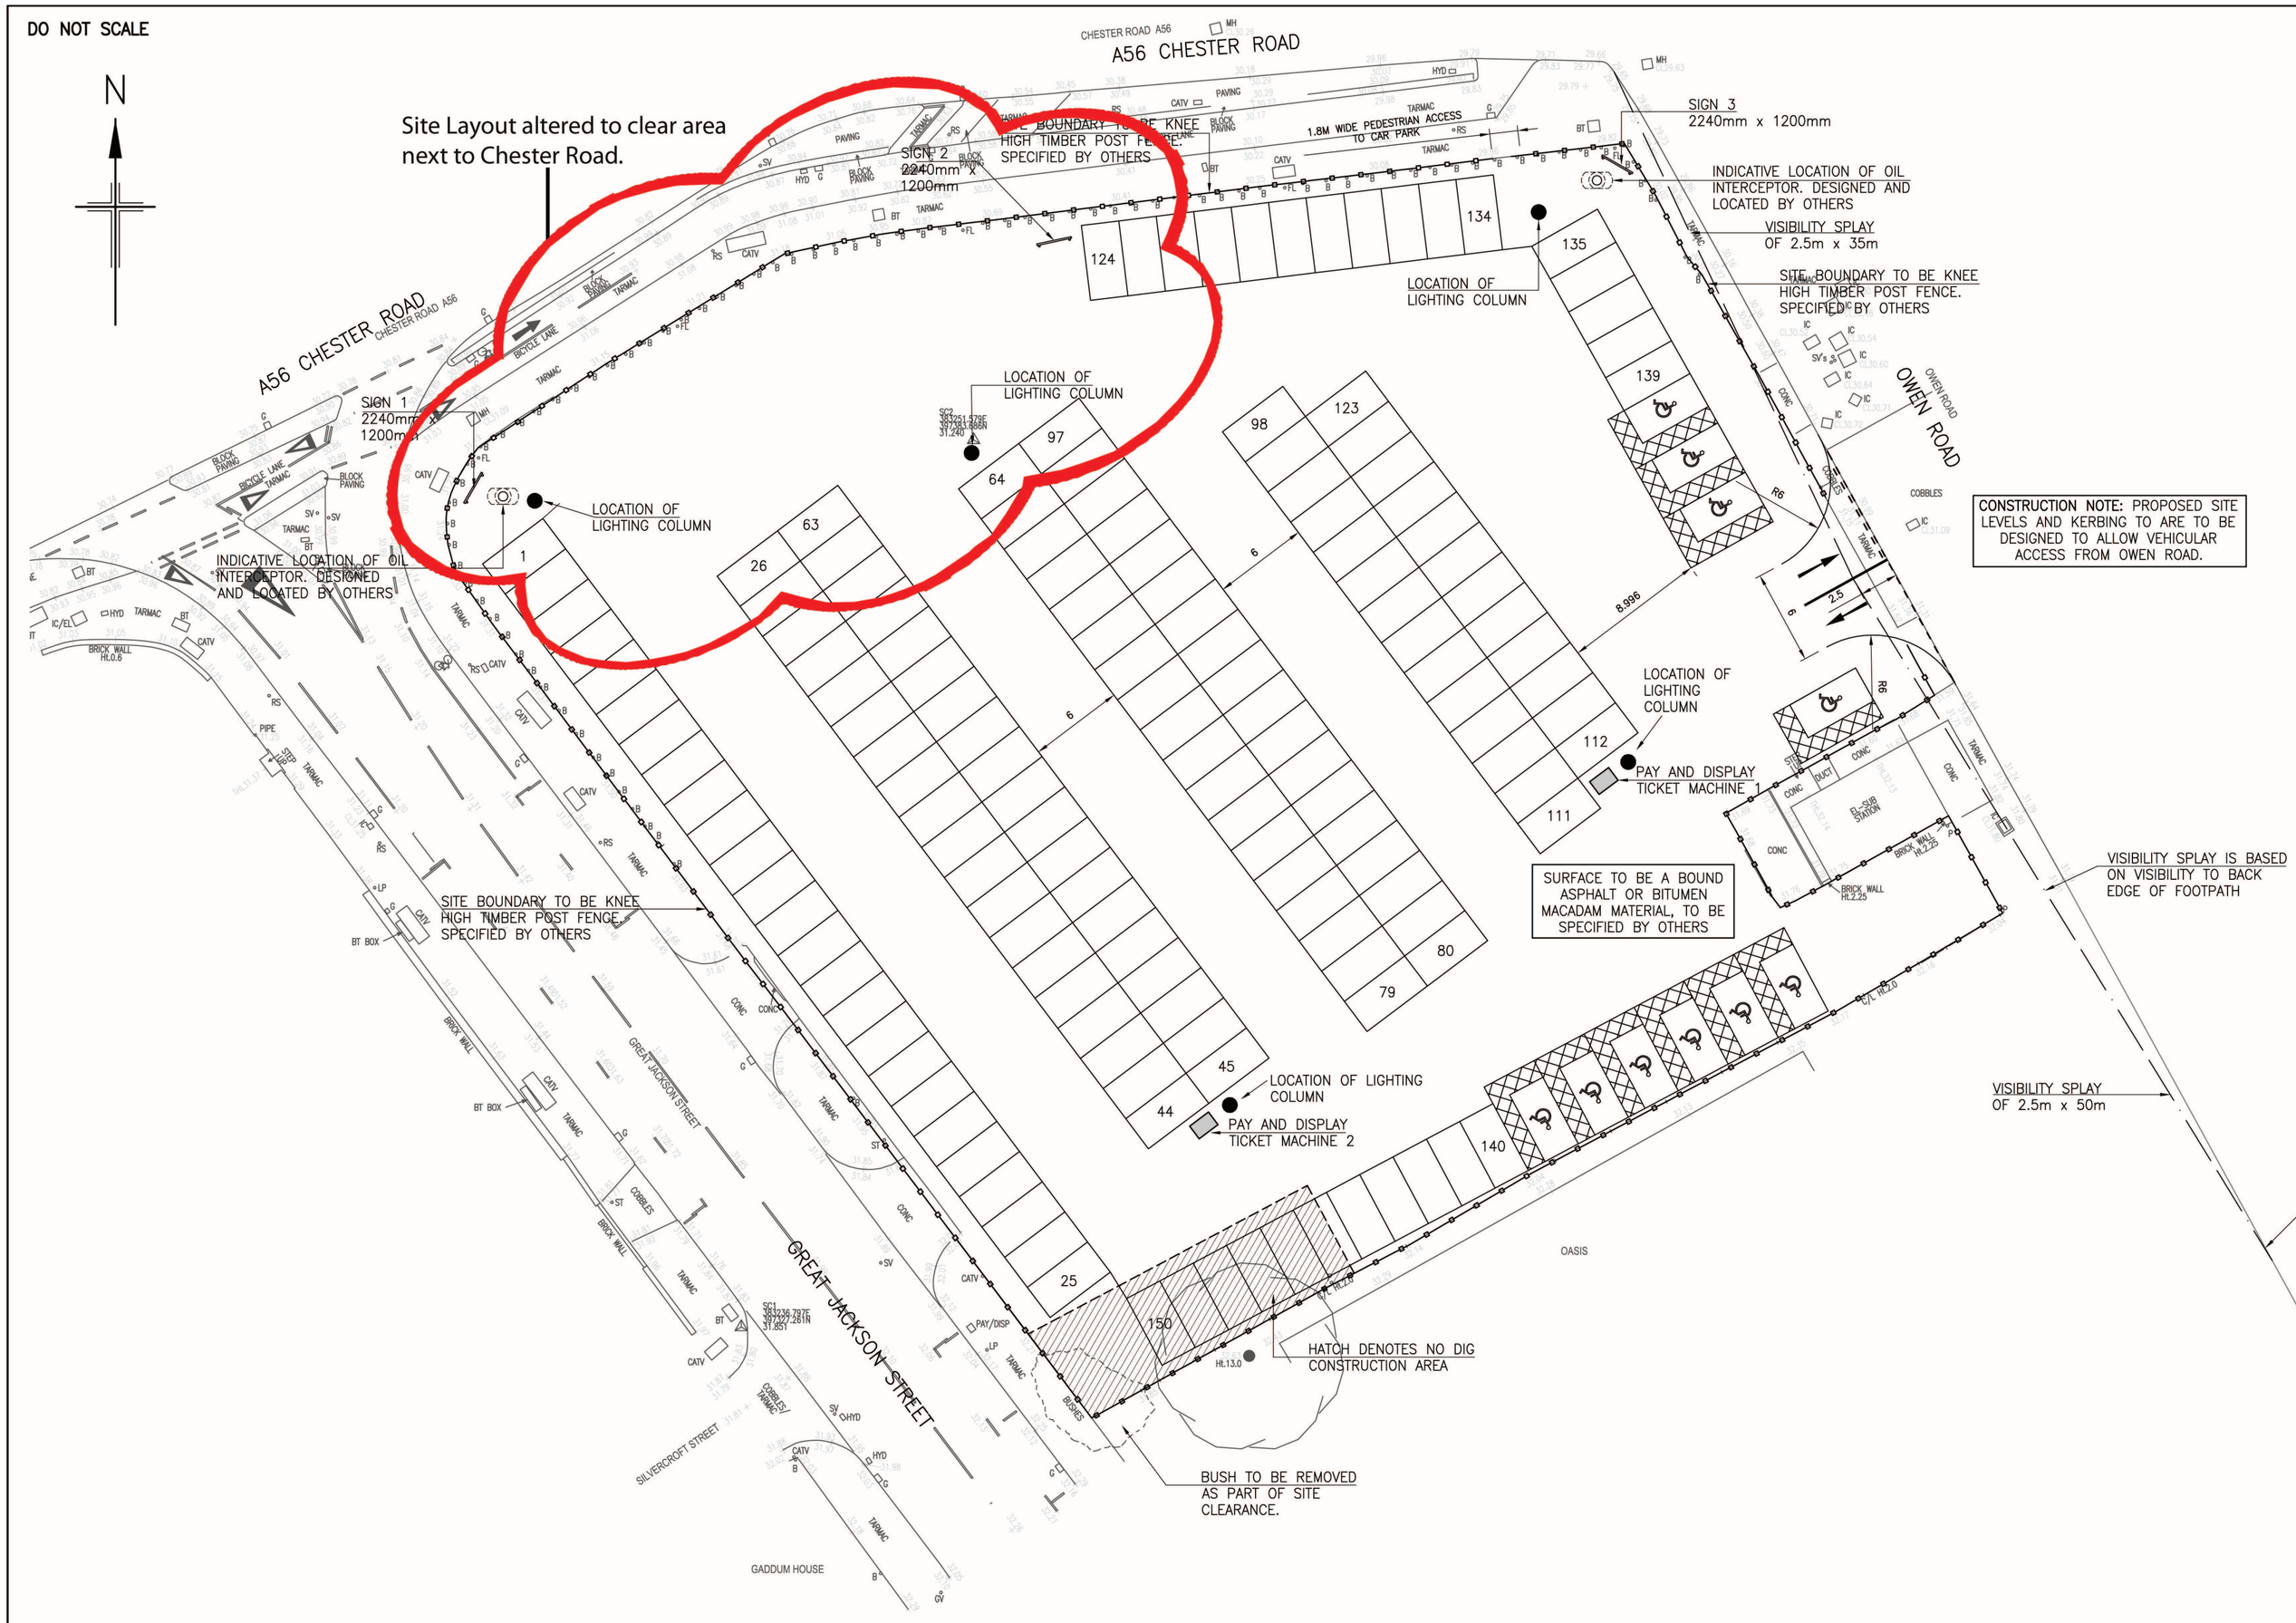

NOTES

1. ALL DIMENSIONS ARE IN METRES UNLESS OTHERWISE STATED.
2. ALL LEVELS ARE IN METRES AND RELATE TO ORDNANCE SURVEY DATUM.
3. ACCESS TO BE TAKEN FROM OWEN ROAD.
4. SURFACE TO BE A BOUND ASPHALT OR BITUMEN MACADAM MATERIAL, TO BE SPECIFIED BY OTHERS.
5. INDICATIVE LOCATION OF OIL INTERCEPTOR. DESIGNED AND LOCATED BY OTHERS.
6. THE CAR PARK IS TO PROVIDE 170 CAR PARKING SPACES AND 10 DISABLES SPACES.
7. ALL LIGHTING IS TO BE PROVIDED USING DIESEL POWER GENERATED LIGHTING.

0 5 10 15 20 25

SCALE 1:250

PROPOSED CAR PARKING LAYOUT

SCALE 1:250

REPRODUCED FROM ORDNANCE SURVEY MAP WITH THE PERMISSION OF THE CONTROLLER OF HER MAJESTY'S STATIONERY OFFICE. © CROWN COPYRIGHT RICHARD JACKSON LTD – ACC No. 100002572.

REV	DATE	DESCRIPTION	DRAWN	CHKD
D	02.10.13	SITE BOUNDARY LINE CHANGED	SAC	
C	12.07.13	PARKING LAYOUT REVISED TO SUIT NEW ENTRANCE AND EXIT OFF OWEN ROAD	MRH	MD
B	17.06.13	REVISED TO SUIT ARCHITECTS COMMENTS	MRH	MD
A	17.06.13	REVISED TO SUIT ARCHITECTS COMMENTS	MRH	MD

REVISIONS

This drawing is to be read in conjunction with all other Engineer's drawings and all other project information. Any discrepancy between the Engineer's drawings and other project information is to be reported to the Engineer immediately.

Project

CHESTER ROAD, MANCHESTER

Title

CAR PARK LAYOUT

Client

RCP PARKING LTD

Scale	Drawn	Date
1:250 @ A1	M HOUSE	13.06.13
Job Manager	Checked	Approved
M DOUGHTY	MJD	

richardjackson
intelligent engineering
26 High Street, Hadleigh, Ipswich, Suffolk IP7 5AP Tel: 01473 825300
Suite 409, 1 Alie Street, London E1 8DE Tel: 020 7448 9910
York House, 3 Station Court, Station Rd, Great Shelford, Cambs CB22 5NE Tel: 01223 314794
6 The Old Church, St. Matthews Road, Norwich, Norfolk NR1 1SP Tel: 01603 230240
The Wheelhouse, Bonds Mill, Stonehouse, Gloucestershire GL10 3RF Tel: 01172 020070
Email Address: mail@rj-ie.co.uk Web Site: http://www.richardjackson.uk.com

Drawing No.	Revision
44795/C/01	D

Drawing Status

☒ INFORMATION ☐ APPROVAL ☐ COSTING
☐ TENDER ☐ CONSTRUCTION ☐ AS CONSTRUCTED

A1

© Richard Jackson Ltd