

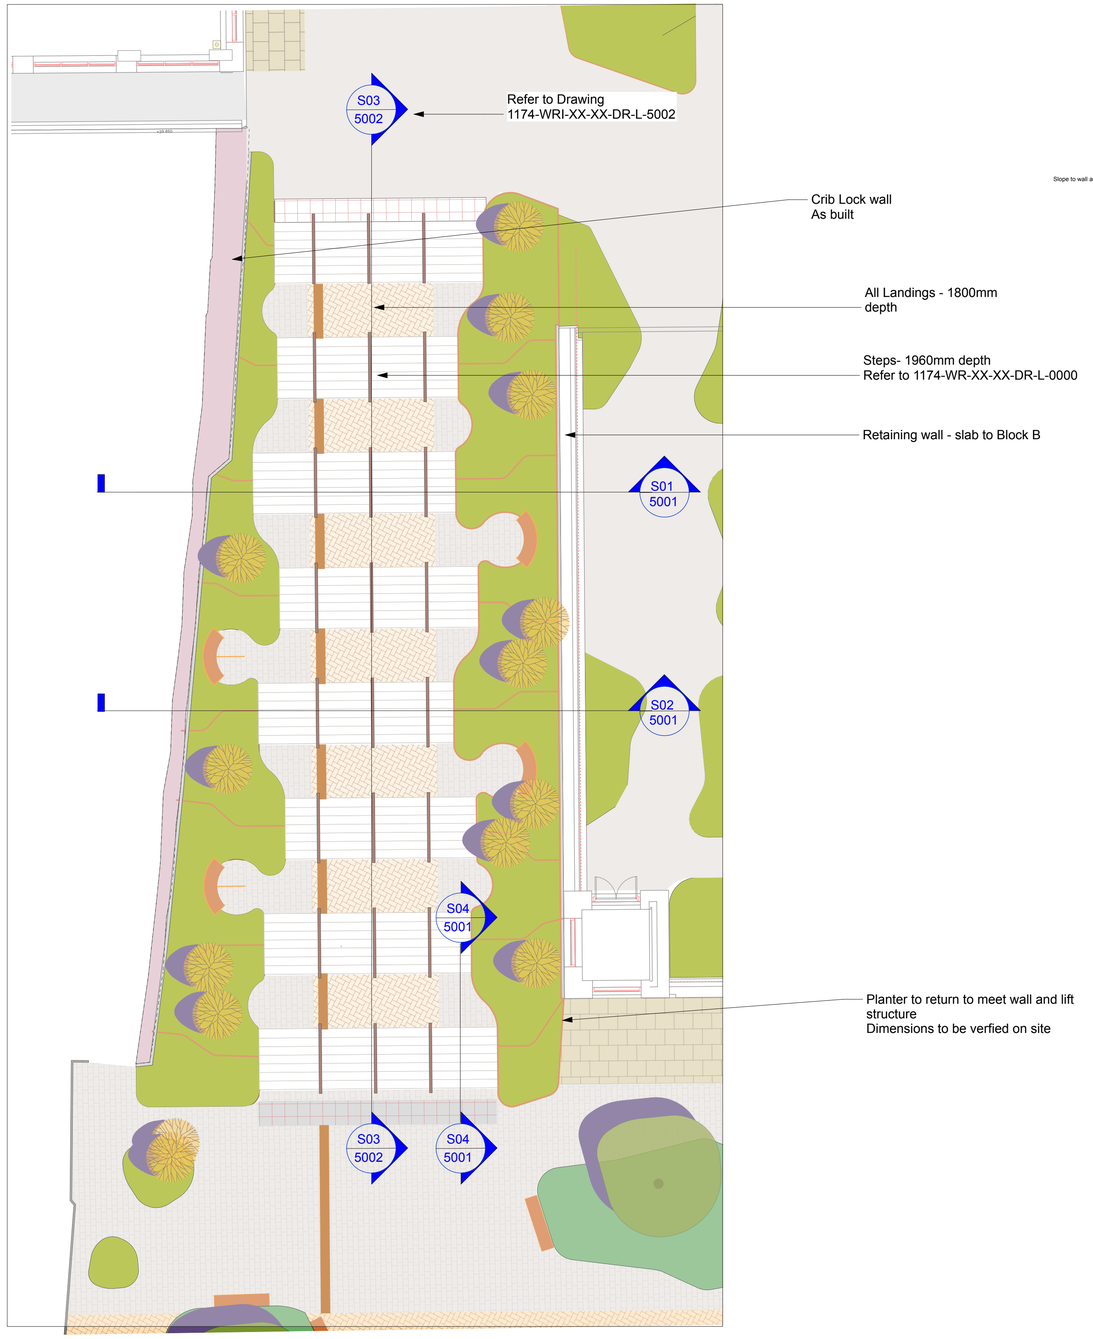



1 STEPPED PLANTER PLAN VIEW
Scale: 1:50

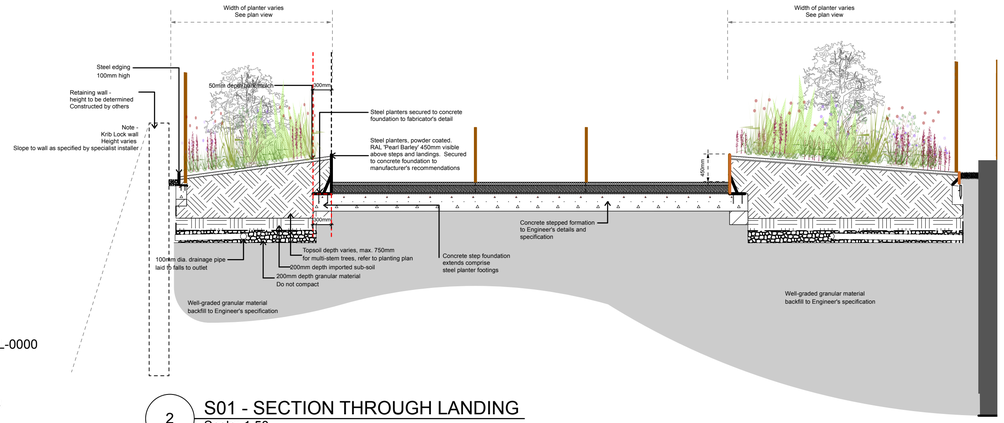

2 S01 - SECTION THROUGH LANDING
Scale: 1:50

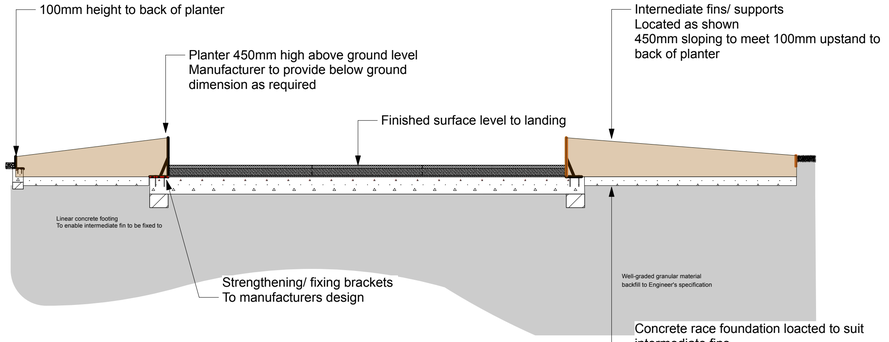

3 S02 - SECTION THROUGH INTERMEDIATE FIN
Scale: 1:50

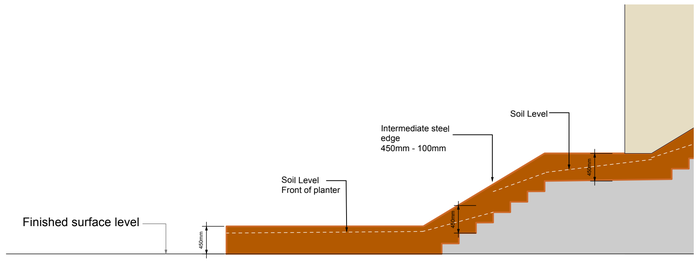


4 S04 - TYPICAL ELEVATION
Scale: 1:50

TO BE READ IN CONJUNCTION WITH
1174-WRI-XX-XX-DR-L-5001 - Planter to main steps - Principle & Sections
1174-WRI-XX-XX-DR-L-5002 - Planter to main steps -Long Section
1174-WRI-XX-XX-DR-L-5003 - Planter to main steps -Dimensions Straight
1174-WRI-XX-XX-DR-L-5004 - Planter to main steps -Dimensions Radius

No dimensions are to be scaled from this drawing. All dimensions are to be checked on site.
Area measurements for indicative purposes only.

This drawing is the property of Wright Landscapes Limited. No part of the drawing may be reproduced in any manner without permission from Wright Landscapes Limited.

All Wright Landscapes drawings to read in conjuction with architectual / engineers plans & details.

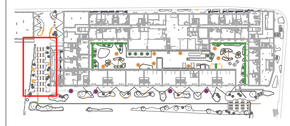

Revision	Date	Description	Drawn	Approved
S5-P02	02-06-25	As Built Crib wall added	SB	NW
S5-P01	21-02-25	For Construction	SB	NW

WRIGHT LANDSCAPES LIMITED

E: info@wrightlandscapes.co.uk
W: www.wrightlandscapes.co.uk
T: 01244 541959

HEAD OFFICE
Pickmere Lane, Pickmere, Knutsford,
WA16 0JL

CLIENT	DOMIS CONSTRUCTION
PROJECT	WATERHOUSE GARDENS
DRAWING TITLE	Planter to Main Steps Principles & Section
DATE 21/02/2025	**SCALE** AS NOTED
DRAWN SB	**SIZE** A1
APPROVED NW	**WORKSTAGE** Stage 5
DRAWING NUMBER 1174-WRI-XX-XX-DR-L-5001	**SUITABILITY** S5 **REVISION** P02

© Wright Landscapes Limited