
NOTES.

1. THIS DRAWING IS COPYRIGHT AND IS SENT TO YOU IN CONFIDENCE.IT MUST NOT BE COPIED,USED OR DISCLOSED IN WHOLE OR IN PART,TO THIRD PARTIES WITHOUT OUR WRITTEN PERMISSION. IT REMAINS THE PROPERTY OF FK CONSTRUCTION LIMITED AND MUST BE RETURNED ON REQUEST.

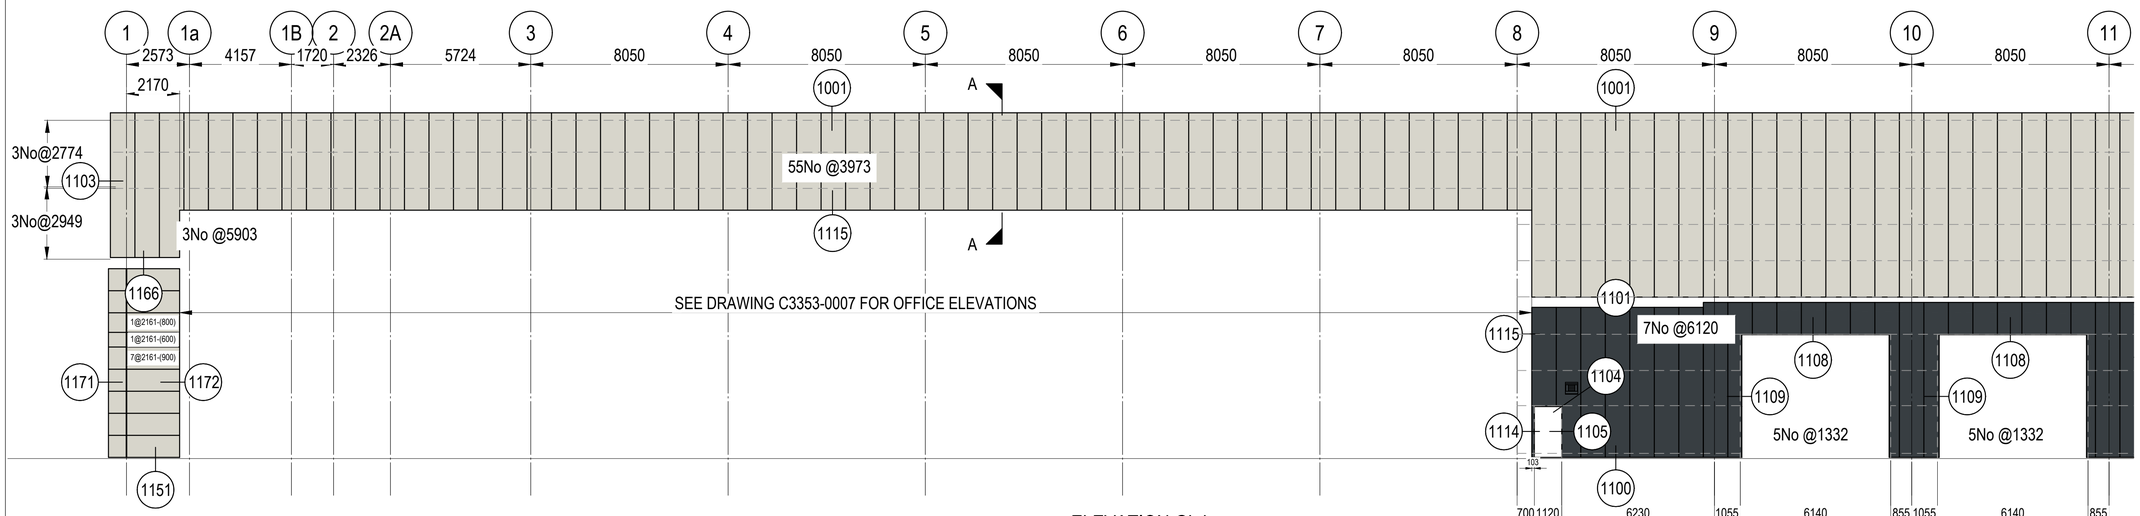


ELEVATION GL L
SCALE 1:125

LAY


KEY

CA32/1000W HAMLET (RAL.9002) OUTER SHEET SEE DRAWING C3353-3002

CA32/1000W ANTHRACITE (RAL.7016) OUTER SHEET SEE DRAWING C3353-3001

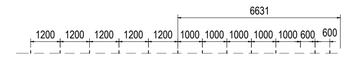

TYPICAL CORNER BRACKET AND BAR SET OUT

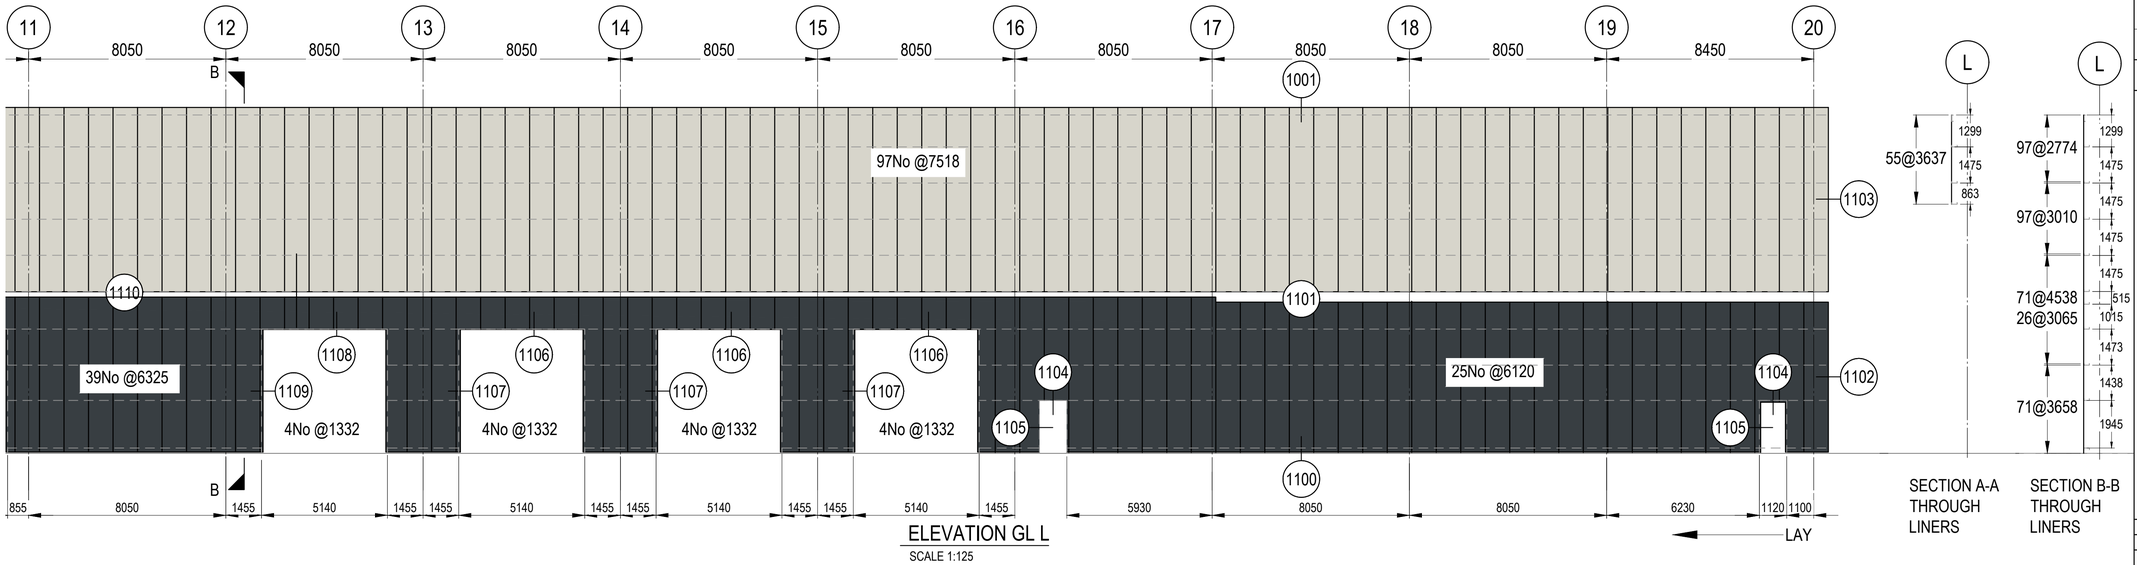

ELEVATION GL L
SCALE 1:125

LAY

SECTION A-A THROUGH LINERS

SECTION B-B THROUGH LINERS

AS BUILT

REV	DETAILS	DATE
AB01	AS BUILT	20/07/20
C02	ADDITIONAL PERSONNEL DOORS ADDED	19/02/20
C01	ISSUED FOR CONSTRUCTION	16/12/19
P02	OFFICE DRAWN - ISSUED FOR COMMENT	21/11/19
P01	ISSUED FOR COMMENT	14/10/19

KEENAN HOUSE
22-26 STOCKPORT ROAD
ALTRINCHAM
WA15 8EX

OFFICE TELEPHONE:0161 926 1350
www.fkgroup.co.uk

DRAWN BY	CHKD BY	DATE	SCALE
LP	GDB	10/10/19	1:125

CLIENT

McLAREN GROUP

CONTRACT

DNATA
MANCHESTER AIRPORT

DRAWING TITLE

ELEVATION ON GL L

DRAWING No. C3353-0005 AB01

DOC REF.