


NOTE: FIRE WALL CONSTRUCTION (PROTECTED AREA)
EQUATES TO 16.25% OF THE CLAD ELEVATION

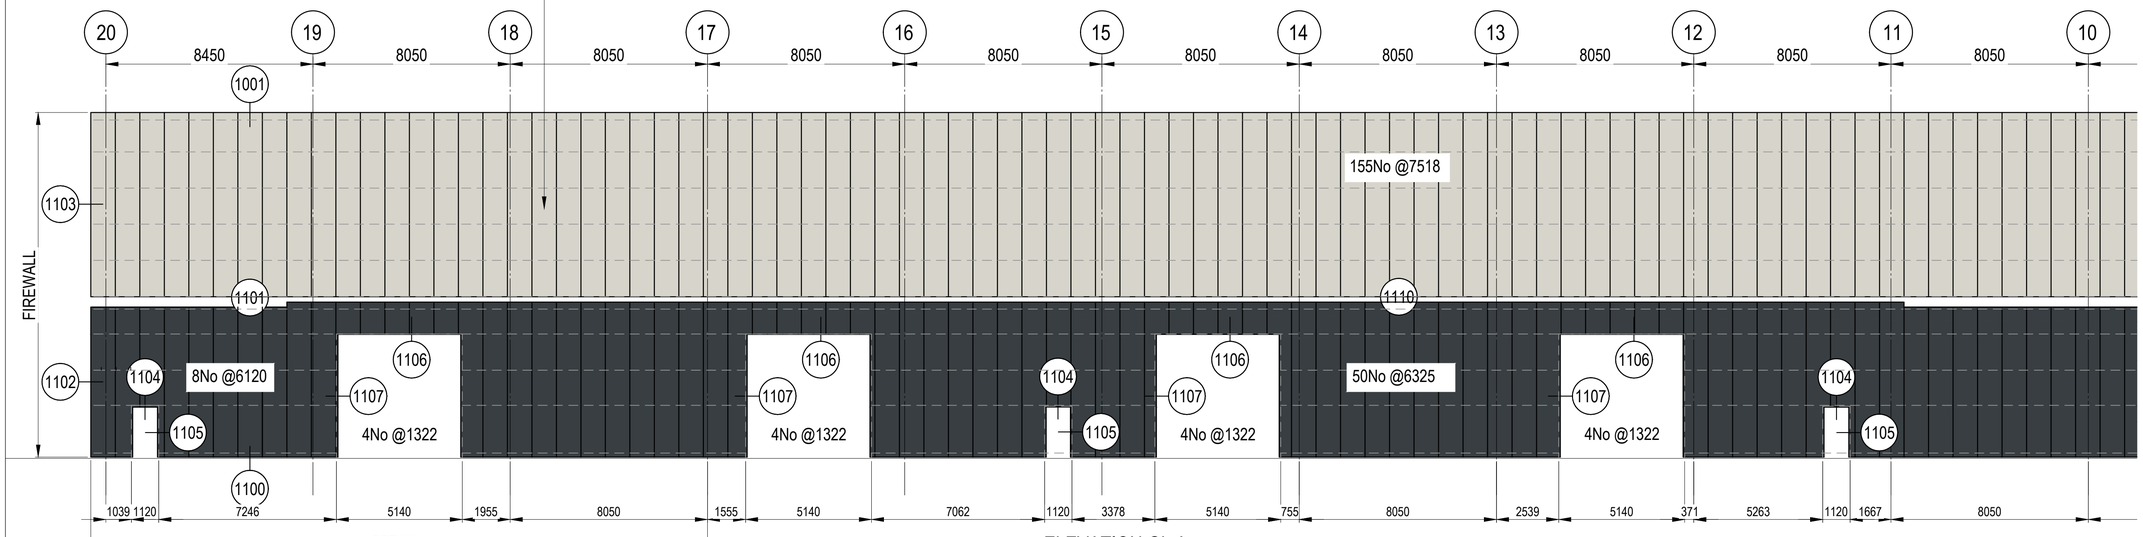


ELEVATION GL A
SCALE 1:125

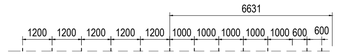

TYPICAL CORNER BRACKET AND BAR SET OUT

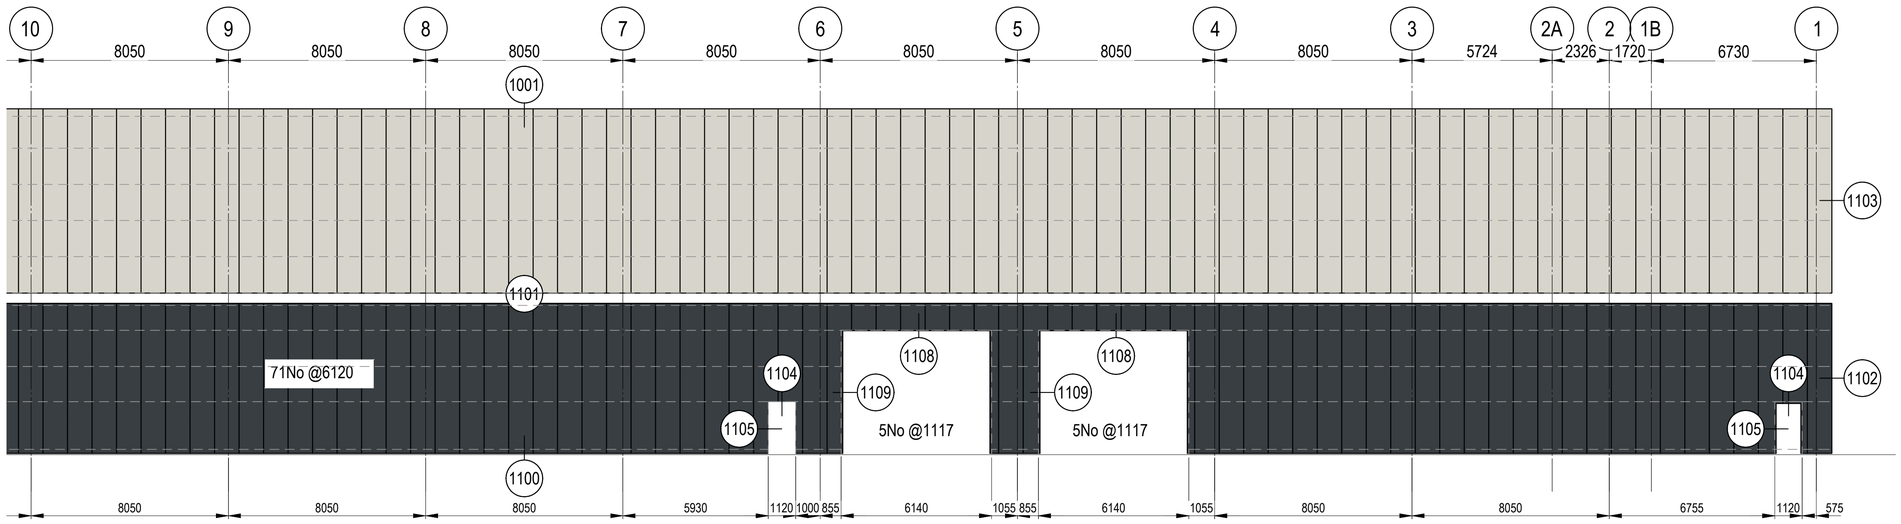

ELEVATION GL A
SCALE 1:125

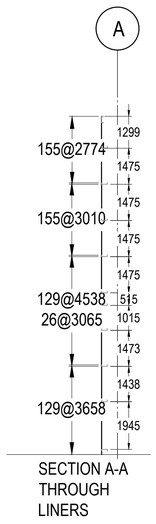

SECTION A-A
THROUGH
LINERS

NOTES.

1. THIS DRAWING IS COPYRIGHT AND IS SENT TO YOU IN CONFIDENCE.IT MUST NOT BE COPIED,USED OR DISCLOSED IN WHOLE OR IN PART,TO THIRD PARTIES WITHOUT OUR WRITTEN PERMISSION. IT REMAINS THE PROPERTY OF FK CONSTRUCTION LIMITED AND MUST BE RETURNED ON REQUEST.

KEY

- CA32/1000W HAMLET (RAL.9002) OUTER SHEET SEE DRAWING C3353-3002
- CA32/1000W ANTHRACITE (RAL.7016) OUTER SHEET SEE DRAWING C3353-3001

AB01	AS BUILT	20/07/20

AS BUILT

REV	DETAILS	DATE
C04	FIRE WALL AREA REVISED TO GL A	18/03/20
C03	ADDITIONAL PERSONNEL DOORS ADDED	19/02/20
C02	BOTTOM LINER PANEL SIZE AMENDED	14/01/20
C01	ISSUED FOR CONSTRUCTION	21/11/19
P01	ISSUED FOR COMMENT	14/10/19

KEENAN HOUSE
22-26 STOCKPORT ROAD
ALTRINCHAM
WA15 8EX

OFFICE TELEPHONE:0161 926 1350
www.fkgroup.co.uk

DRAWN BY	CHKD BY	DATE	SCALE
LP	GDB	10/10/19	1:125

CLIENT
McLAREN GROUP

CONTRACT
DNATA
MANCHESTER AIRPORT

DRAWING TITLE
ELEVATION ON GL A

DRAWING No. C3353-0004 AB01

DOC REF.