
Lincoln Manc :Floor area 407sqm / 4380sqft

Non material change to a planning permission : 140162/NMC/2024
Amend conditions 16, 18 and 16 regarding planning permision: 111805/FO/2016/C1
Approved 7.06.2024

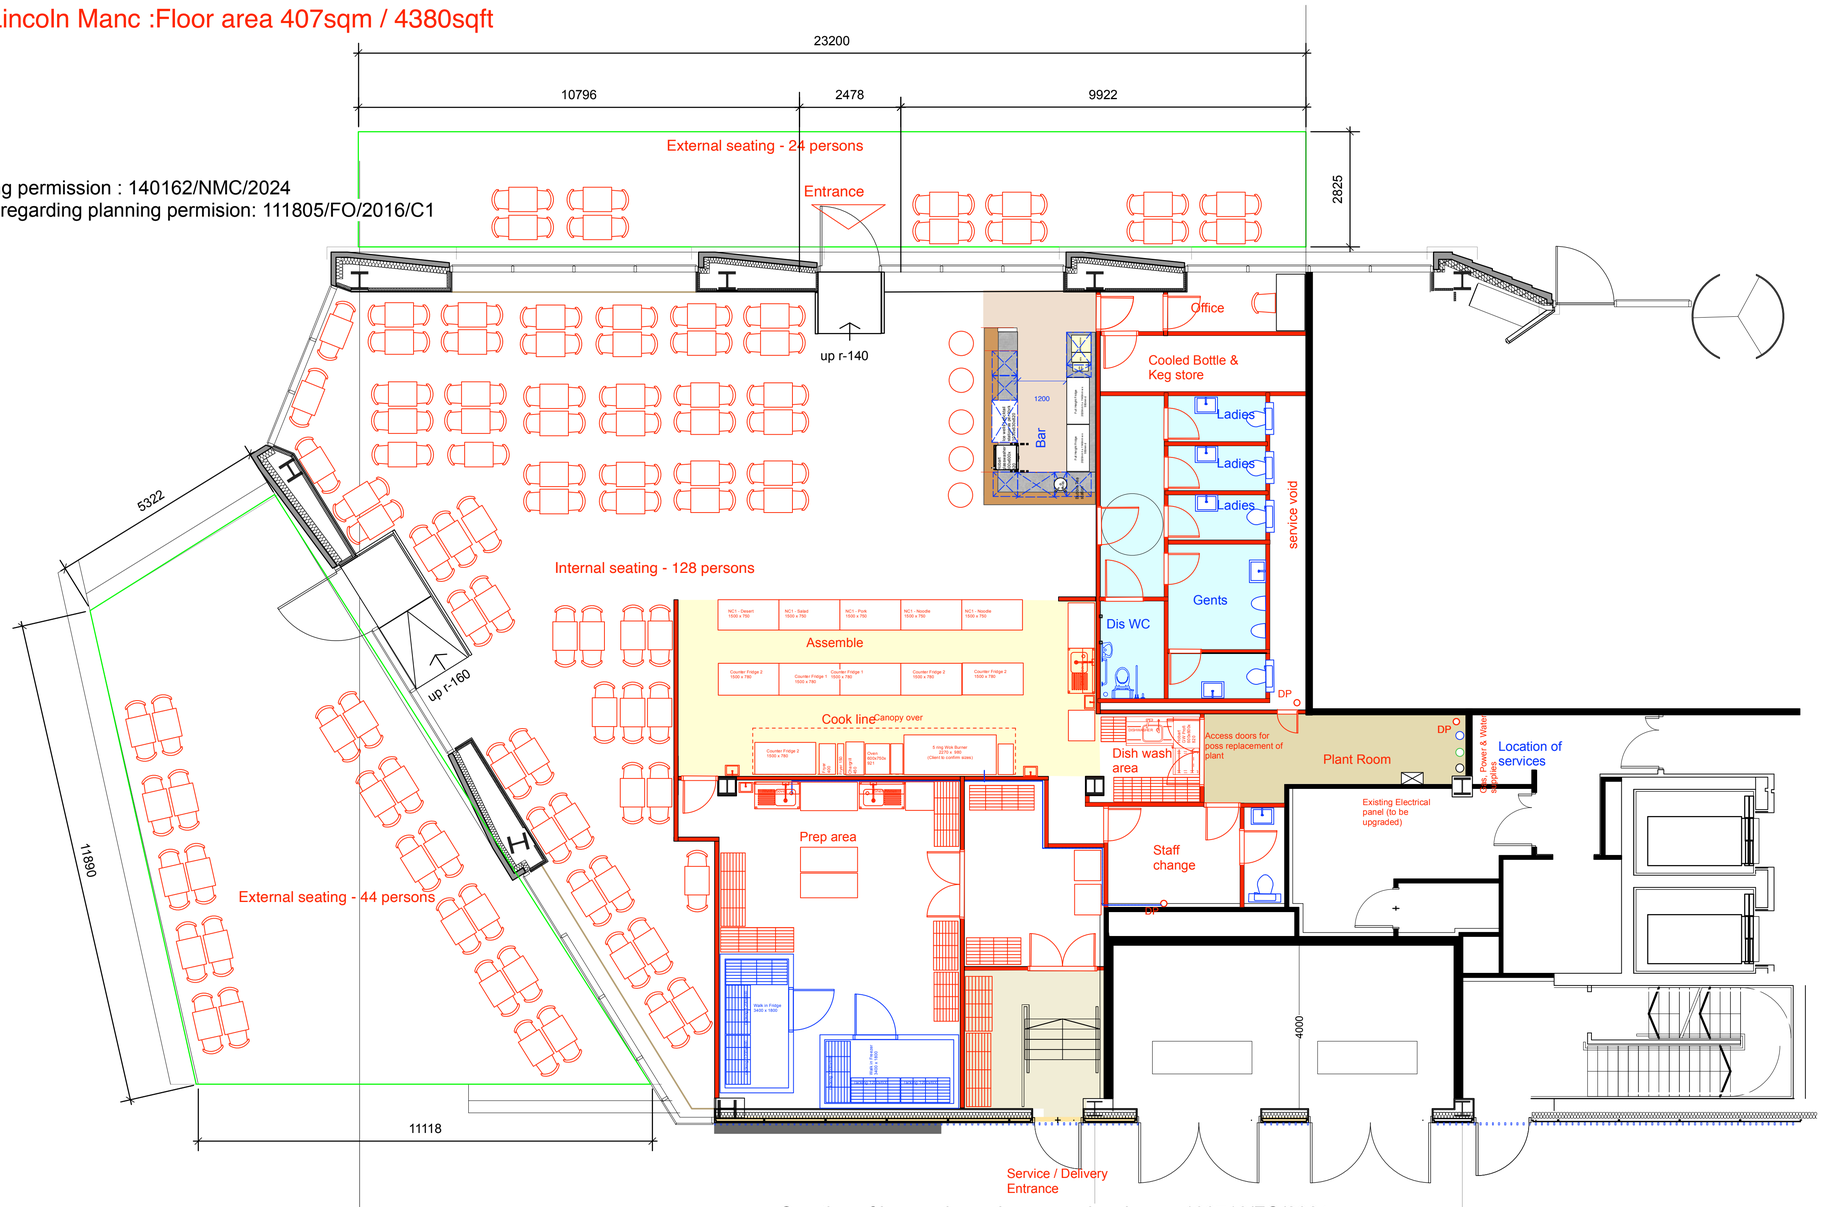

External seating area : CDN/24/0886
Discharge of Conditions 19 External Areas & 29 Hours of opening:
137650/NMC2023 and 140162/NMC/2024
Approved : 16.09.2024

Creation of Louvred panel over service doors : 139718/FO/2024
Approved : 18.06.2024

REVISIONS :

Rev A	15.02.2025	Amended layout following receipt of Acme drawings.
Rev B	23.04.2025	Ramps added and rear store wall amended
Rev C	16.06.2025	As built drwgs

INSPIRE
49 THE TANNERY LAWRENCE STREET YORK YO10 3WH
01904 611091 amanda@inspiredc.co.uk

CLIENT :
ZaaP Restaurants

SITE :
Ground Floor Units 3, The Lincoln, Brazennose Street, Manchester M2 5BP

DRAWING TITLE:
General arrangement

DATE :
March 2024

SCALE :
1:75 @ A1

DRAWING BY :
PS

DRAWING NO :
ZaaP/Manc/101C

CONTRACTORS MUST VERIFY ALL DIMENSIONS ON SITE BEFORE COMMENCING ANY WORK.FIGURED DIMENSIONS TO TAKE PRECEDENCE OVER SCALED DIMENSIONS.THE COPYRIGHT OF THIS DRAWING IS RESERVED.THE DRAWING MUST NOT BE DISCLOSED WITHOUT ANY AUTHORITY.
DO NOT SCALE.