


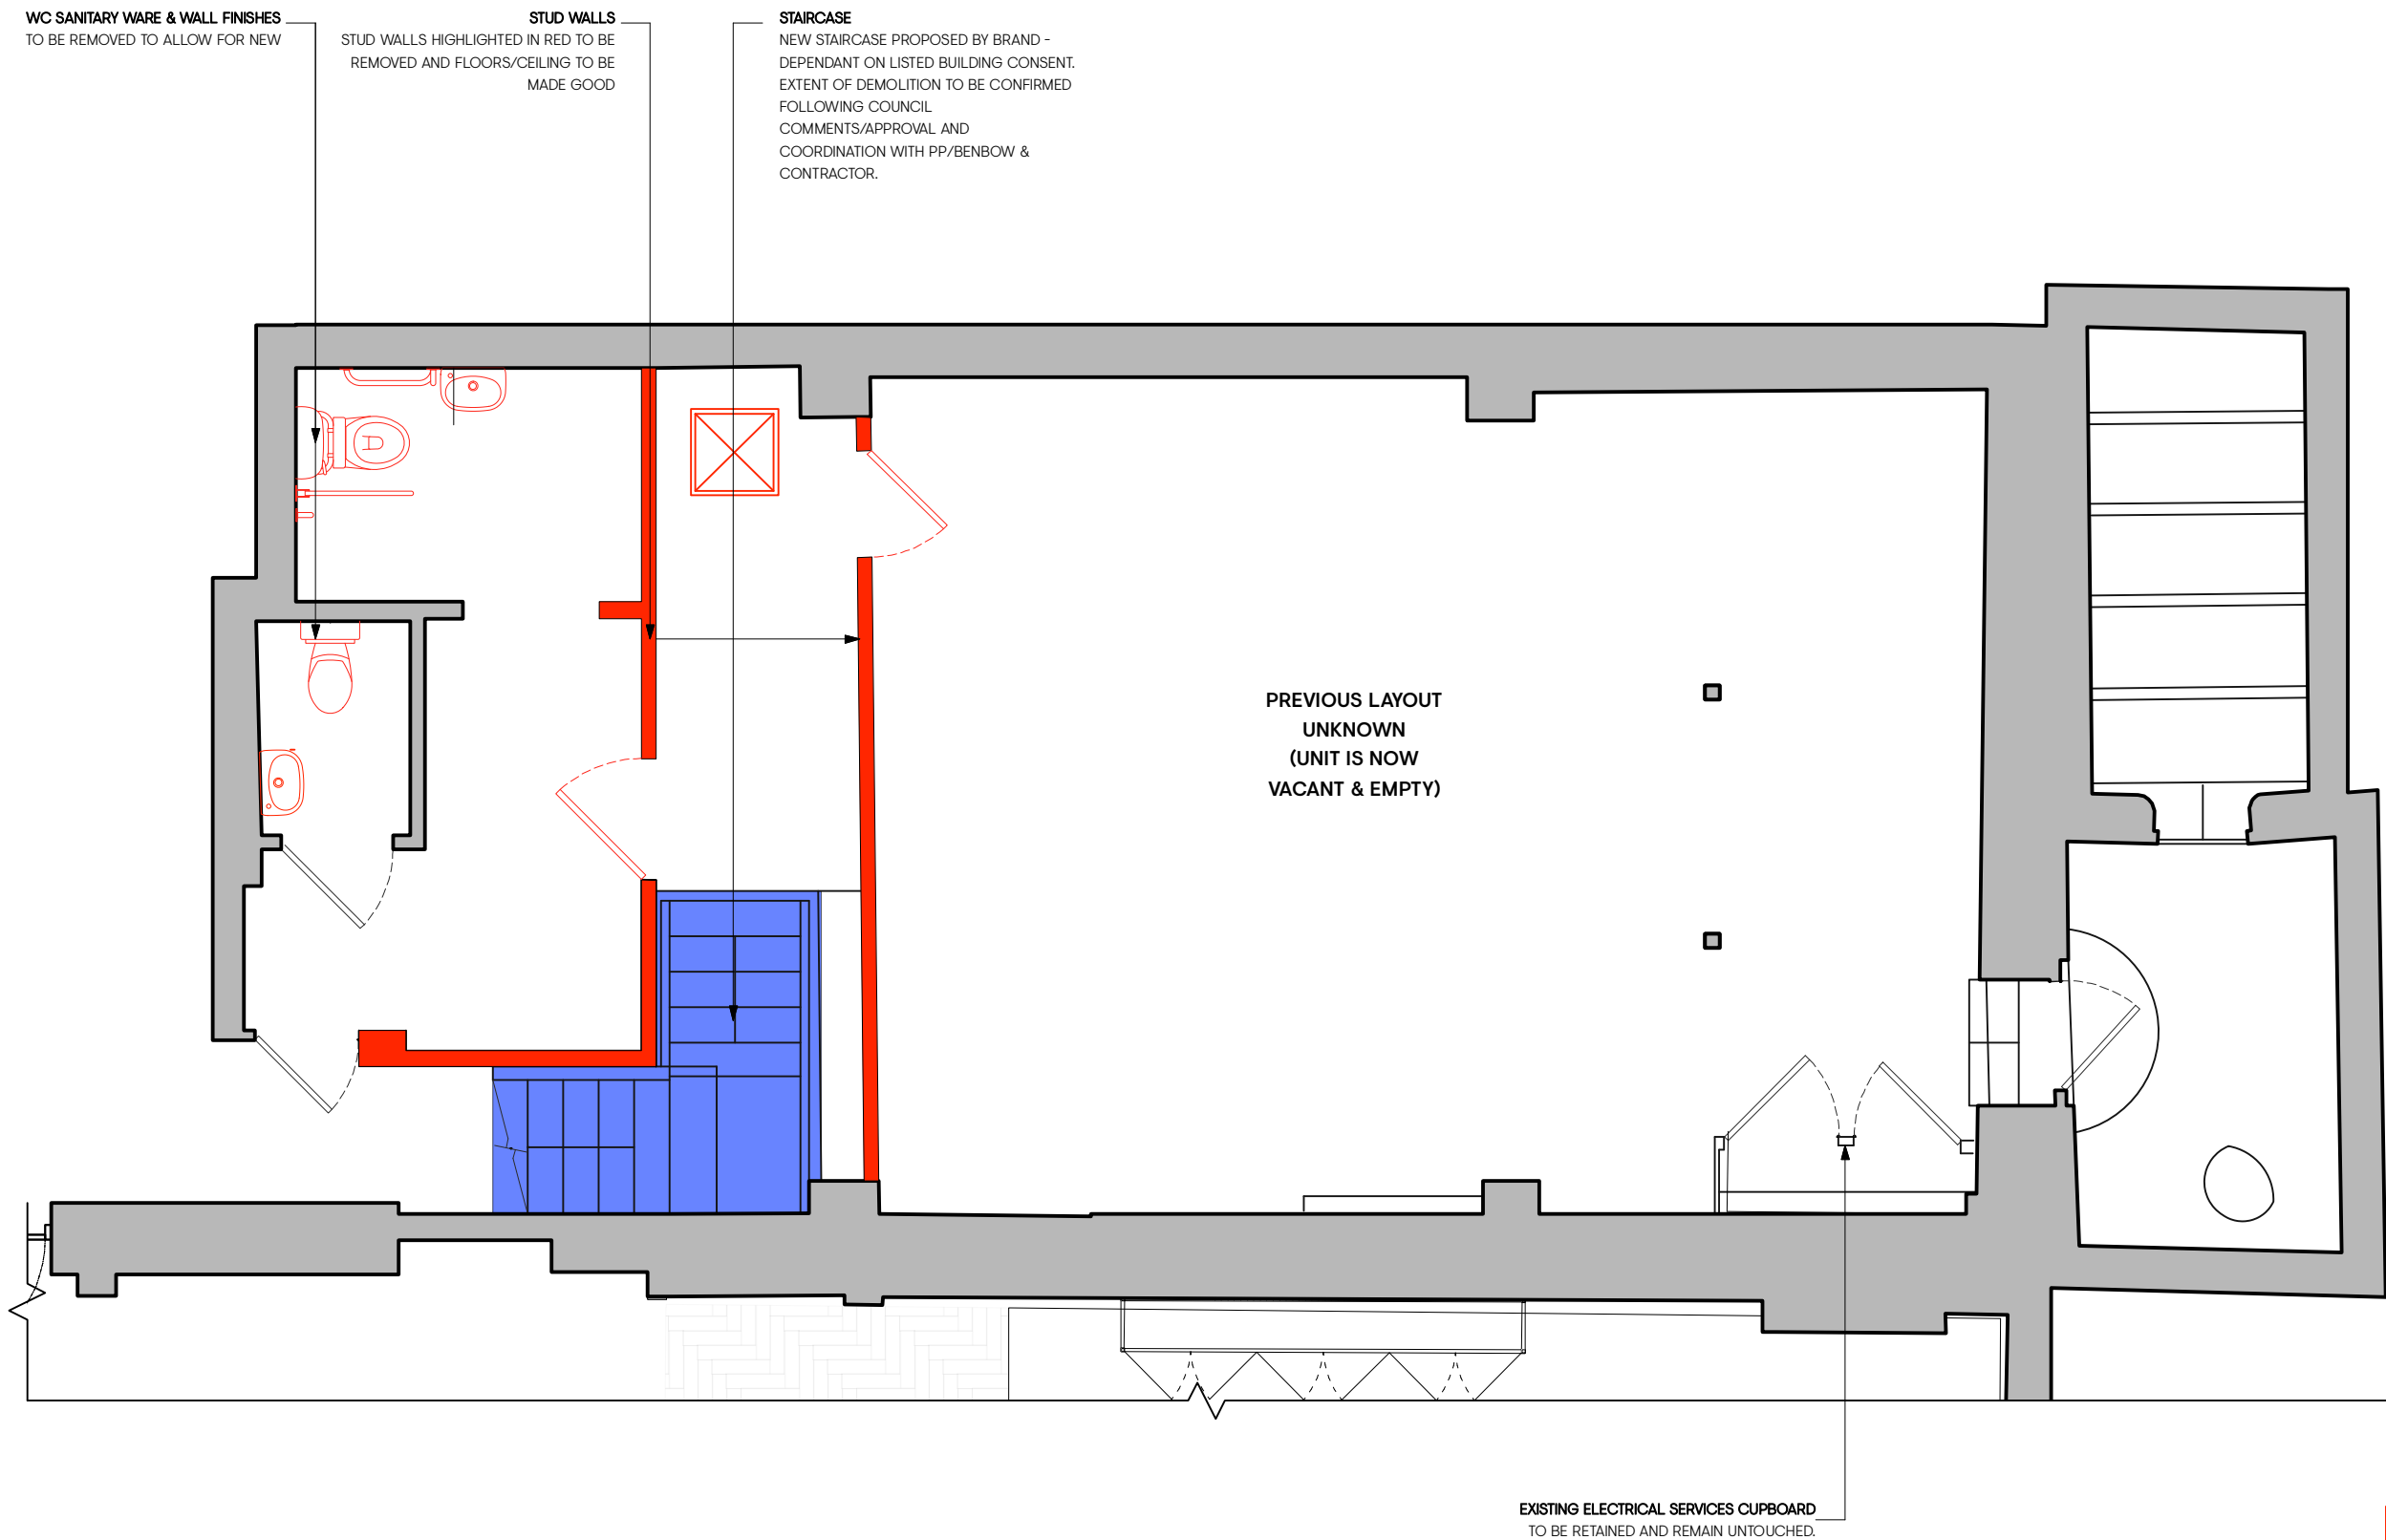

NOTE:
ALL DRAWINGS TO BE COORDINATED WITH
PATEK PHILIPPE & BENBOW
CONSTRUCTION DRAWINGS AND
SPECIFICATIONS.

1 PROPOSED BF WHITEBOX PLAN
SCALE 1:50

gpstudio

6 BLUE LION PLACE, 237 LONG LANE, LONDON SE1 4PU

T+44 (0) 02 1620 1100
www.gpstudio.uk.com

© gpstudio 2025

Disclaimer

This drawing is the property of gpstudio. Copyright is reserved by them and the drawing is issued on the condition that it is not copied, reproduced or disclosed to any unauthorised person, wholly or in part, without the consent in writing of gpstudio. Do not scale from this drawing. All dimensions to be verified prior to manufacture and construction. Any discrepancies to be reported immediately.

PRELIMINARY

© gpstudio 2025 All rights reserved

NOTE:

RED LINE INDICATES ITEMS TO BE REMOVED/
DEMOLISHED.

BLUE LINE INDICATES LISTED BUILDING
ITEMS TO BE RETAINED

BLACK AREAS ARE EXISTING ITEMS TO BE
RETAINED.

NOTES:

DIMENSIONS ARE INDICATIVE ONLY. ALL
DIMENSIONS TO BE CONFIRMED ON SITE.

0 0.5 1 1.5 2 M

SCALE 1:50



Revisions

Client BOODLES X PP
Project MANCHESTER
Site address 17 King St, Manchester M2
6AW

Date 10.04.2025
Scale 1:50

Drawing title

**BF PLAN | PROPOSED
WHITE BOX DEMOLITION**

Project number

1173

Drawing number

114LBC

· A3