
Spring Gardens

King Street

Chancery Lane

Brown Street

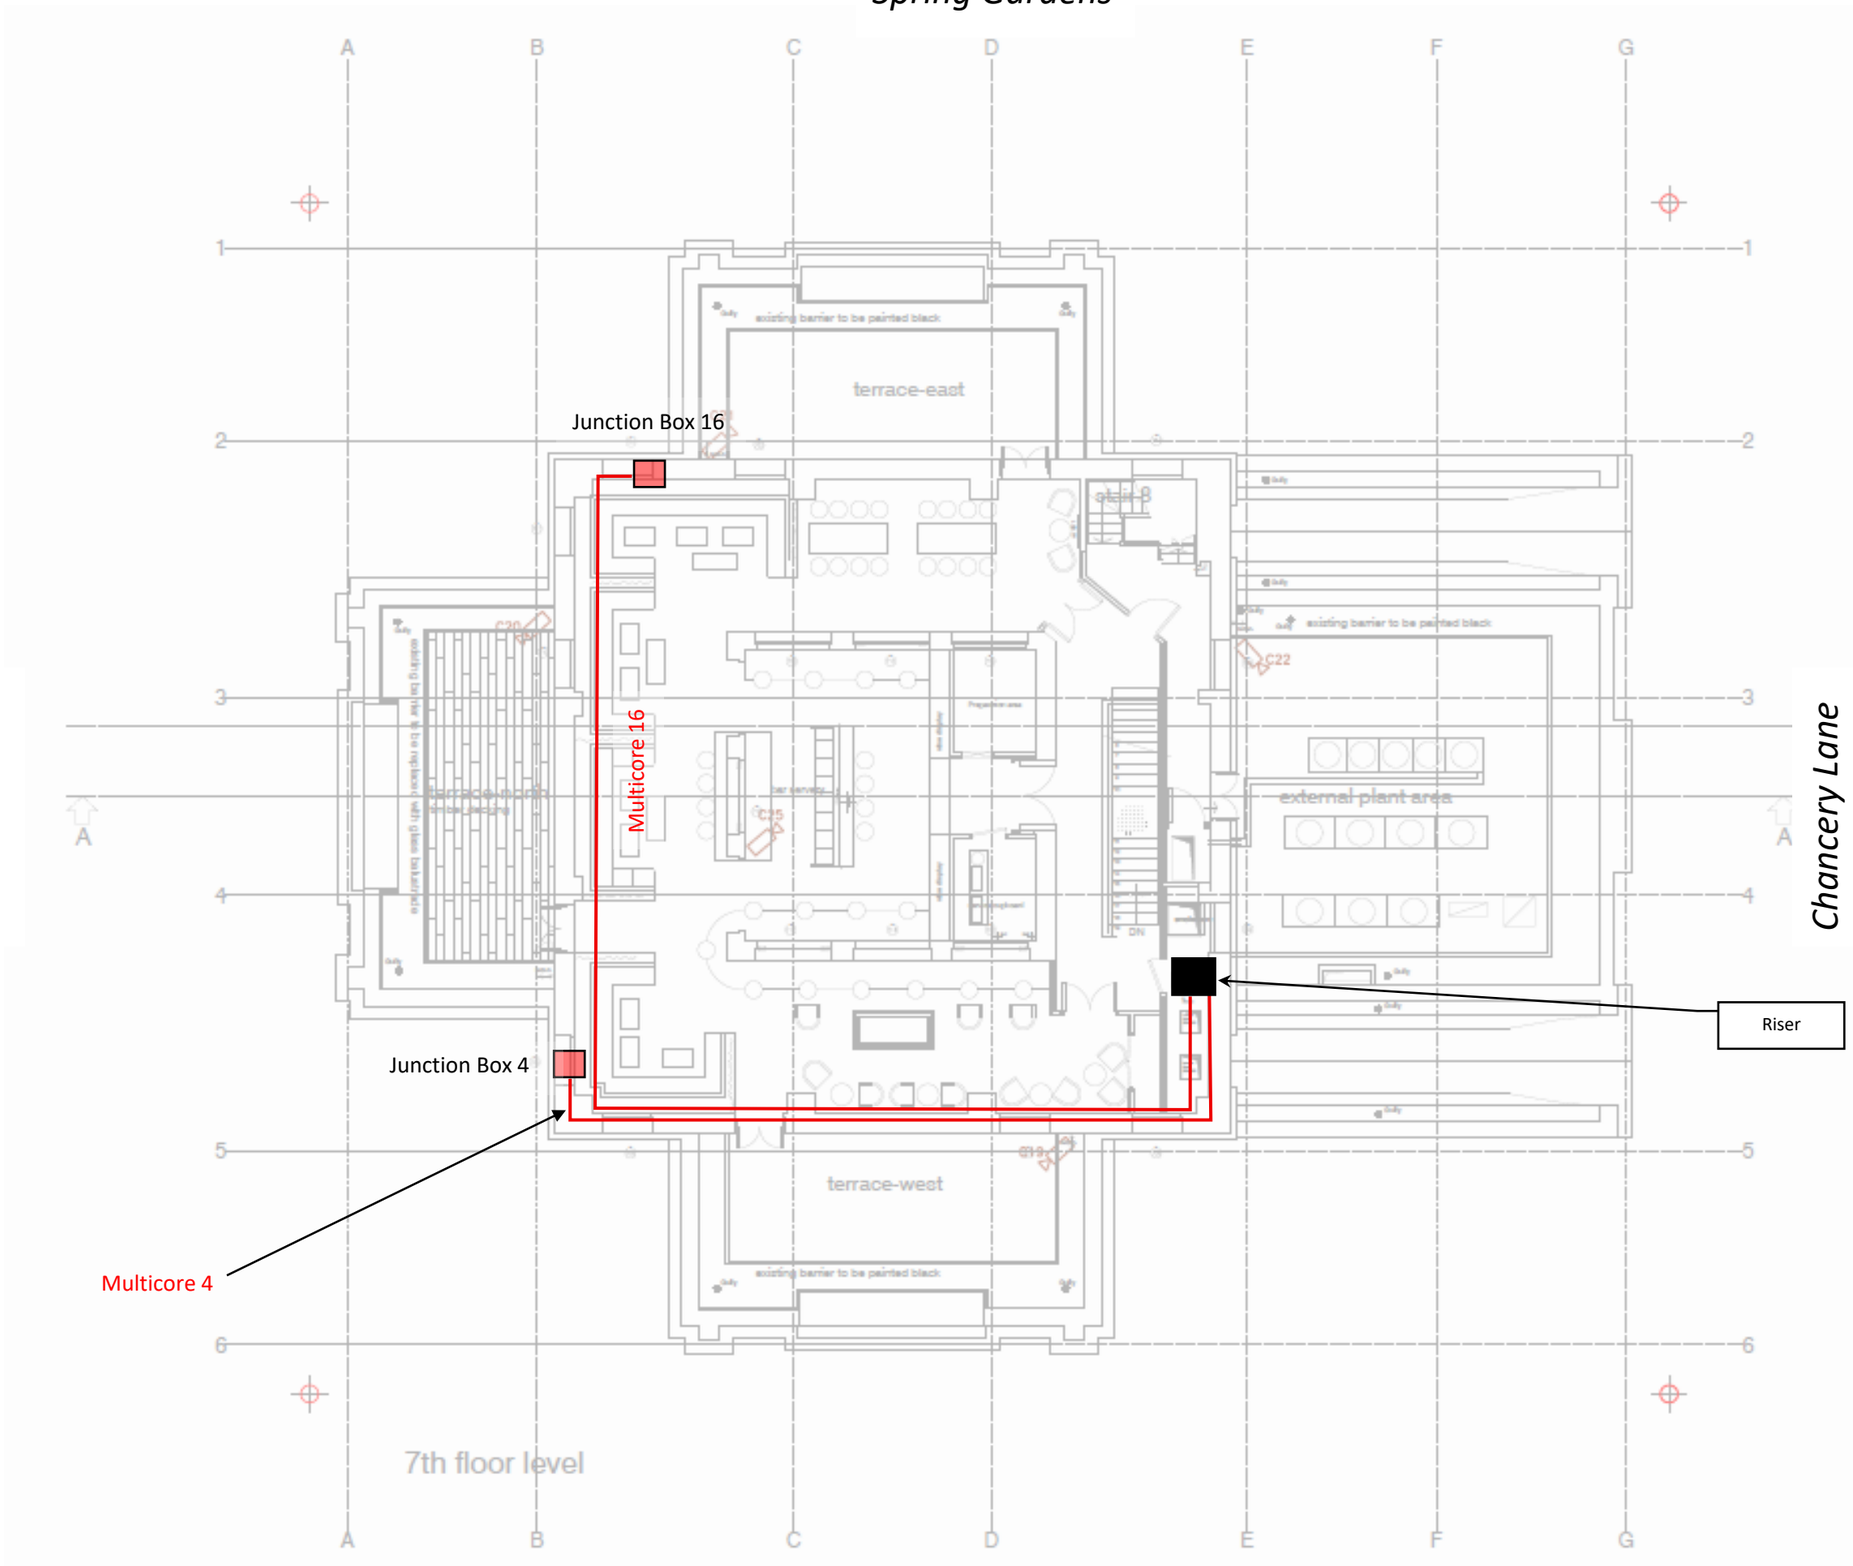

Notes:

1. *Multicore cables and junction boxes fixed to existing exposed cable tray at ceiling level adjacent to building wall.*
2. *Multicore cables fixed to cable tray within riser.*
3. *Field cables transferred locally from junction boxes to wall penetration points via flexible conduit at high level.*
4. *Multicore cables & junction boxes are all extra low voltage DC.*
5. *Internal wiring works are at present incomplete – this drawing shows the completed works as of the date noted.*
6. *Cable routes for Zones 8 and 12 to be determined.*
7.

Revision History [present & previous revision only]

00	Notes: As-built		Date: 19/9/25
	By: E. Cummins	Checked: A. Bashford	
	Notes:		Date:
	By:	Checked:	

Sheet Size:	Scale:	Project Number:
A3	NTS	CN23-016-J837

CORROSION ENGINEERING SOLUTIONS

Unit S1, 64-66 Akeman Street,
Tring, Hertfordshire, HP23 6AF

T: +44 (0) 1442 767 899
E: info@corrosionengineering.co.uk
W: www.corrosionengineering.co.uk

Project:
Hotel Gotham, Cathodic Protection System

Drawing Title:
Internal Cabling Routes – 7th Floor Level

Client:
Marshall Commercial Development Projects

Drawing No.:	Rev:
CN23-016-J837-D033	00