

This drawing is the copyright of LDM Deisgn.
All dimensions to be checked on site.
All levels to be checked on site and refer to Ordnance Survey Datum Newlyn unless alternative datum given.
All errors and omissions to be reported to the Architect prior to commencement.
This drawing must be read in conjunction with the relevant specification clauses.
This drawing must not be used on site unless issued for construction.

Bin screen Systems:

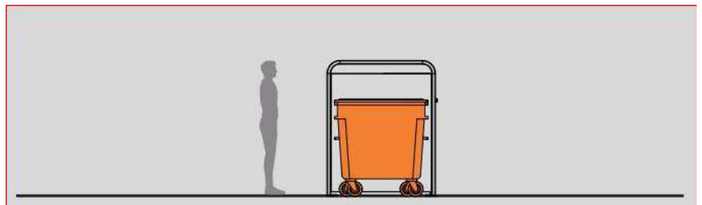


| Model | Number of Bins Stored | Maximum Dimensions (mm) | | |
|---|---|---|---|---|
| | 4-Wheeled Bins | Depth | Width | Height |
| SBRM | 2 | 1620 | 2450 | 1810 |

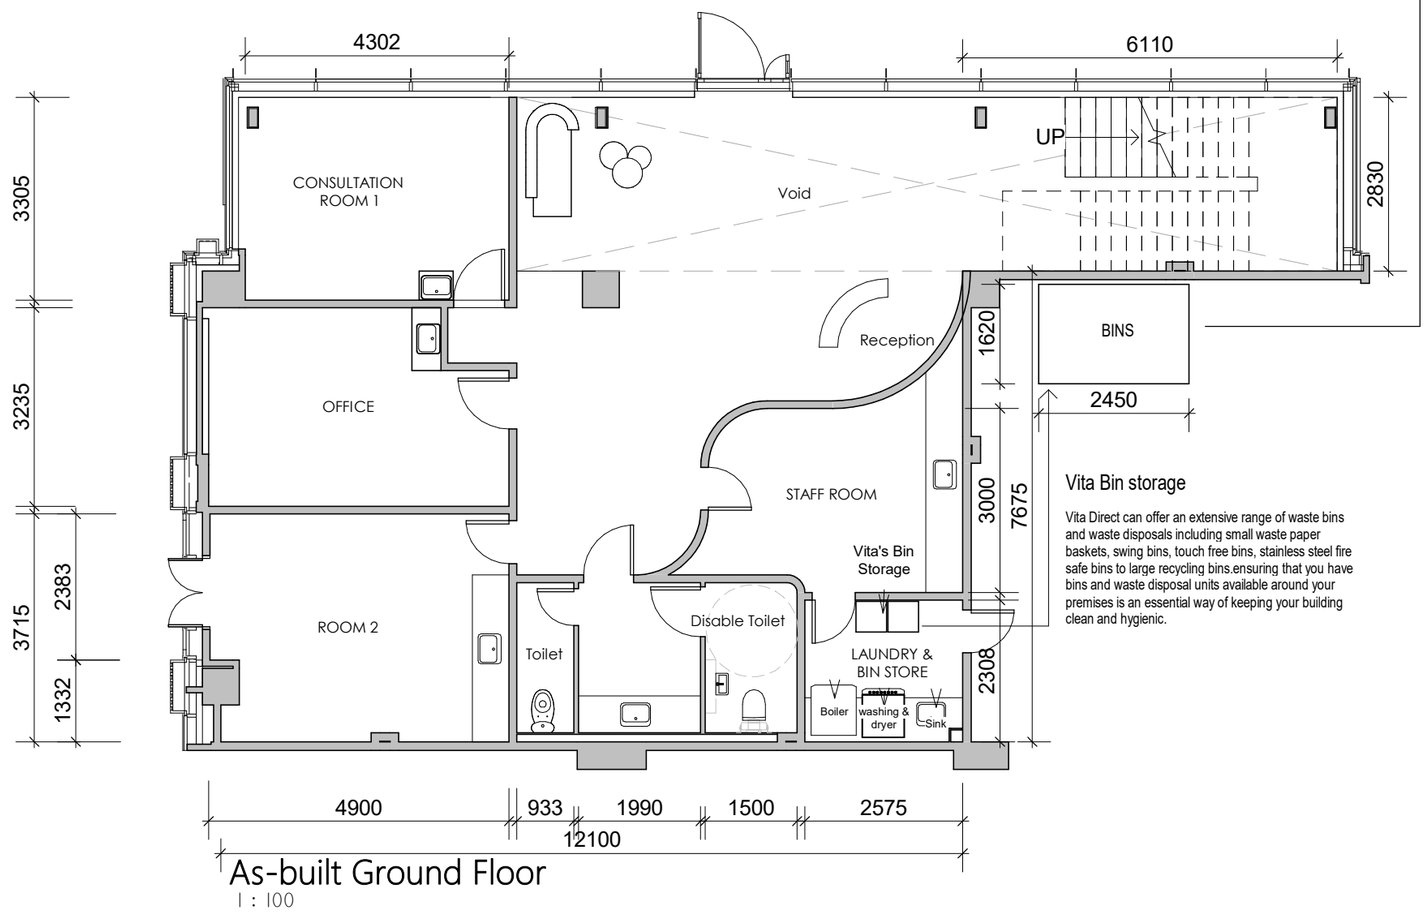



As-built Ground Floor
1 : 100

Vita Bin storage

Vita Direct can offer an extensive range of waste bins and waste disposals including small waste paper baskets, swing bins, touch free bins, stainless steel fire safe bins to large recycling bins.ensuring that you have bins and waste disposal units available around your premises is an essential way of keeping your building clean and hygienic.

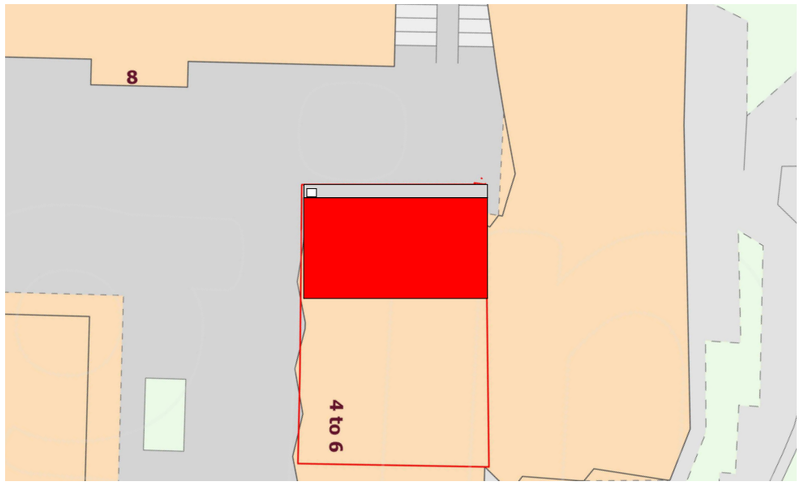


Proposed Site Plan
1 : 500

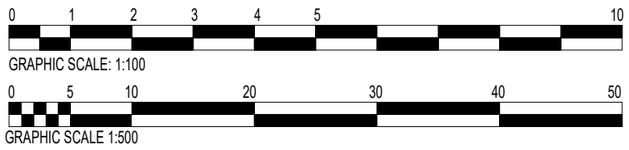


North

# LDM Design

| | |
|---|---|
| PROJECT | Unit L4 Vita East Circle Square 9 Nobel Way Manchester M1 7FT |
| SHEET | Bin Storage Drawing |
| CLIENT | — — — |
| Scale (@ A3) | As indicated |
| Drawn by | BA |
| Checked by | BA |
| DRAWING NUMBER | A3-141 |
| REV | F |