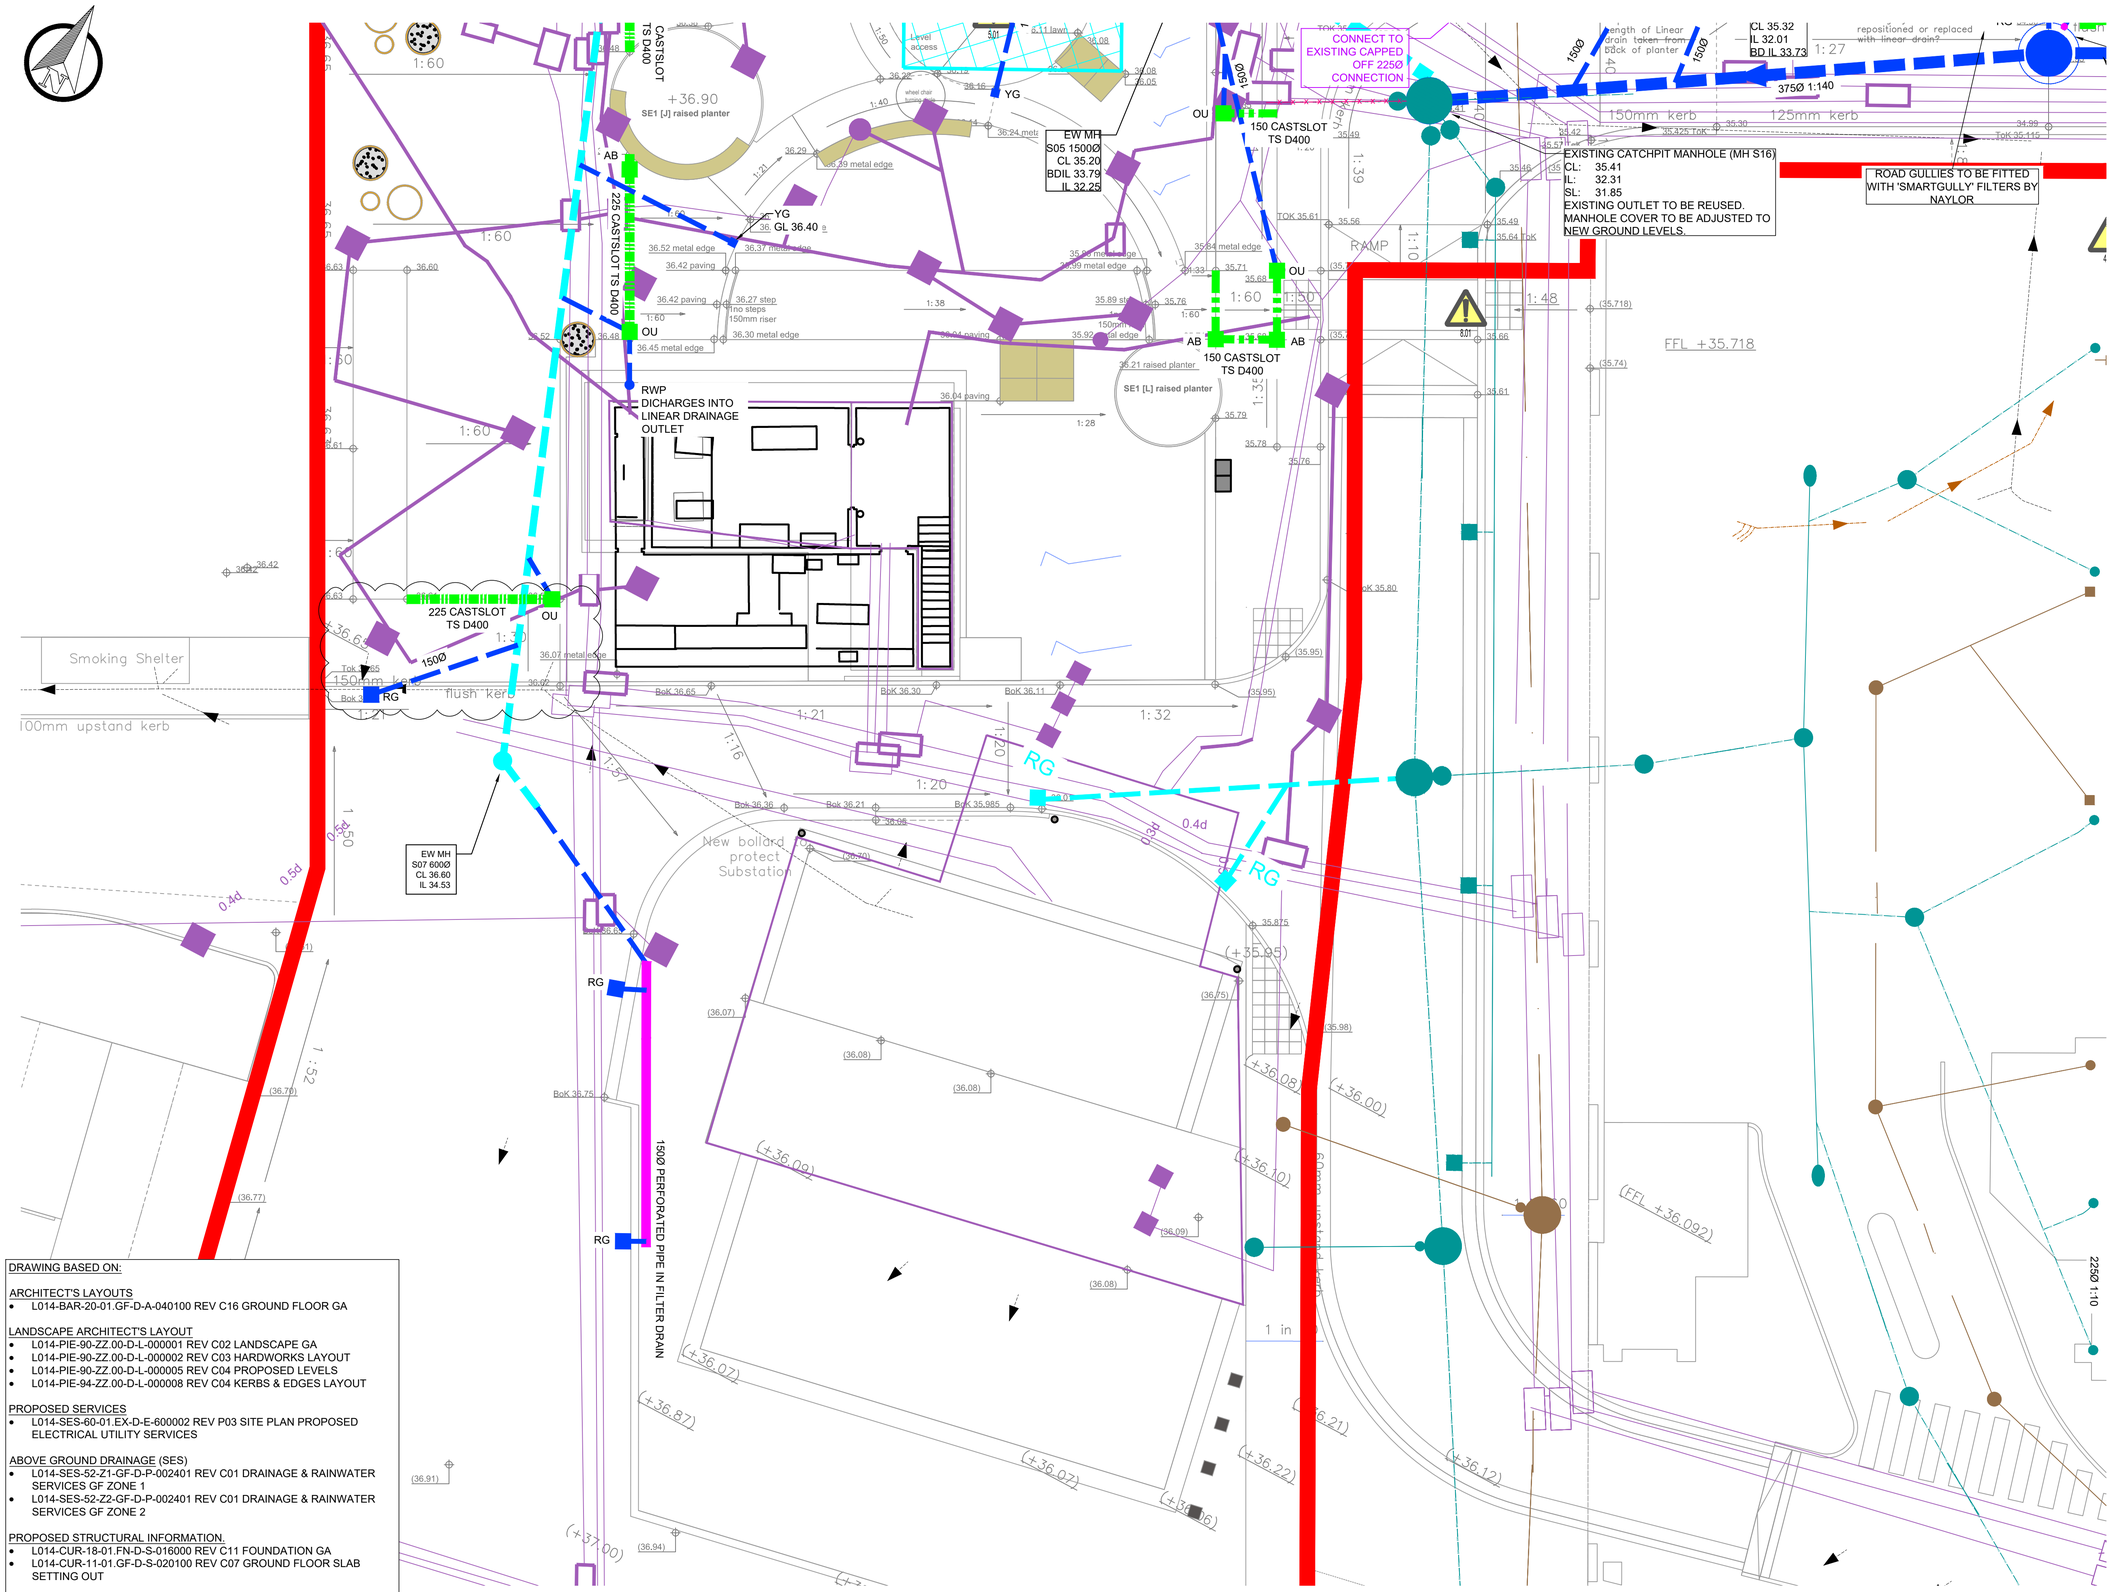


DRAWING BASED ON:

ARCHITECT'S LAYOUTS
- L014-BAR-20-01.GF-D-A-040100 REV C16 GROUND FLOOR GA

LANDSCAPE ARCHITECT'S LAYOUT
- L014-PIE-90-ZZ.00-D-L-000001 REV C02 LANDSCAPE GA
- L014-PIE-90-ZZ.00-D-L-000002 REV C03 HARDWORKS LAYOUT
- L014-PIE-90-ZZ.00-D-L-000005 REV C04 PROPOSED LEVELS
- L014-PIE-94-ZZ.00-D-L-000008 REV C04 KERBS & EDGES LAYOUT

PROPOSED SERVICES
- L014-SES-60-01.EX-D-E-600002 REV P03 SITE PLAN PROPOSED ELECTRICAL UTILITY SERVICES

ABOVE GROUND DRAINAGE (SES)
- L014-SES-52-Z1-GF-D-P-002401 REV C01 DRAINAGE & RAINWATER SERVICES GF ZONE 1
- L014-SES-52-Z2-GF-D-P-002401 REV C01 DRAINAGE & RAINWATER SERVICES GF ZONE 2

PROPOSED STRUCTURAL INFORMATION.
- L014-CUR-18-01.FN-D-S-016000 REV C11 FOUNDATION GA
- L014-CUR-11-01.GF-D-S-020100 REV C07 GROUND FLOOR SLAB SETTING OUT

ENABLING WORKS DRAINAGE
- BEMUS AS BUILT DRAWINGS RECEIVED 23.01.23

PHASE 1A DRAINAGE LAYOUT
- MA1347-70-00-01 C11

PLOT 14 DRAINAGE LAYOUT
- 064428-CUR-FS-XX-DR-C-92500 F01

TOPOGRAPHICAL SURVEY
- 15E146/004 BY SURVEY OPERATIONS RECEIVED AUGUST 2015

3.01 FOR HAZARD TABLE REFER TO DRAWING L014-CUR-52-01.ZZ-D-C-520000

GENERAL NOTES:

1. THIS DRAWING IS TO BE READ IN CONJUNCTION WITH ALL RELEVANT ARCHITECTS AND ENGINEERS DRAWINGS AND SPECIFICATIONS.
2. DO NOT SCALE THIS DRAWING. ANY AMBIGUITIES, OMISSIONS AND ERRORS ON DRAWINGS SHALL BE BROUGHT TO THE ENGINEERS ATTENTION IMMEDIATELY. ALL DIMENSIONS MUST BE CHECKED / VERIFIED ON SITE.
3. ALL DIMENSIONS ARE IN METRES UNLESS NOTED OTHERWISE.
4. FOR GENERAL NOTES REFER TO DRAWING SA-CUR-XX-00-DR-C-92502.
5. FURTHER CO-ORDINATION REQUIRED BETWEEN EXTERNAL SERVICES AND THE PROPOSED DRAINAGE.

KEY:

- PLANNING BOUNDARY TAKEN FROM LANDSCAF ARCHITECTS PLAN L014-PIE-90-ZZ.00-D-L-00000
- EXISTING DRAINAGE
- AS CONSTRUCTED SW DRAINAGE
- AS CONSTRUCTED FOUL DRAINAGE
- PRE-DEVELOPMENT DRAINAGE (ASSUMED ABANDONED - TBC)
- DRAINAGE TO BE ABANDONED/ REMOVED
- ENABLING WORKS DRAINAGE (AS CONSTRCUTED)
- ENABLING WORKS SW DRAINAGE
- ENABLING WORKS PROPOSED CELLULAR ATTENUATION STORAGE
- PROPOSED DRAINAGE
- PROPOSED SW DRAINAGE
- PROPOSED FOUL DRAINAGE
- PROPOSED LINEAR DRAINAGE CHANNEL GATIC CASTSLOT TREADSAFE
- RG ROAD GULLY
- YG YARD GULLY
- TO 100Ø TREE PIT DRAIN/ OUTLET
- SVP FOUL CONNECTION SVP - SOIL VENT PIPE AAV - AIR ADMITTANCE VALVE
- FG FOUL GULLY
- RWP RAINWATER PIPE
- PROPOSED FILTER DRAIN
- PROPOSED FOUNDATION
- CHANGE IN SLAB LEVEL
- PROPOSED EXTERNAL SERVICES

Rev:	Description:	Date:	By:	Chkd:
C02	UPDATED TO LATEST LA PLAN	03.02.25	ATL	HS
C01	CONSTRUCTION ISSUE	15.11.24	ATL	HS
P03	ISSUE TO INCLUDE BEMUS AS BUILT ENABLING WORKS DRAINAGE	16.02.23	CS	CG
P02	ISSUED FOR PLANNING CONDITION DISCHARGE	16.12.22	ATL	CG
P01	ISSUED FOR STAGE 4	18.11.22	ATL	MW

curtins
Merchant Exchange, 17-19 Whitworth Street West, Manchester, M1 5WG
0161 236 2394
manchester@curtins.com
www.curtins.com
Civils & Structures • Transport Planning • Environmental • Infrastructure • Geotechnical • Conservation & Heritage • Principal Designer
Birmingham • Bristol • Cambridge • Cardiff • Douglas • Dublin • Edinburgh • Glasgow • Kendal • Leeds • Liverpool • London • Manchester • Nottingham

Status: STAGE 5

Project: N0 3 CIRCLE SQUARE

Drg Title: PROPOSED DRAINAGE 1:100 LAYOUT SHEET 3

Drawn By	Designed By	Checked By
ATL	ATL	MW
Project No. 080355	Date 23.05.22	Scales @ A1 1:100

Project No - Originator - Function - Spatial - Form - Discipline - Number: L014 - CUR - 52 - 01.ZZ - D - C - 520003

Revision: C02

\\ma-fs-1\Projects\080001 - 081000\080355 - Circle Square Building 3\04-Production\A4-Models-Drawings\CAD\092.