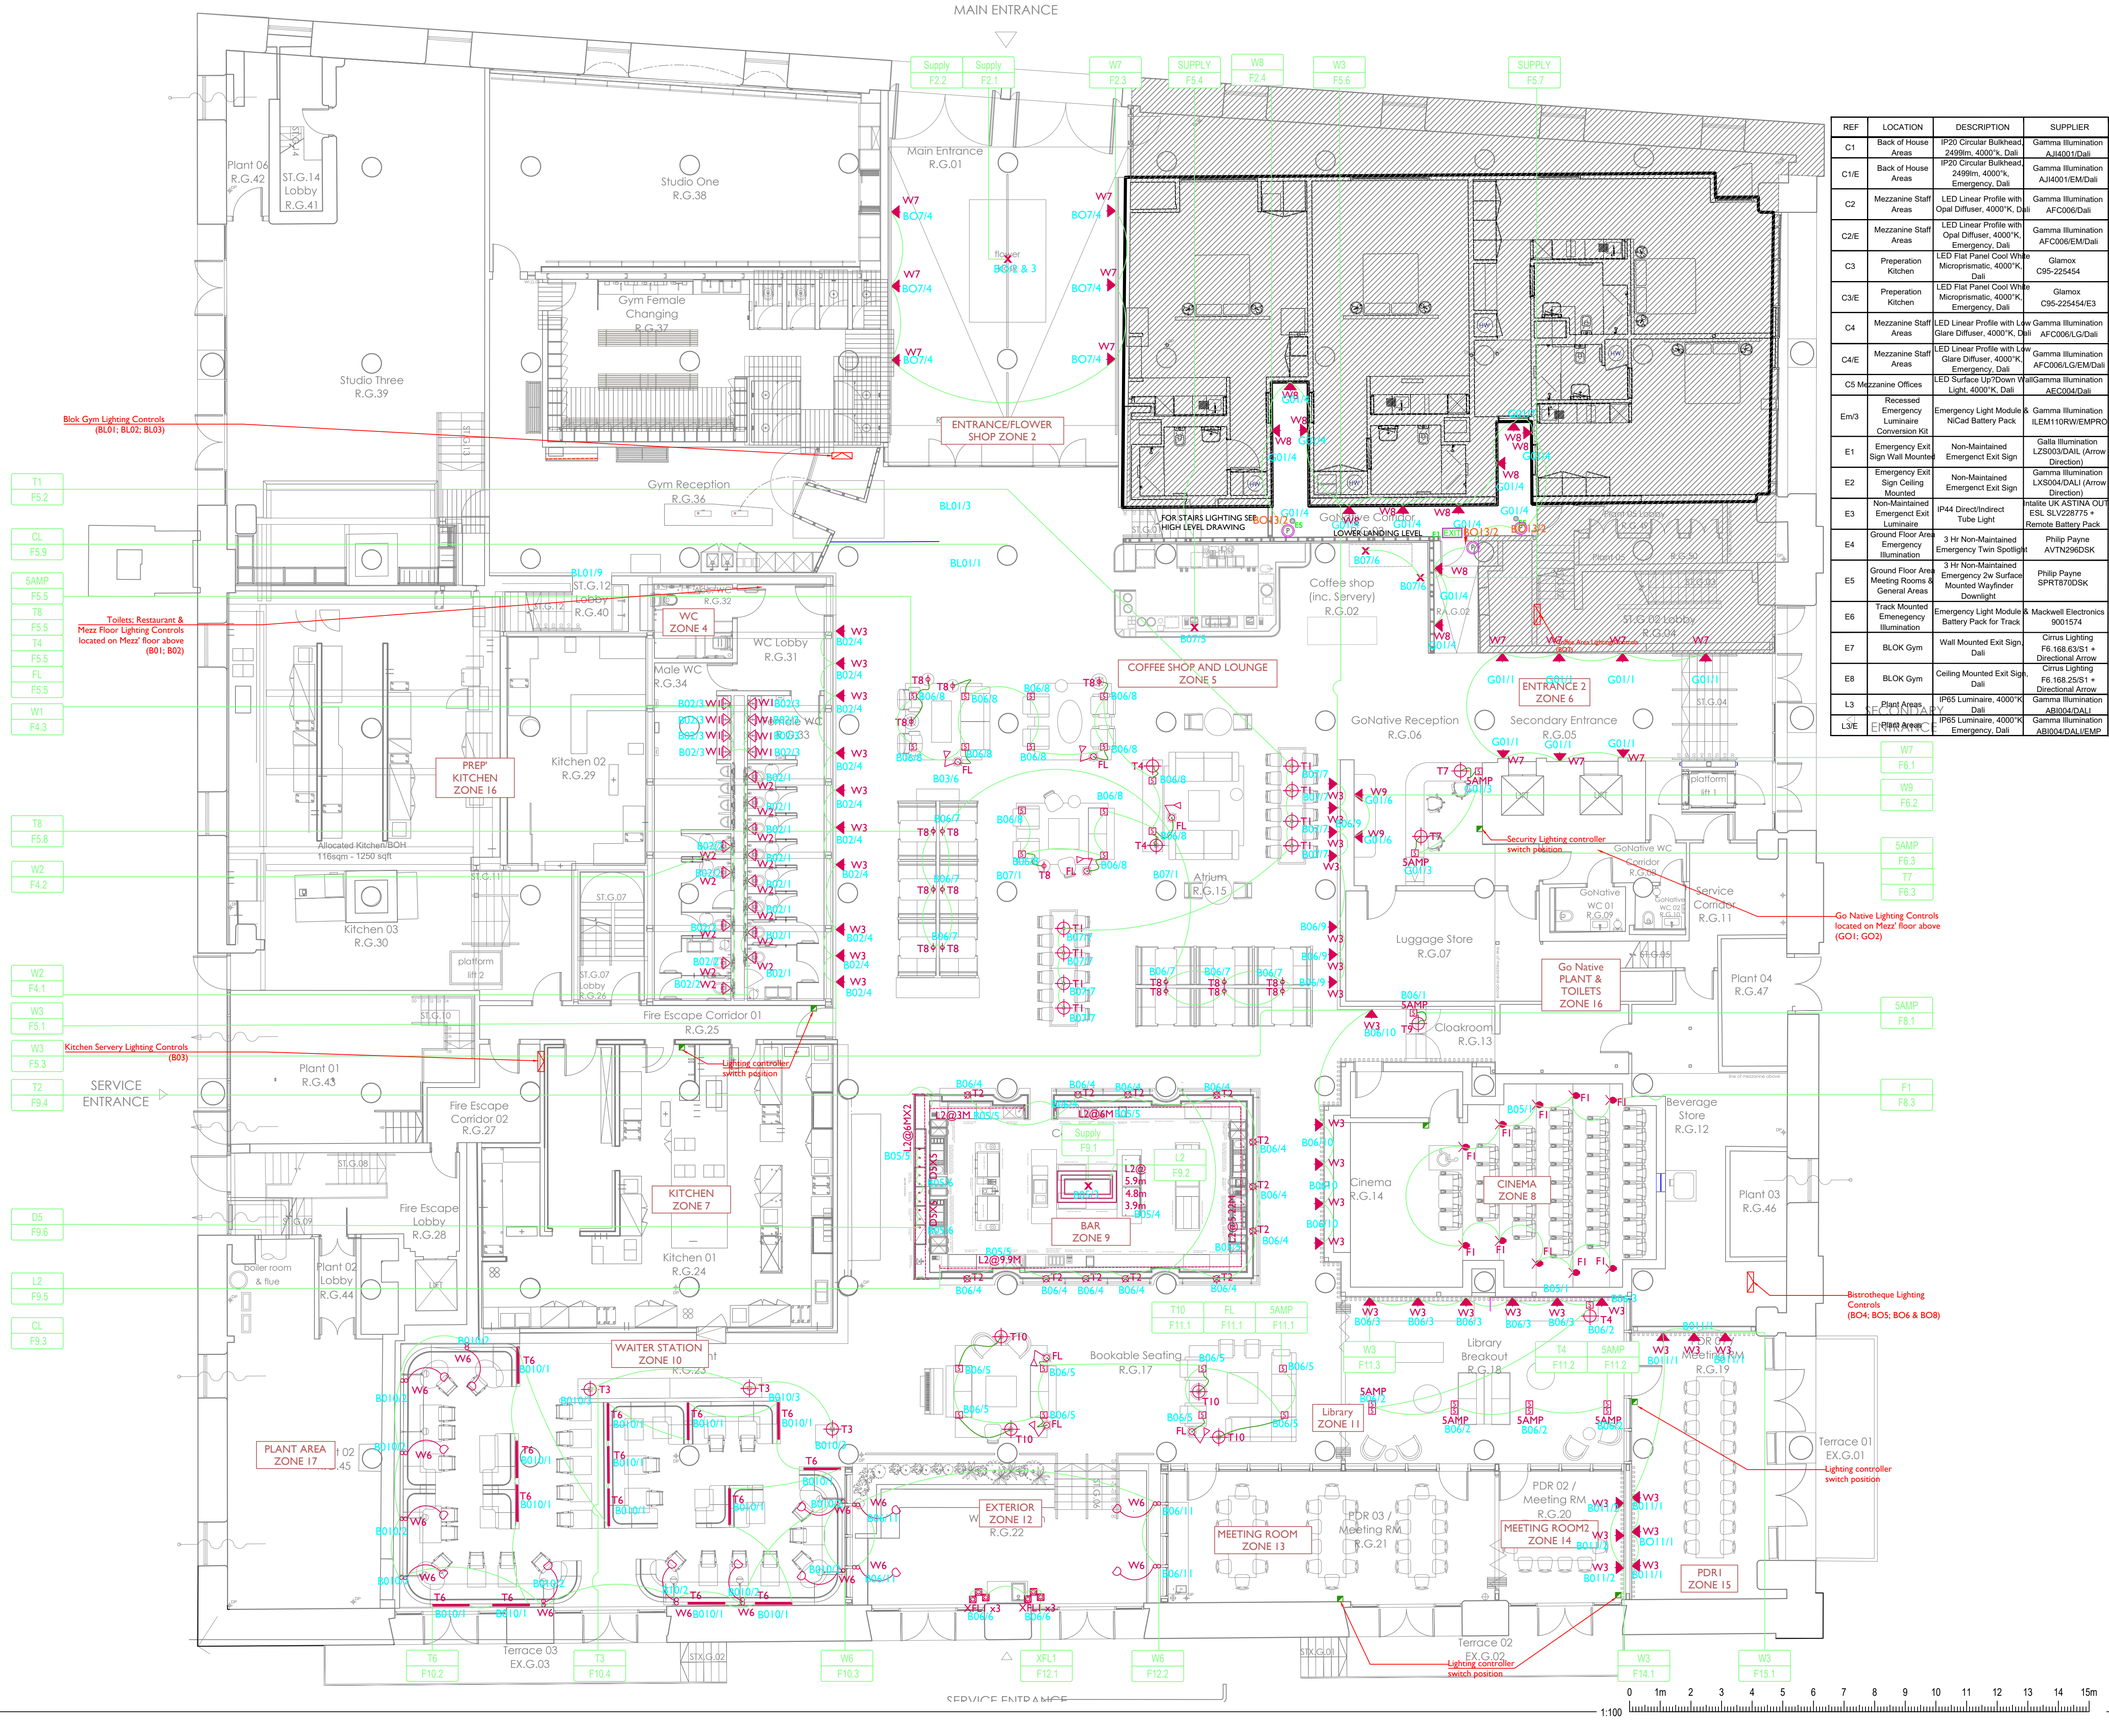

REF	LOCATION	DESCRIPTION	SUPPLIER
C1	Back of House Areas	IP20 Circular Bulkhead, 2499lm, 4000°k, Dali	Gamma Illumination AJI4001/Dali
C1/E	Back of House Areas	IP20 Circular Bulkhead, 2499lm, 4000°k, Emergency, Dali	Gamma Illumination AJI4001/EM/Dali
C2	Mezzanine Staff Areas	LED Linear Profile with Opal Diffuser, 4000°K, Dali	Gamma Illumination AFC006/Dali
C2/E	Mezzanine Staff Areas	LED Linear Profile with Opal Diffuser, 4000°K, Emergency, Dali	Gamma Illumination AFC006/EM/Dali
C3	Preperation Kitchen	LED Flat Panel Cool White Microprismatic, 4000°K, Dali	Glamox C95-225454
C3/E	Preperation Kitchen	LED Flat Panel Cool White Microprismatic, 4000°K, Emergency, Dali	Glamox C95-225454/E3
C4	Mezzanine Staff Areas	LED Linear Profile with Low Glare Diffuser, 4000°K, Dali	Gamma Illumination AFC006/LG/Dali
C4/E	Mezzanine Staff Areas	LED Linear Profile with Low Glare Diffuser, 4000°K, Emergency, Dali	Gamma Illumination AFC006/LG/EM/Dali
C5	Mezzanine Offices	LED Surface Up?Down Wall Light, 4000°K, Dali	Gamma Illumination AEC004/Dali
Em/3	Recessed Emergency Luminaire Conversion Kit	Emergency Light Module & NiCad Battery Pack	Gamma Illumination ILEM110RW/EMPRO
E1	Emergency Exit Sign Wall Mounted	Non-Maintained Emergencet Exit Sign	Gallia Illumination LZS003/DAIL (Arrow Direction)
E2	Emergency Exit Sign Ceiling Mounted	Non-Maintained Emergencet Exit Sign	Gamma Illumination LXS004/DALI (Arrow Direction)
E3	Non-Maintained Emergencet Exit Luminaire	IP44 Direct/Indirect Tube Light	ntalite UK ASTINA OUT ESIL SLV228775 + Remote Battery Pack
E4	Ground Floor Area Emergency Illumination	3 Hr Non-Maintained Emergency Twin Spotlight	Philip Payne AVTN296DSK
E5	Ground Floor Area Meeting Rooms & General Areas	3 Hr Non-Maintained Emergency 2w Surface Mounted Wayfinder Downlight	Philip Payne SPRT870DSK
E6	Track Mounted Emenegency Illumination	Emergency Light Module & Battery Pack for Track	Mackwell Electronics 9001574
E7	BLOK Gym	Wall Mounted Exit Sign, Dali	Cirrus Lighting F6.168.63/S1 + Directional Arrow
E8	BLOK Gym	Ceiling Mounted Exit Sign, Dali	Cirrus Lighting F6.168.25/S1 + Directional Arrow
L3	Plant Areas	IP65 Luminaire, 4000°K Dali	Gamma Illumination ABI004/DALI
L3/E	Plant Areas	IP65 Luminaire, 4000°K Emergency, Dali	Gamma Illumination ABI004/DALI/EMP

GENERAL NOTES

1. Please note that this is an A1 drawing.
2. No responsibility can be accepted in error of scaling from this drawing by others. All measurements should be taken from figured dimensions and checked on site.

Luminaires

CL		Pendant- Column mounted
D3		Fixed miniature LED Downlight.
D4		Kitchen Downlight.
D5		Bar Downlight.
FI		Wall recessed steplight_Cinema.
L1		LED 10W/M
L2		LED 10W/M- IP rated.
P1		Pendant- Restaurant.
P3		Pendant- Bar studio.
P4		Pendant- Changing rooms.
S1		Spotlight on long stem.
S2		Spotlight to beams.
T1		Custom Table lamp
T2		Table lamp- Bar Table Lamp.
T3		Table lamp- Waiter station.
T4		Table lamp- Lounge/ Library.
T6		Table lamp- Waiter station.
T7		Table lamp- Reception Desk.
T8		Table lamp- Lounge
T9		Table lamp- Cloakroom.
T10		Table lamp- Seating area.
W1		Decorative Wall Light- Mirror.
W2		Decorative Wall Light- WC.
W3		Decorative Wall Light- Wood panel.
W6		Decorative Wall Light- Mirror.
W7		Decorative Wall Light- Lift lobby.
W8		Decorative Wall Light- Corridors.
W9		Decorative Wall Light- Reception.
XFL1		Exterior Floor Lantern.

Electrical

	5Amp wall socket
	5Amp floor socket
X	Supply for future lighting

Controls

	Local Control Plate

FOR HEIGHT & SETTING OUT OF WALL MOUNTED LUMINAIRES, SEE AHA'S DRAWING.

Emergency lights feed from the live side of the local circuit and connected to the Dali loop indicated.

Rev	Description	Drawn By	Chk By	Date
A1	AS INSTALLED			

Drawing Status: AS INSTALLED

TNA

TNA Electrical Limited
Unit 13 Heritage Park, Hayes Way,
Cannock, Staffordshire, WS11 7LT.
Telephone: 01543 425 349
email: enquiries@tnaelectrical.co.uk
website: www.tnaelectrical.co.uk

Project.
THE LONDON WAREHIOUSE MANCHESTER

Title.
GROUND FLOOR LOW LEVEL LIGHTING LAYOUT

Architect.	ARCHER HUMPHRYES		
Consultant	THE ANSLOW PARTNERSHIP		
Designer. eds	Project Manager. RG	CAD. eds	Checked.
Date. Jan' 2019	Cad File.		Scale. 1:100 A1
Enquiry No.		Contract No.	E266
Drawing No.	TNA/E200-L	Rev.	A1