


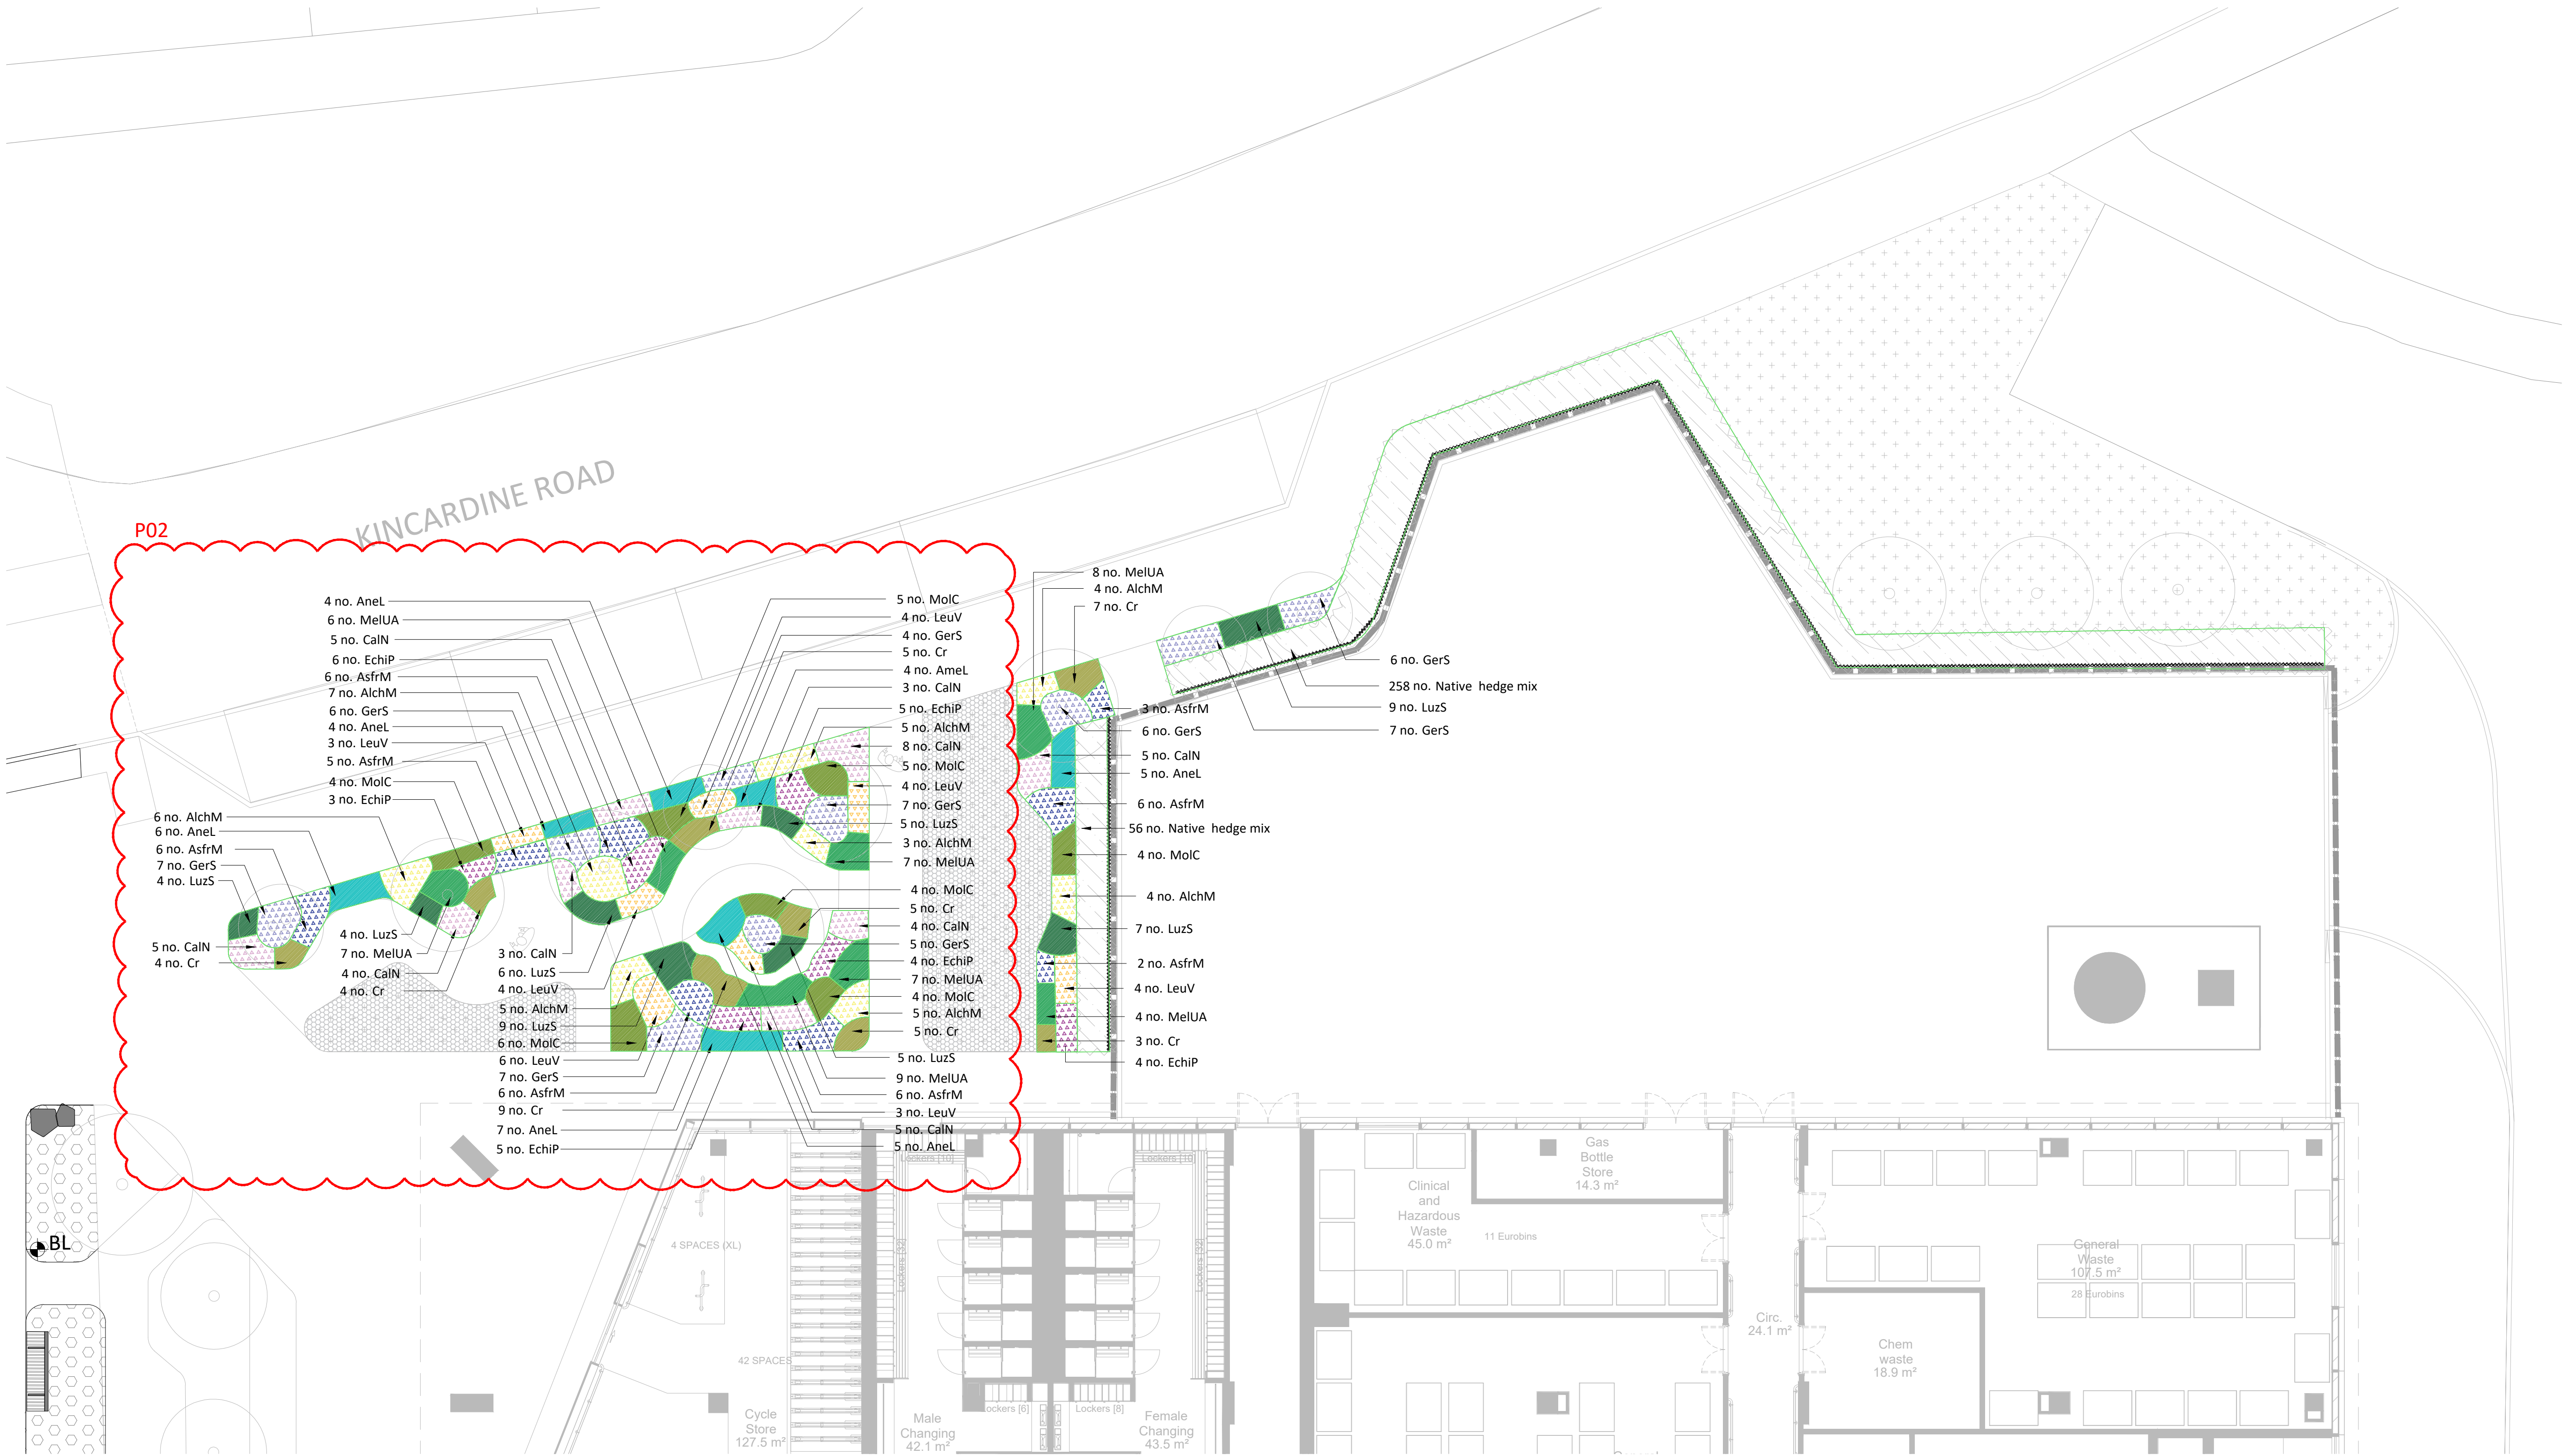

- Notes**
1. All dimensions in mm, unless otherwise stated.
 2. Scaling from drawing if printed incorrectly may lead to errors.
 3. All information outside red line boundary shown for contextual purpose only.
 4. All hatch patterns are indicative only unless stated otherwise.
 5. This drawing is to be read in conjunction with the remaining re-form landscape architecture documentation AND all relevant documentation from the design team
 6. Levels information on this drawing illustrates the design intent. The contractor is to check and verify all levels and dimensions against site survey information.
 7. Any discrepancies in the design information are to be brought to the attention of re-form landscape architecture, in writing, prior to commencement of construction works.
 8. All proprietary products shall be installed in strict accordance with manufacturers written instructions.
 9. Refer to other consultants' drawings and specifications for the following design information:
 - Foundation details
 - Base course and/or sub bases design & specification
 - Waterproofing of any element
 - Drainage design and infrastructure
 - Lighting and ducting
 - Existing & proposed utilities
 10. Plant quantities are to suit site areas in accordance with scheduled plant densities.
 11. Any proposed plant substitution shall be agreed with the landscape architect prior to ordering.

Planting Mix 3- Kincardine Road Play Routes

Code	Name	Height (cm)	Min. container size (Litres)	Density	Qty
AlchM	Alchemilla mollis	40-50	5L	5/m²	39
AsfrM	Aster x frikartii 'Monch'	40-50	5L	5/m²	40
CalN	Calamintha nepeta*	30-40	5L	5/m²	42
Anel	Anemanthele lessoniana	40-50	5L	5/m²	35
Cr	Carex remota*	40-50	5L	7/m²	42
EchiP	Echinacea pallida	70-90	5L	5/m²	27
GerS	Geranium sanguineum*	20-30	5L	5/m²	55
MelUA	Melica uniflora f. albida*	30-40	5L	7/m²	48
LeuV	Leucanthemum vulgare*	40-50	5L	5/m²	28
LuzS	Luzula sylvatica*		5L	7/m²	49
MolC	Molinia caerulea*	80-90cm	5L	5/m²	28
Bulb Planting (to be planted alongside with grasses)					
	Colchicum autumnale*	10-20	N/A	2/m²	64

* Native species

Native Hedgerow Planting

Mix %	Name	Height (cm)	Min. container size (Litres)	Density	Qty
30%	Corylus avellana*	100-120	BR		94
20%	Euonymus europaeus*	100-120	BR	6 per linear meter in double staggered row	63
20%	Ilex aquifolium*	80-100	C 10L		63
15%	Prunus spinosa*	100-120	BR		47
15%	Rosa canina*	80-100	BR		47

* Native species

19.06.25	Project code changed to UBS	MSz	MS	DL	P03
Date	Description of revision	Drawn by	Checked by	Approved by	Revision

re-form
landscape architecture

W: re-formlandscape.com
E: info@re-formlandscape.com
T: Edinburgh +44 (0)131 354 1876
Leeds +44 (0)113 245 4695
Manchester +44 (0)161 397 4953

Project
UPPER BROOK STREET, MANCHESTER
RF22-968

Client
KADANS

Document title
DETAILED PLANTING PLAN
SHEET 03 OF 03

Paper size
A1
Scale
1:100

Status
FOR STAGE APPROVAL
S4

Drawing number
UBS-RFM-XX-00-DR-L-0109
Revision
P03

© re-form landscape architecture