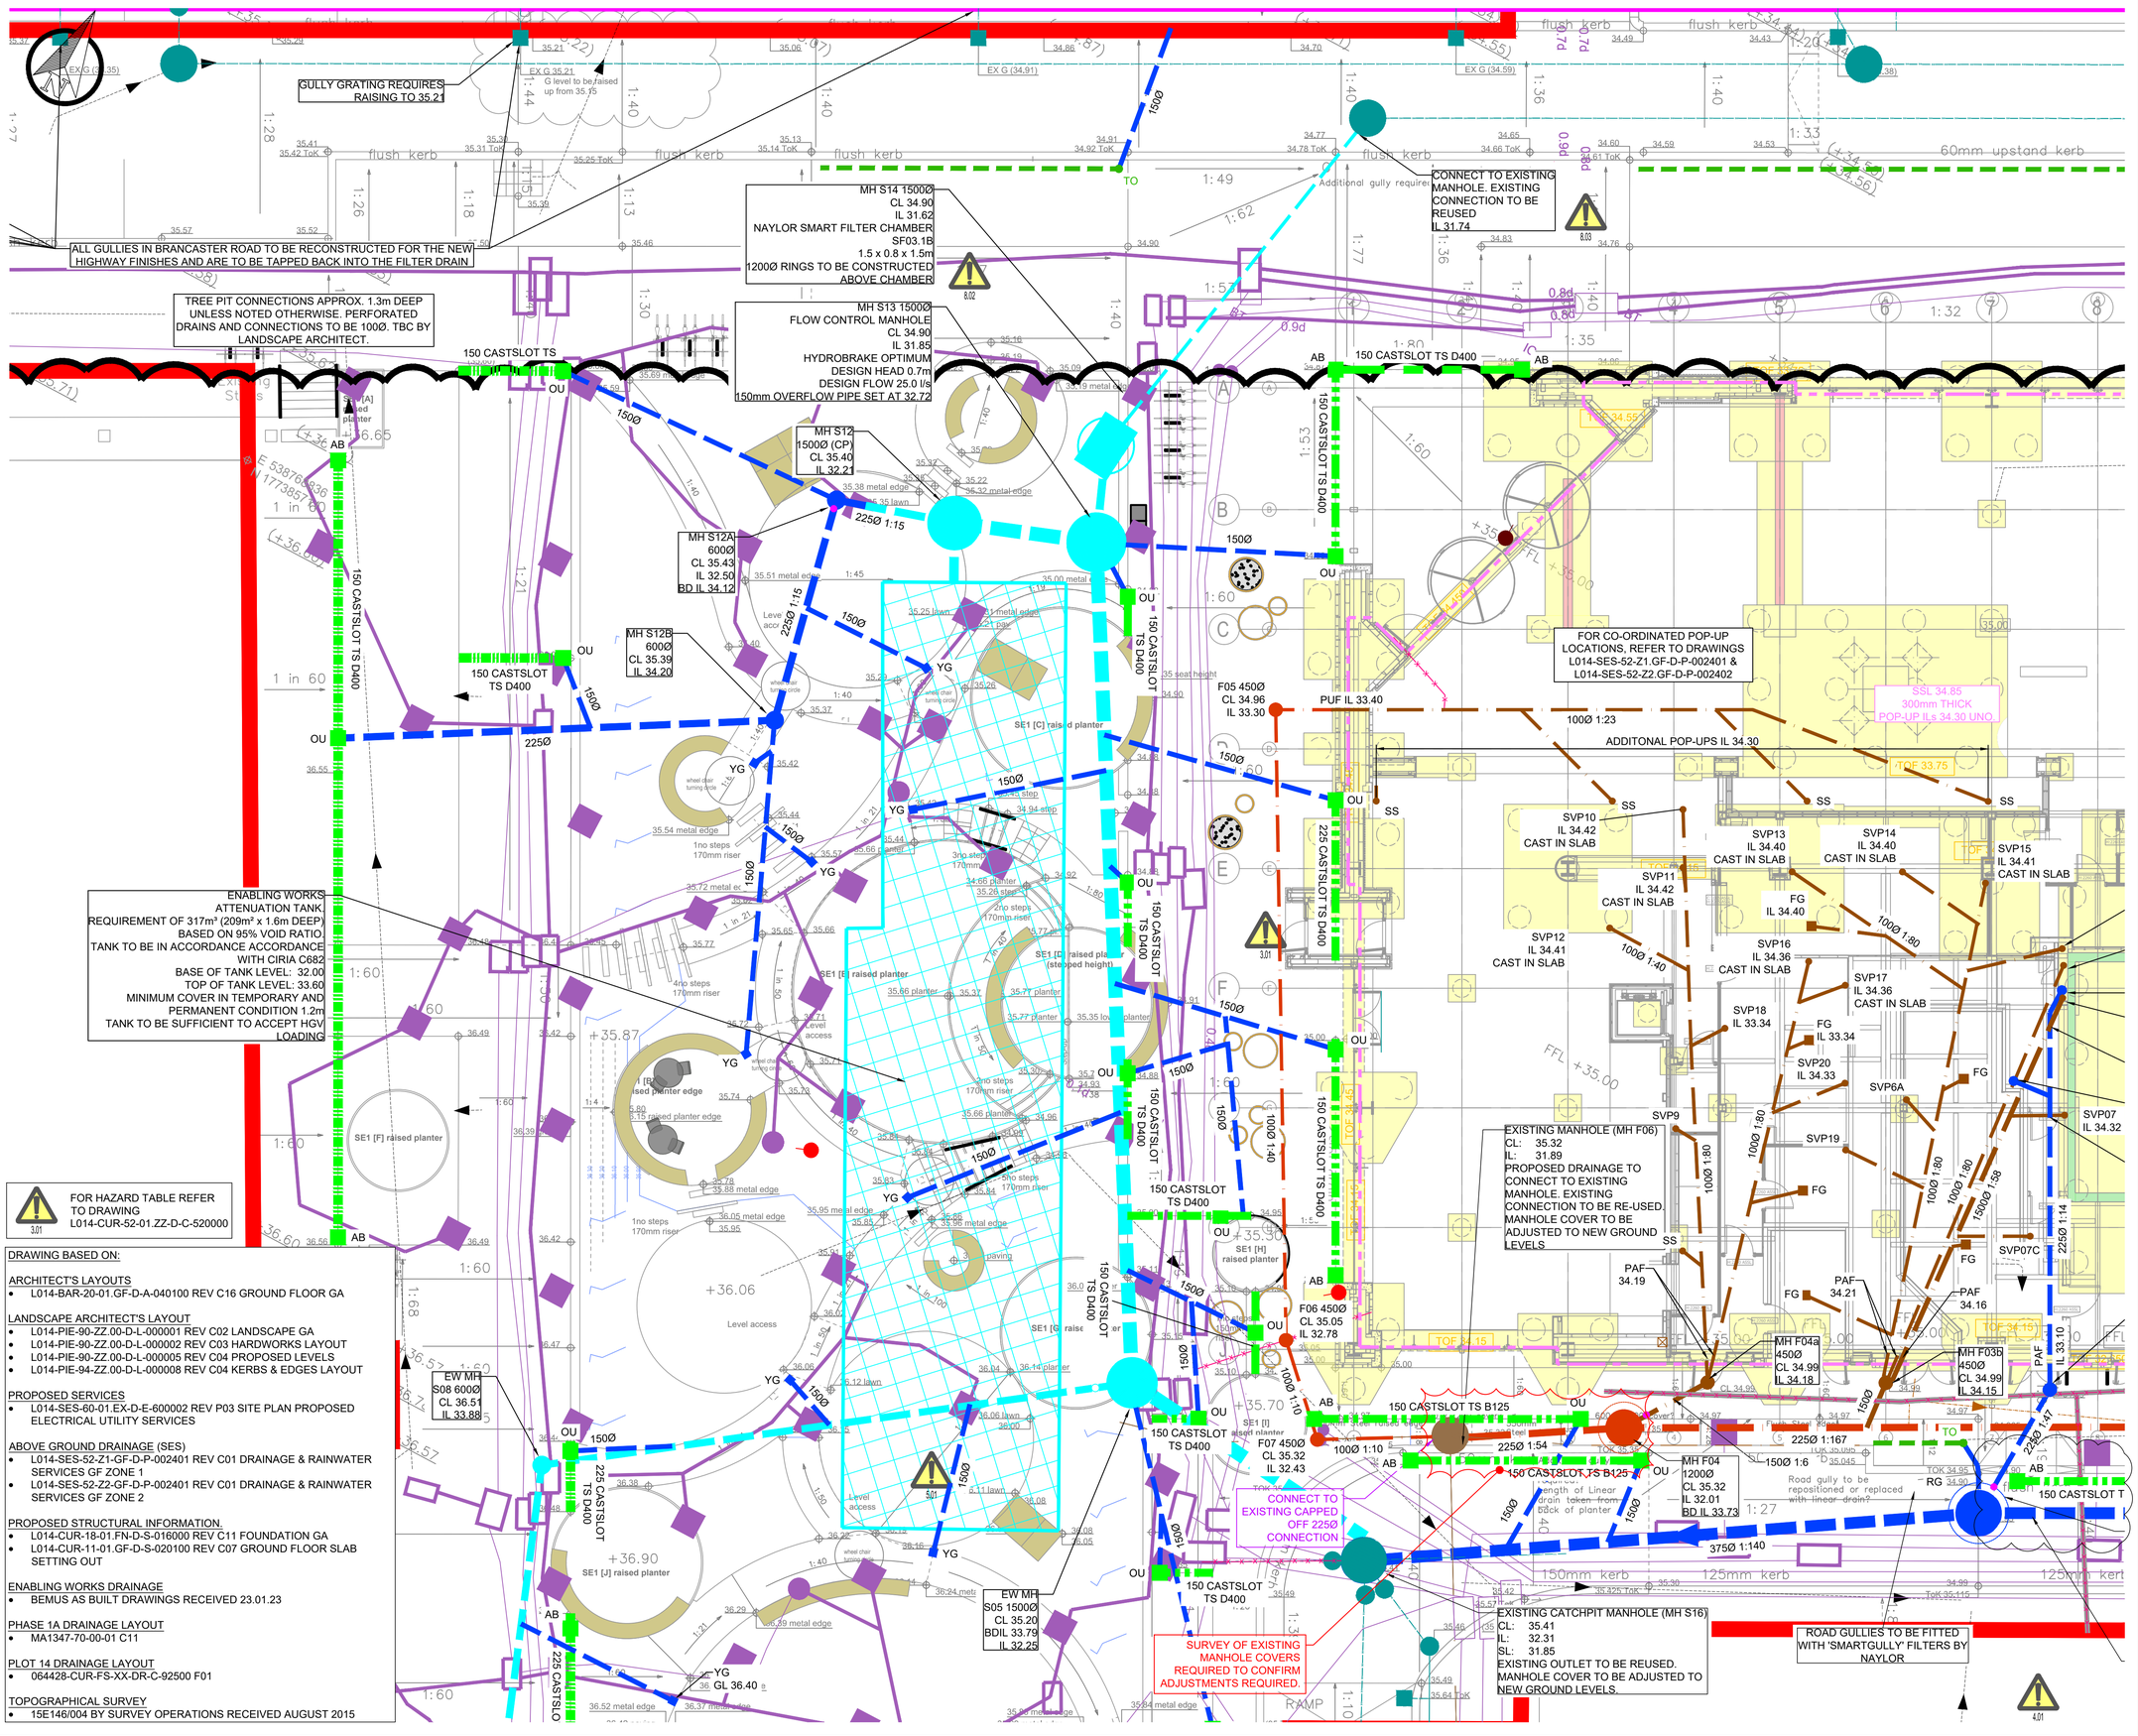


GENERAL NOTES:

1. THIS DRAWING IS TO BE READ IN CONJUNCTION WITH ALL RELEVANT ARCHITECTS AND ENGINEERS DRAWINGS AND SPECIFICATIONS.
2. DO NOT SCALE THIS DRAWING. ANY AMBIGUITIES, OMISSIONS AND ERRORS ON DRAWINGS SHALL BE BROUGHT TO THE ENGINEERS ATTENTION IMMEDIATELY. ALL DIMENSIONS MUST BE CHECKED / VERIFIED ON SITE.
3. ALL DIMENSIONS ARE IN METRES UNLESS NOTED OTHERWISE.
4. FOR GENERAL NOTES REFER TO DRAWING SA-CUR-XX-00-DR-C-92502.
5. FURTHER CO-ORDINATION REQUIRED BETWEEN EXTERNAL SERVICES AND THE PROPOSED DRAINAGE.

KEY:

PLANNING BOUNDARY TAKEN FROM LANDSCAF ARCHITECTS PLAN L014-PIE-90-ZZ.00-D-L-00000

EXISTING DRAINAGE

- AS CONSTRUCTED SW DRAINAGE
- AS CONSTRUCTED FOUL DRAINAGE
- PRE-DEVELOPMENT DRAINAGE (ASSUMED ABANDONED - TBC)
- DRAINAGE TO BE ABANDONED/ REMOVED

ENABLING WORKS DRAINAGE (AS CONSTRCUTED)

- ENABLING WORKS SW DRAINAGE
- ENABLING WORKS PROPOSED CELLULAR ATTENUATION STORAGE

PROPOSED DRAINAGE

- PROPOSED SW DRAINAGE
- PROPOSED FOUL DRAINAGE
- PROPOSED LINEAR DRAINAGE CHANNEL GATIC CASTSLOT TREADSAFE
- RG ROAD GULLY
- YG YARD GULLY
- TO 100Ø TREE PIT DRAIN/ OUTLET
- SVP FOUL CONNECTION SVP - SOIL VENT PIPE AAV - AIR ADMITTANCE VALVE
- FG FOUL GULLY
- RWP RAINWATER PIPE
- PROPOSED FILTER DRAIN
- PROPOSED FOUNDATION
- CHANGE IN SLAB LEVEL
- PROPOSED EXTERNAL SERVICES

Rev:	Description:	Date:	By:	Chkd:
C06	UPDATED TO LATEST LA PLAN	03.02.25	ATL	HS
C05	UPDATED TO LATEST LA PLAN	15.11.24	ATL	HS
C04	SURFACE DRAINAGE FEATURES UPDATED	27.09.24	ATL	ATL
C03	ADDITIONAL DRAINAGE ADDED	05.01.24	JC	ATL
C02	CONSTRUCTION ISSUE	24.10.23	ATL	CG
C01	CONSTRUCTION ISSUE (BUILDING DRAINAGE ONLY)	16.06.23	ATL	CG

curtins
Merchant Exchange, 17-19 Whitworth Street West, Manchester, M1 5WG
0161 236 2394
manchester@curtins.com
www.curtins.com
Civils & Structures • Transport Planning • Environmental • Infrastructure • Geotechnical • Conservation & Heritage • Principal Designer
Birmingham • Bristol • Cambridge • Cardiff • Douglas • Dublin • Edinburgh • Glasgow • Kendal • Leeds • Liverpool • London • Manchester • Nottingham

Status: CONSTRUCTION

Project: N0 3 CIRCLE SQUARE

Drg Title: PROPOSED DRAINAGE 1:100 LAYOUT SHEET 1

Drawn By	Designed By	Checked By
ATL	ATL	MW
Project No. 080355	Date 23.05.22	Scales @ A1 1:100

Project No - Originator - Function - Spatial - Form - Discipline - Number: L014 - CUR - 52 -01.ZZ- D - C - 520001

Revision: C05

\\ms-fs-1\Projects\080001 - 081000\080355 - Circle Square Building 3\04-Production\4A-Models\Drawings\C\CAD\92.