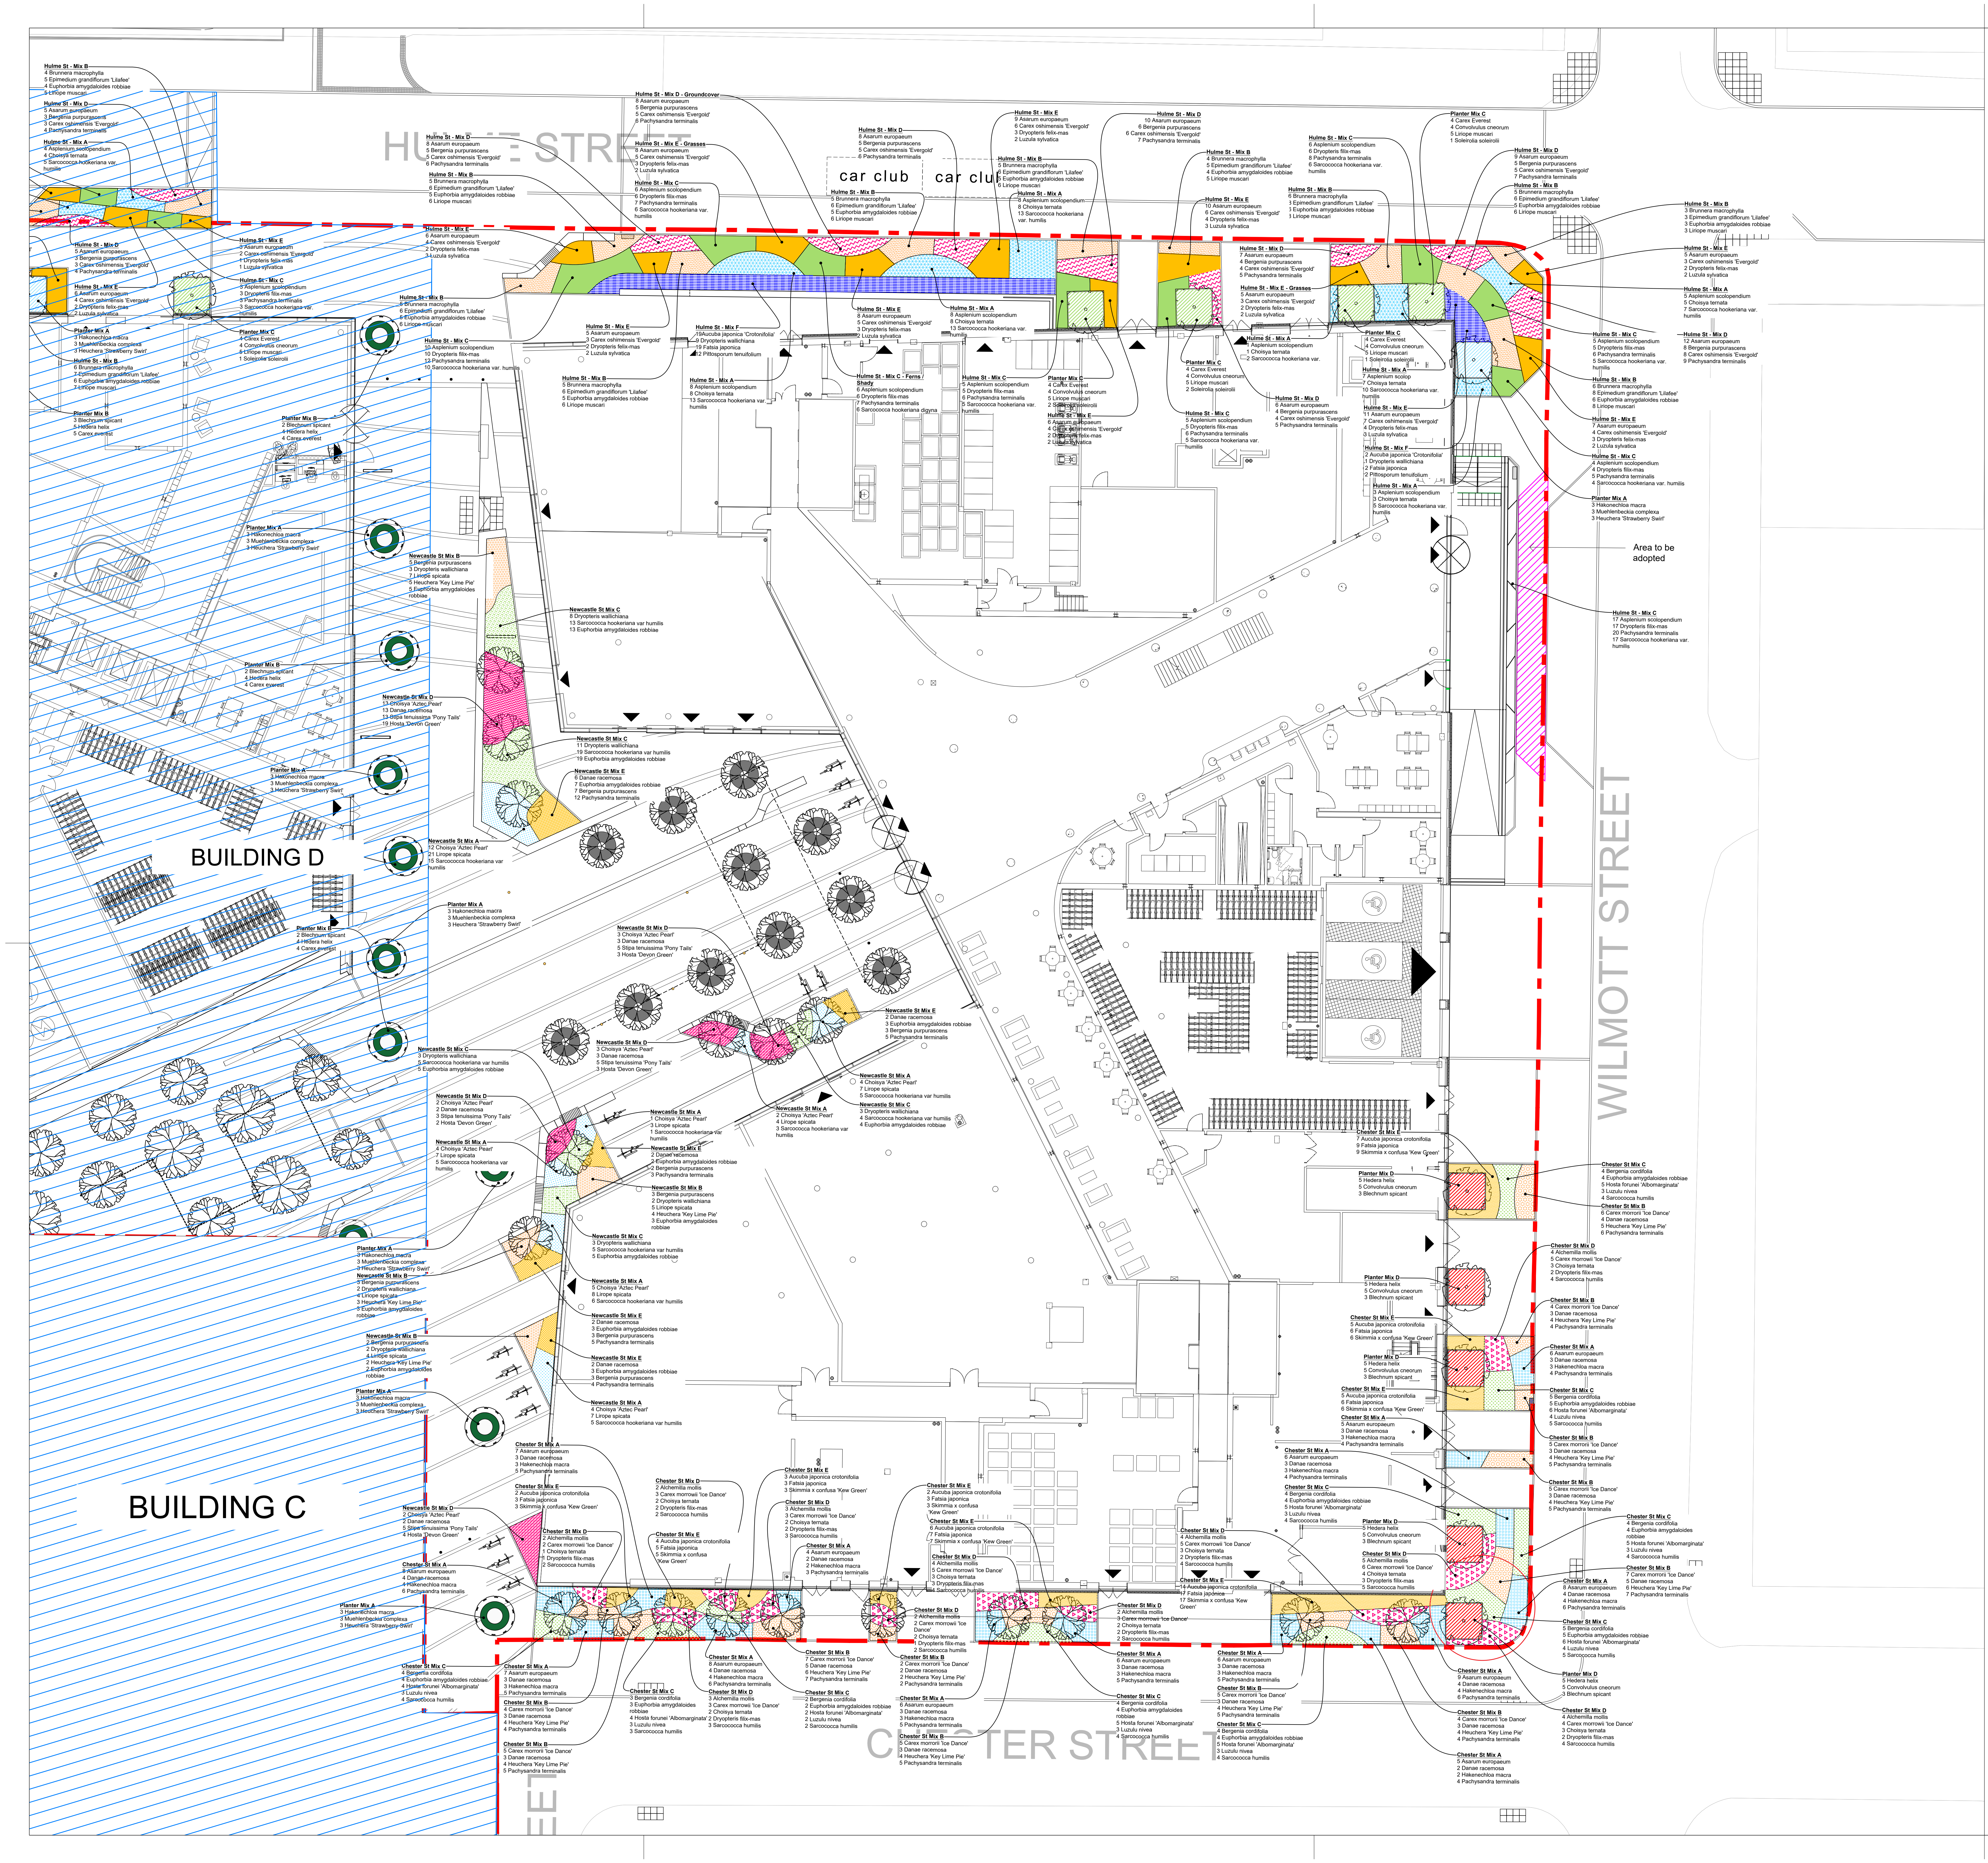

NOTES

1. This drawing is to be read in conjunction with all other drawings and specifications.
2. Do not scale off this drawing. Written dimensions to be taken only.
3. Any discrepancies found between this drawing and other drawings and specifications in the construction documents must be referred to the Landscape Architect prior to work commencing.
4. This drawing must not be copied in whole or in part without prior written consent of Optimised Environments Ltd.
5. Survey information is based upon aspect surveyors Topographical as Survey.

CDM INFORMATION

KEY PLAN

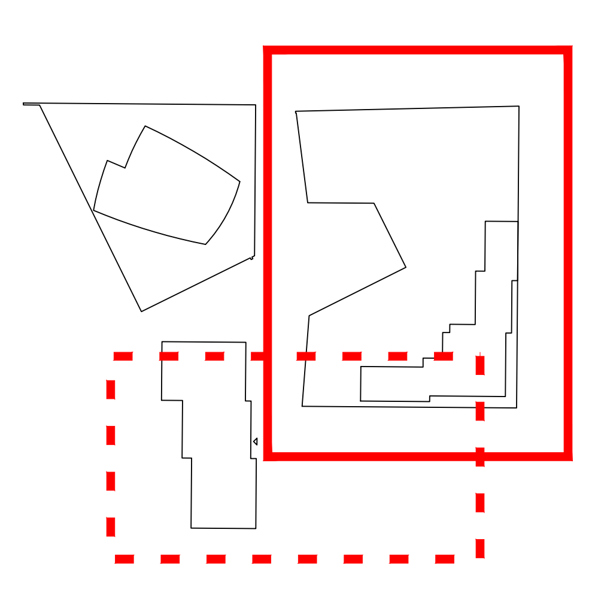

Issue	Revision	Initial	Date
11	AS BUILT	CO	06.03.25
10	FINAL CONSTRUCTION	CO	28.02.25
09	GF UPDATES	AH	14.08.24
08	BOLLARDS ADDED	SB	17.05.24
07	FULL GF PACK ISSUE	AH	04.03.24
06	REVISED ADOPTED PAVING	SB	26.02.24
05	REINSTATED TREES AND UPDATED PLANTING NOS.	SB	23.08.23
04	REVISED LAYOUT AND PLANTING NOS.	SB	08.08.23
03	REVISED LAYOUT AND PLANTING NOS.	SB	03.08.23
02	REVISED ENTRANCES	CO	19.06.23
-	FIRST ISSUE	AH	13.06.23

open
optimised environments

optimised environments ltd

EDINBURGH 2nd Floor | Quartermile Two | 2 Lister Square | Edinburgh | EH3 9GL
t 0131 221 5920 w optimisedenvironments.com

LONDON Warnford Court | 29 Throgmorton Street | London | EC2N 2AT
t 020 79474062 | w optimisedenvironments.com

MANCHESTER 13 Swan Street | Manchester | M4 5JJ
t 0161 696 7550 | w optimisedenvironments.com

Optimised Environments Ltd. Registered in Scotland SC359690.
Registered address: 2nd Floor | Quartermile Two | 2 Lister Square | Edinburgh | EH3 9GL

Client
Downing Living (Manchester) Ltd

Project
PLOT 11 FIRST STREET SOUTH

Manchester

Drawing Title
BUILDING A / B
PUBLIC REALM PLANTING PLAN

Sheet 1 of 1

Scale Bar
2m 4m 6m 8m 10m
North

Scale: **1:200@A1**
Date: **Apr 2023**
By: **AH**
Status: **AS BUILT**
Checked: **AW**
Approved: **AW**

Drawing Number **M90183_AB_L206**
Rev **11**

Computer File: R:\Projects\2019\M90183_FirstSt\CAD\AUTOCAD\SHEETS\PHASE AB