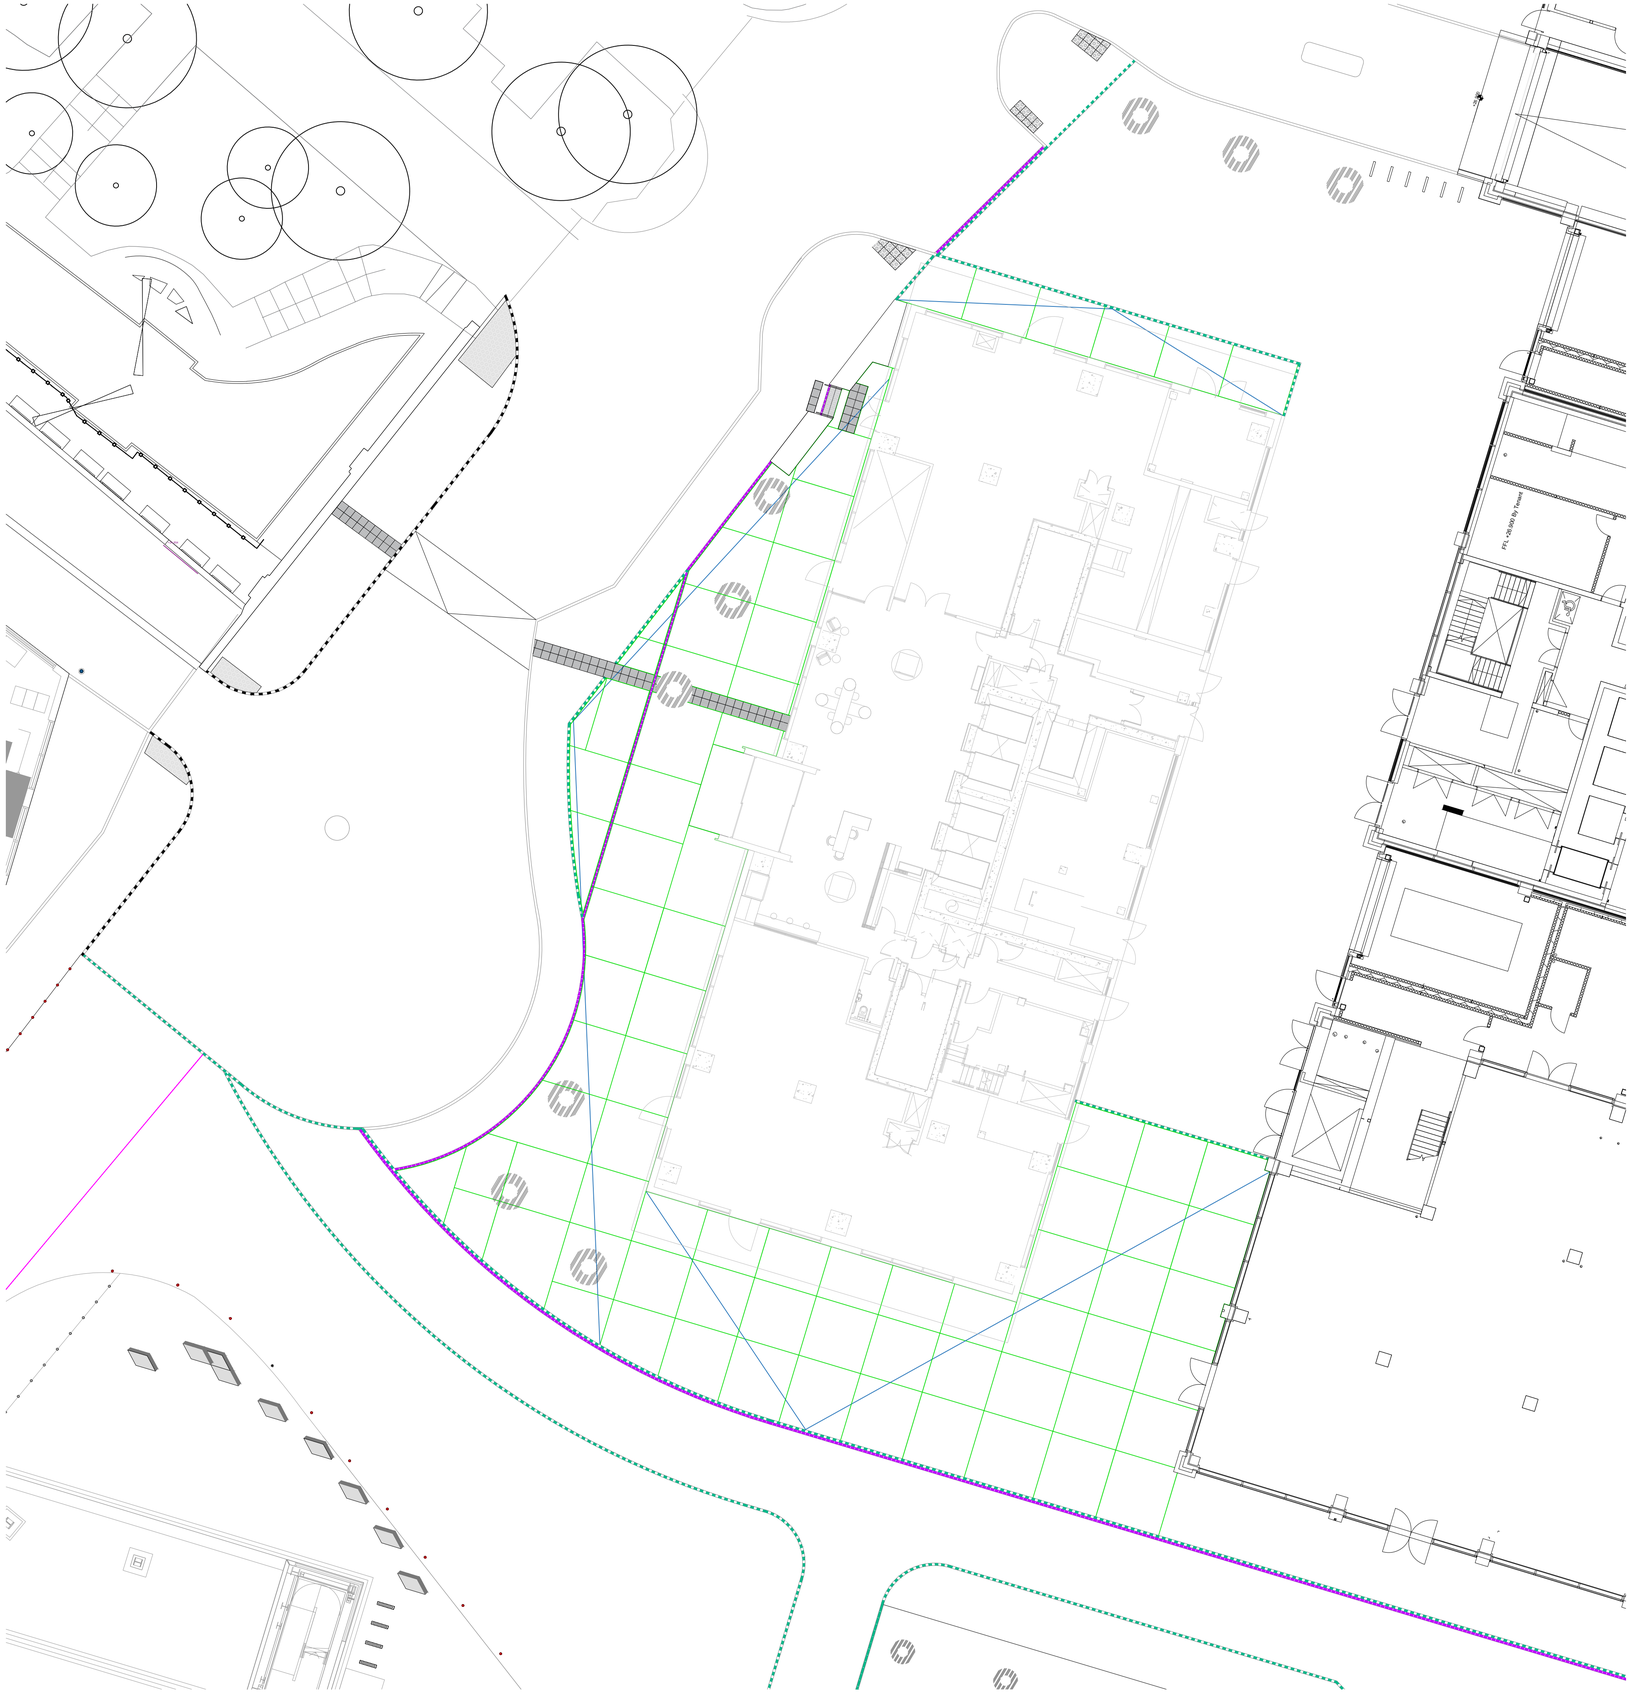

KEY

PROPOSED HARD LANDSCAPE

ST01 - IN-SITU DIAMONDCRETE SETTING OUT
SIZE: VARIES WIDTH X VARIES LENGTH X 200MM DEPTH WITH 15 MM BLACK MASTIC EXPANSION JOINT.
COLOUR: NATURAL WITH BRUSHED FINISH
SUPPLIER: AGGREGATE INDUSTRIES OR SIMILAR APPROVED

BRUSHED FINISH DIRECTION
HAND BRUSHED FINISH INTO DIAMONDCRETE

FT02 - TREE SURROUND (GRILLE) - 6 NO.
GREEN BLUE URBAN BESPOKE 1800-600 TREE GRILLE
SIZE: OUTER Ø1800MM INNER Ø600MM
COLOUR: POWDER COATED, RAL 9005
SUPPLIER: GREEN BLUE URBAN OR SIMILAR APPROVED.

ET02 - FLUSH CHANNEL SQUARE CONCRETE KERB
TO MATCH MGY - SIZE: 125W X 915L X 150MMH
COLOUR: NATURAL. SUPPLIER: MARSHALLS OR SIMILAR APPROVED

ET03 - SLOT DRAIN
TO CURTINS SPECIFICATION.
SIZE: TBC

0 10m

North

No dimensions are to be scaled from this drawing.
All dimensions are to be checked on site.
Area measurements for indicative purposes only.

This drawing is the property of Exterior Architecture Ltd.
No part of the drawing may be reproduced in any manner without permission from Exterior Architecture Ltd.

Client
VITA

Rev	Description	Date
----	----	----
C09	AS BUILT COORDINATION	12.12.2023
C08	UPDATED TO DCM COMMENTS	30.11.2023
C07	COORDINATION	30.10.2023
C06	RENAKER COORDINATION	11.10.2023
C05	UPDATED JOINTING LAYOUT	10.10.2023
C04	COORDINATION	05.10.2023
C03	UPDATED JOINTING LAYOUT	24.07.2023
C02	COORDINATION	16.06.2023
C01	INITIAL ISSUE	01.06.2023

EXTERIOR ARCHITECTURE

LONDON
Unit 17.1, The Leather Market, 11-13 Weston Street, London, SE1 3ER
MANCHESTER
Studio 537, The Royal Exchange, St Anns Square, Manchester, M2 7DH

E-MAIL office@exteriorarchitecture.com
WEB www.exteriorarchitecture.com

Project title
ST JOHNS T1 PUBLIC REALM

Drawing title
T1 DIAMONDCRETE SETTING OUT PLAN

Issued By	Manchester	T: 0161 850 8101	
Scale	1:150 @ A1	Drawn	EXA
Status	STAGE 5	Checked	SPL
Date	12.12.2023	Approved	JM

Drawing number
T1-EXA-G710-PL-GRD-400

Revision
C09

P:\2018\1882 ST JOHNS\01 CAD\02 SHEET LAYOUT\2279 T1 NOVATION\T1-EXA-G710-PL-GRD-400 T1 DIAMONDCRETE SETTING OUT PLAN.DWG