



TYPICAL CORNER BRACKET AND BAR SET OUT

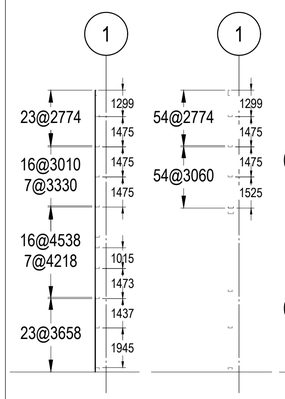

SECTION A-A
THROUGH LINERS

SECTION B-B
THROUGH LINERS

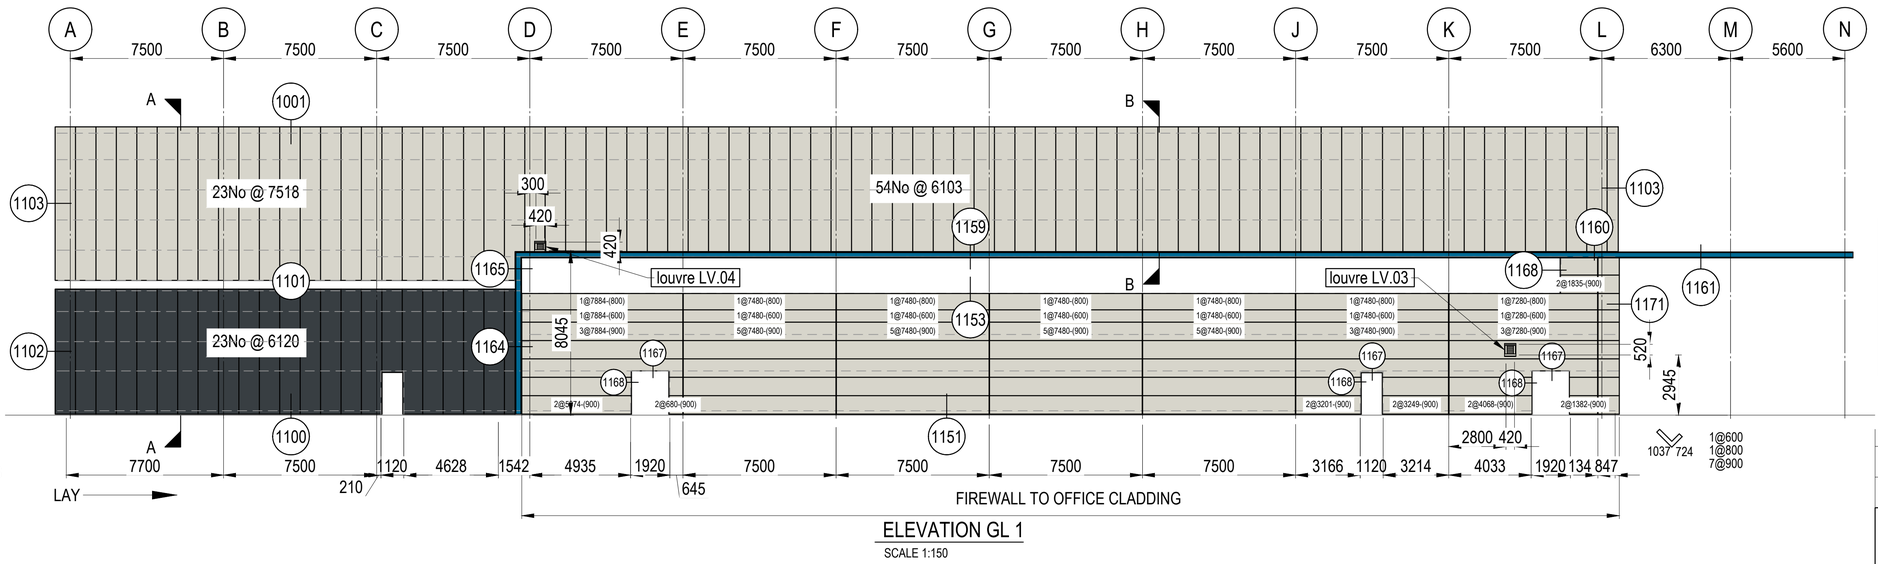

ELEVATION GL 1
SCALE 1:150


NOTES.

1. THIS DRAWING IS COPYRIGHT AND IS SENT TO YOU IN CONFIDENCE.IT MUST NOT BE COPIED,USED OR DISCLOSED IN WHOLE OR IN PART,TO THIRD PARTIES WITHOUT OUR WRITTEN PERMISSION. IT REMAINS THE PROPERTY OF FK CONSTRUCTION LIMITED AND MUST BE RETURNED ON REQUEST.

KEY


- CA32/1000W HAMLET (RAL.9002) OUTER SHEET SEE DRAWING C3353-3002
- CA32/1000W ANTHRACITE (RAL.7016) OUTER SHEET SEE DRAWING C3353-3001

LOUVRE SPEC - BRIDGE LOUVRE BLR50/50-P-VG - WITH GALV VERMIN GUARD			
NUMBER REQUIRED	SIZE (TRIMMER OPENING) WxH	LOUVRE SIZE = TRIMMER OPENING LESS 120mm	COLOUR
1No - LV.01	420x520	300x400	HAMLET, RAL 9002
1No - LV.02	370x370	250x250	ANTHRACITE, RAL 7016
1No - LV.03	420x520	300x400	HAMLET, RAL 9002
1No - LV.04	420x420	300x300	HAMLET, RAL 9002

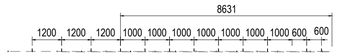


TYPICAL CORNER BRACKET AND BAR SET OUT

NOTE: FIRE WALL CONSTRUCTION (PROTECTED AREA) EQUATES TO 50% OF THE CLAD ELEVATION

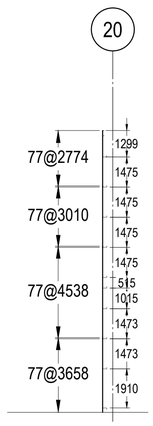

SECTION C-C
THROUGH LINERS

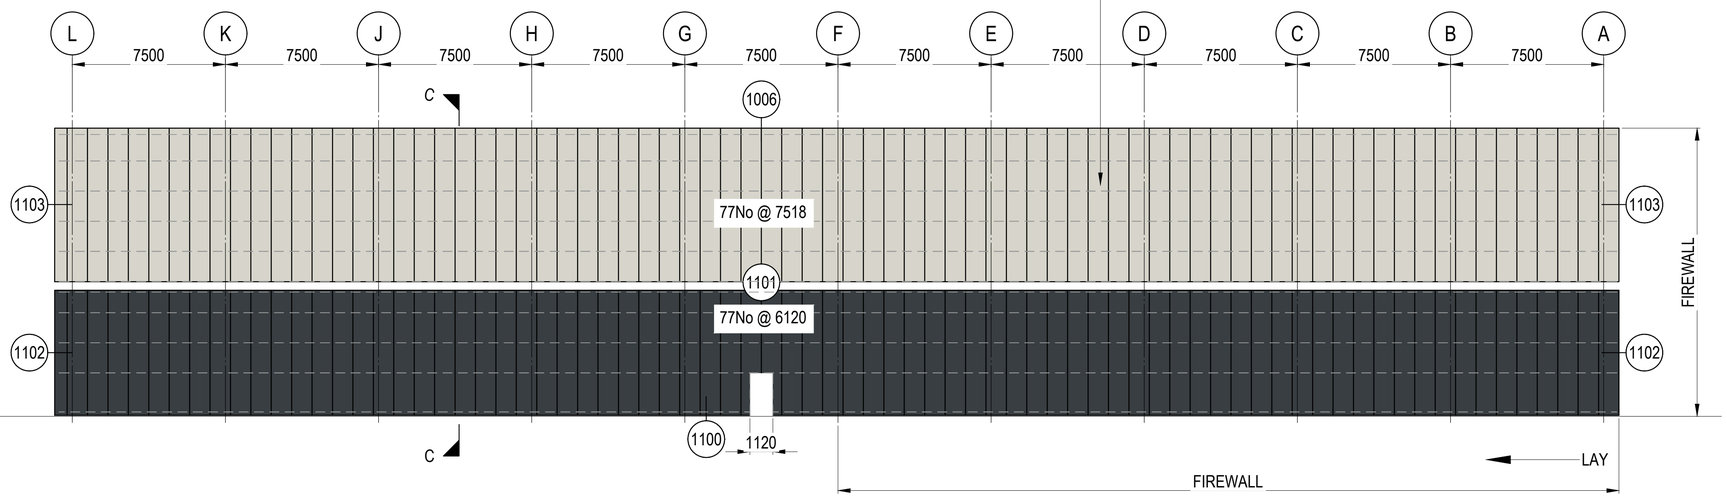

ELEVATION GL 20
SCALE 1:150

REV	DETAILS	DATE
AB01	AS BUILT	20/07/20
C04	FIRE WALL AREA REVISED TO GL 20	18/03/20
C03	ADDITIONAL PERSONNEL DOORS ADDED	19/02/20
C02	BOTTOM LINER PANEL SIZE AMENDED FIRE WALLS AMENDED	13/01/20
C01	ISSUED FOR CONSTRUCTION	16/12/19
P02	OFFICE DRAWN - ISSUED FOR COMMENT	21/11/19
P01	ISSUED FOR COMMENT	14/10/19

AS BUILT

KEENAN HOUSE
22-26 STOCKPORT ROAD
ALTRINCHAM
WA15 8EX

OFFICE TELEPHONE:0161 926 1350
www.fkgroup.co.uk

DRAWN BY	CHKD BY	DATE	SCALE
LP	GDB	10/10/19	1:150

CLIENT
McLAREN GROUP

CONTRACT
DNATA
MANCHESTER AIRPORT

DRAWING TITLE
ELEVATION ON
GL1 AND GL 20

DRAWING No. C3353-0003 AB01

DOC REF.