

This Drawing Pack Consists Of The Following Drawings...
4192 (E) 012 to 4192 (E) 012


ITEM NO.	DESCRIPTION	QTY.
1	PANEL WALL FIXING BRACKET - WALL FIXED	1
2	M6 X 30mm HEXAGON SOCKET BUTTON HEAD SCREW	1
3	M6 FORM D WASHER BZP	1
4	M6 SHAKEPROOF WASHER	1

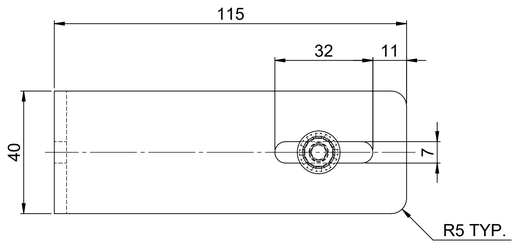


1 PLAN ELEVATION
SCALE: 1:1

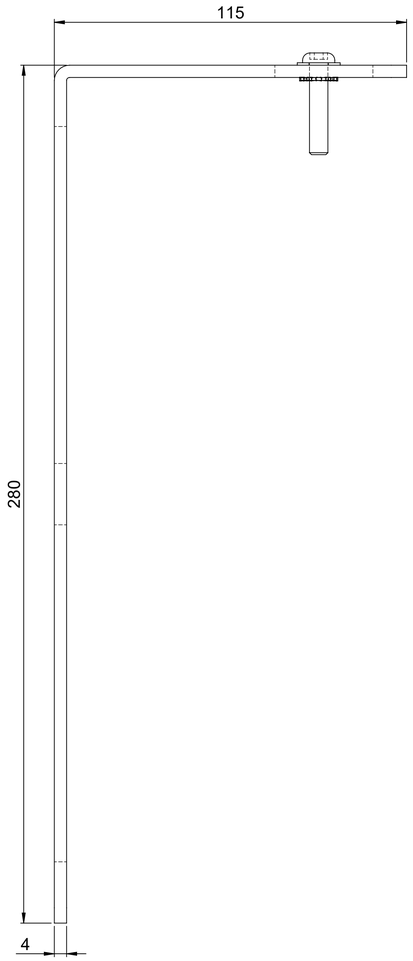


2 FRONT ELEVATION
SCALE: 1:1

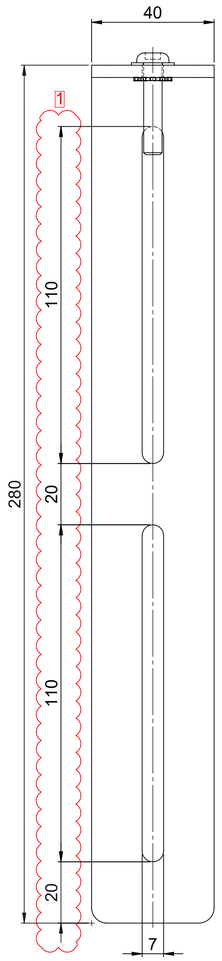

3 SIDE ELEVATION
SCALE: 1:1

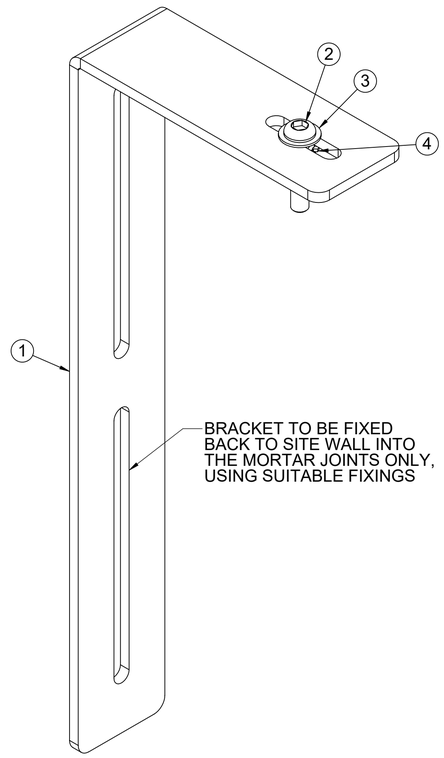

4 ISOMETRIC VIEW
SCALE: 1:1

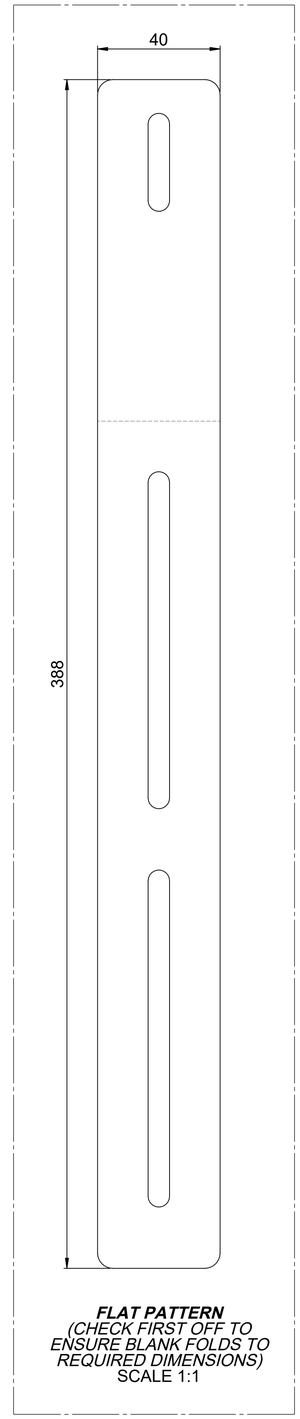

FLAT PATTERN
(CHECK FIRST OFF TO ENSURE BLANK FOLDS TO REQUIRED DIMENSIONS)
SCALE 1:1

Clients Approval Block	
Status:	Clients signature:
A Approved	
B Approved with comments	
C Not Approved Resubmit	
Approval date:	

This drawing is copyright. It may not be reproduced or disclosed either wholly or in part without written consent from THE HUB LIMITED. These drawings must NOT be scaled and should be verified on site before work commences.

GENERAL DRAWING NOTES
ALL DIMENSIONS ARE IN MILLIMETRES UNLESS OTHERWISE STATED

All electrical and data communications systems must conform to the prevailing national regulations and any local bylaws pertaining.

Unless stated otherwise all timber or timber-based materials used, including sheet materials, as specified by BS 476 (or international equivalent), must be not less than Class 1 and any other material utilised must be in accordance with Class 1 spread of flame.

GENERAL WORKSHOP NOTES:
ALL FRAMES/ASSEMBLY CUTTING LISTS ARE ALL PER ASSEMBLY.
ALL SOLID SURFACING CUT LISTS AND CNC DRAWINGS ARE EXACT SIZES. PLEASE ADD ON EXTRA FOR TRIMMING AS REQUIRED.

SAFETY HEALTH ENVIRONMENT AND QUALITY (SHEQ)

In addition to the hazards/risks normally associated with the types of work detailed on this drawing, note the following risks and information.

For information relating to Use, Cleaning and Maintenance see the Health and Safety File. It is assumed that all works will be carried out by a competent contractor working, where appropriate, to an approved method statement.

Materials/Finishes & Notes

MATERIAL:

STAINLESS STEEL

FINISH:

BEAD BLASTED TO APPROVED SAMPLE

Rev	Description	Date	By
1	ENLARGED WALL FIXING SLOTS, RE-ISSUE FOR APPROVAL	13/12/2024	DB
0	ISSUE FOR APPROVAL	04/12/2024	DB

APPROVAL

Client
Science Museum

Project
SIM Power Hall

Drawing Title
Panel Wall Fixing Bracket - Wall Fixed

thehub

48a Heming Road
Washford
Redditch
B98 0EA

P. 01527 522417
F. 01527 525789

www.thehublimited.co.uk

Drawn	Date
DB	04/12/2024
Checked	
Drawing No. 4192 (E) 012	
Rev. 1	