


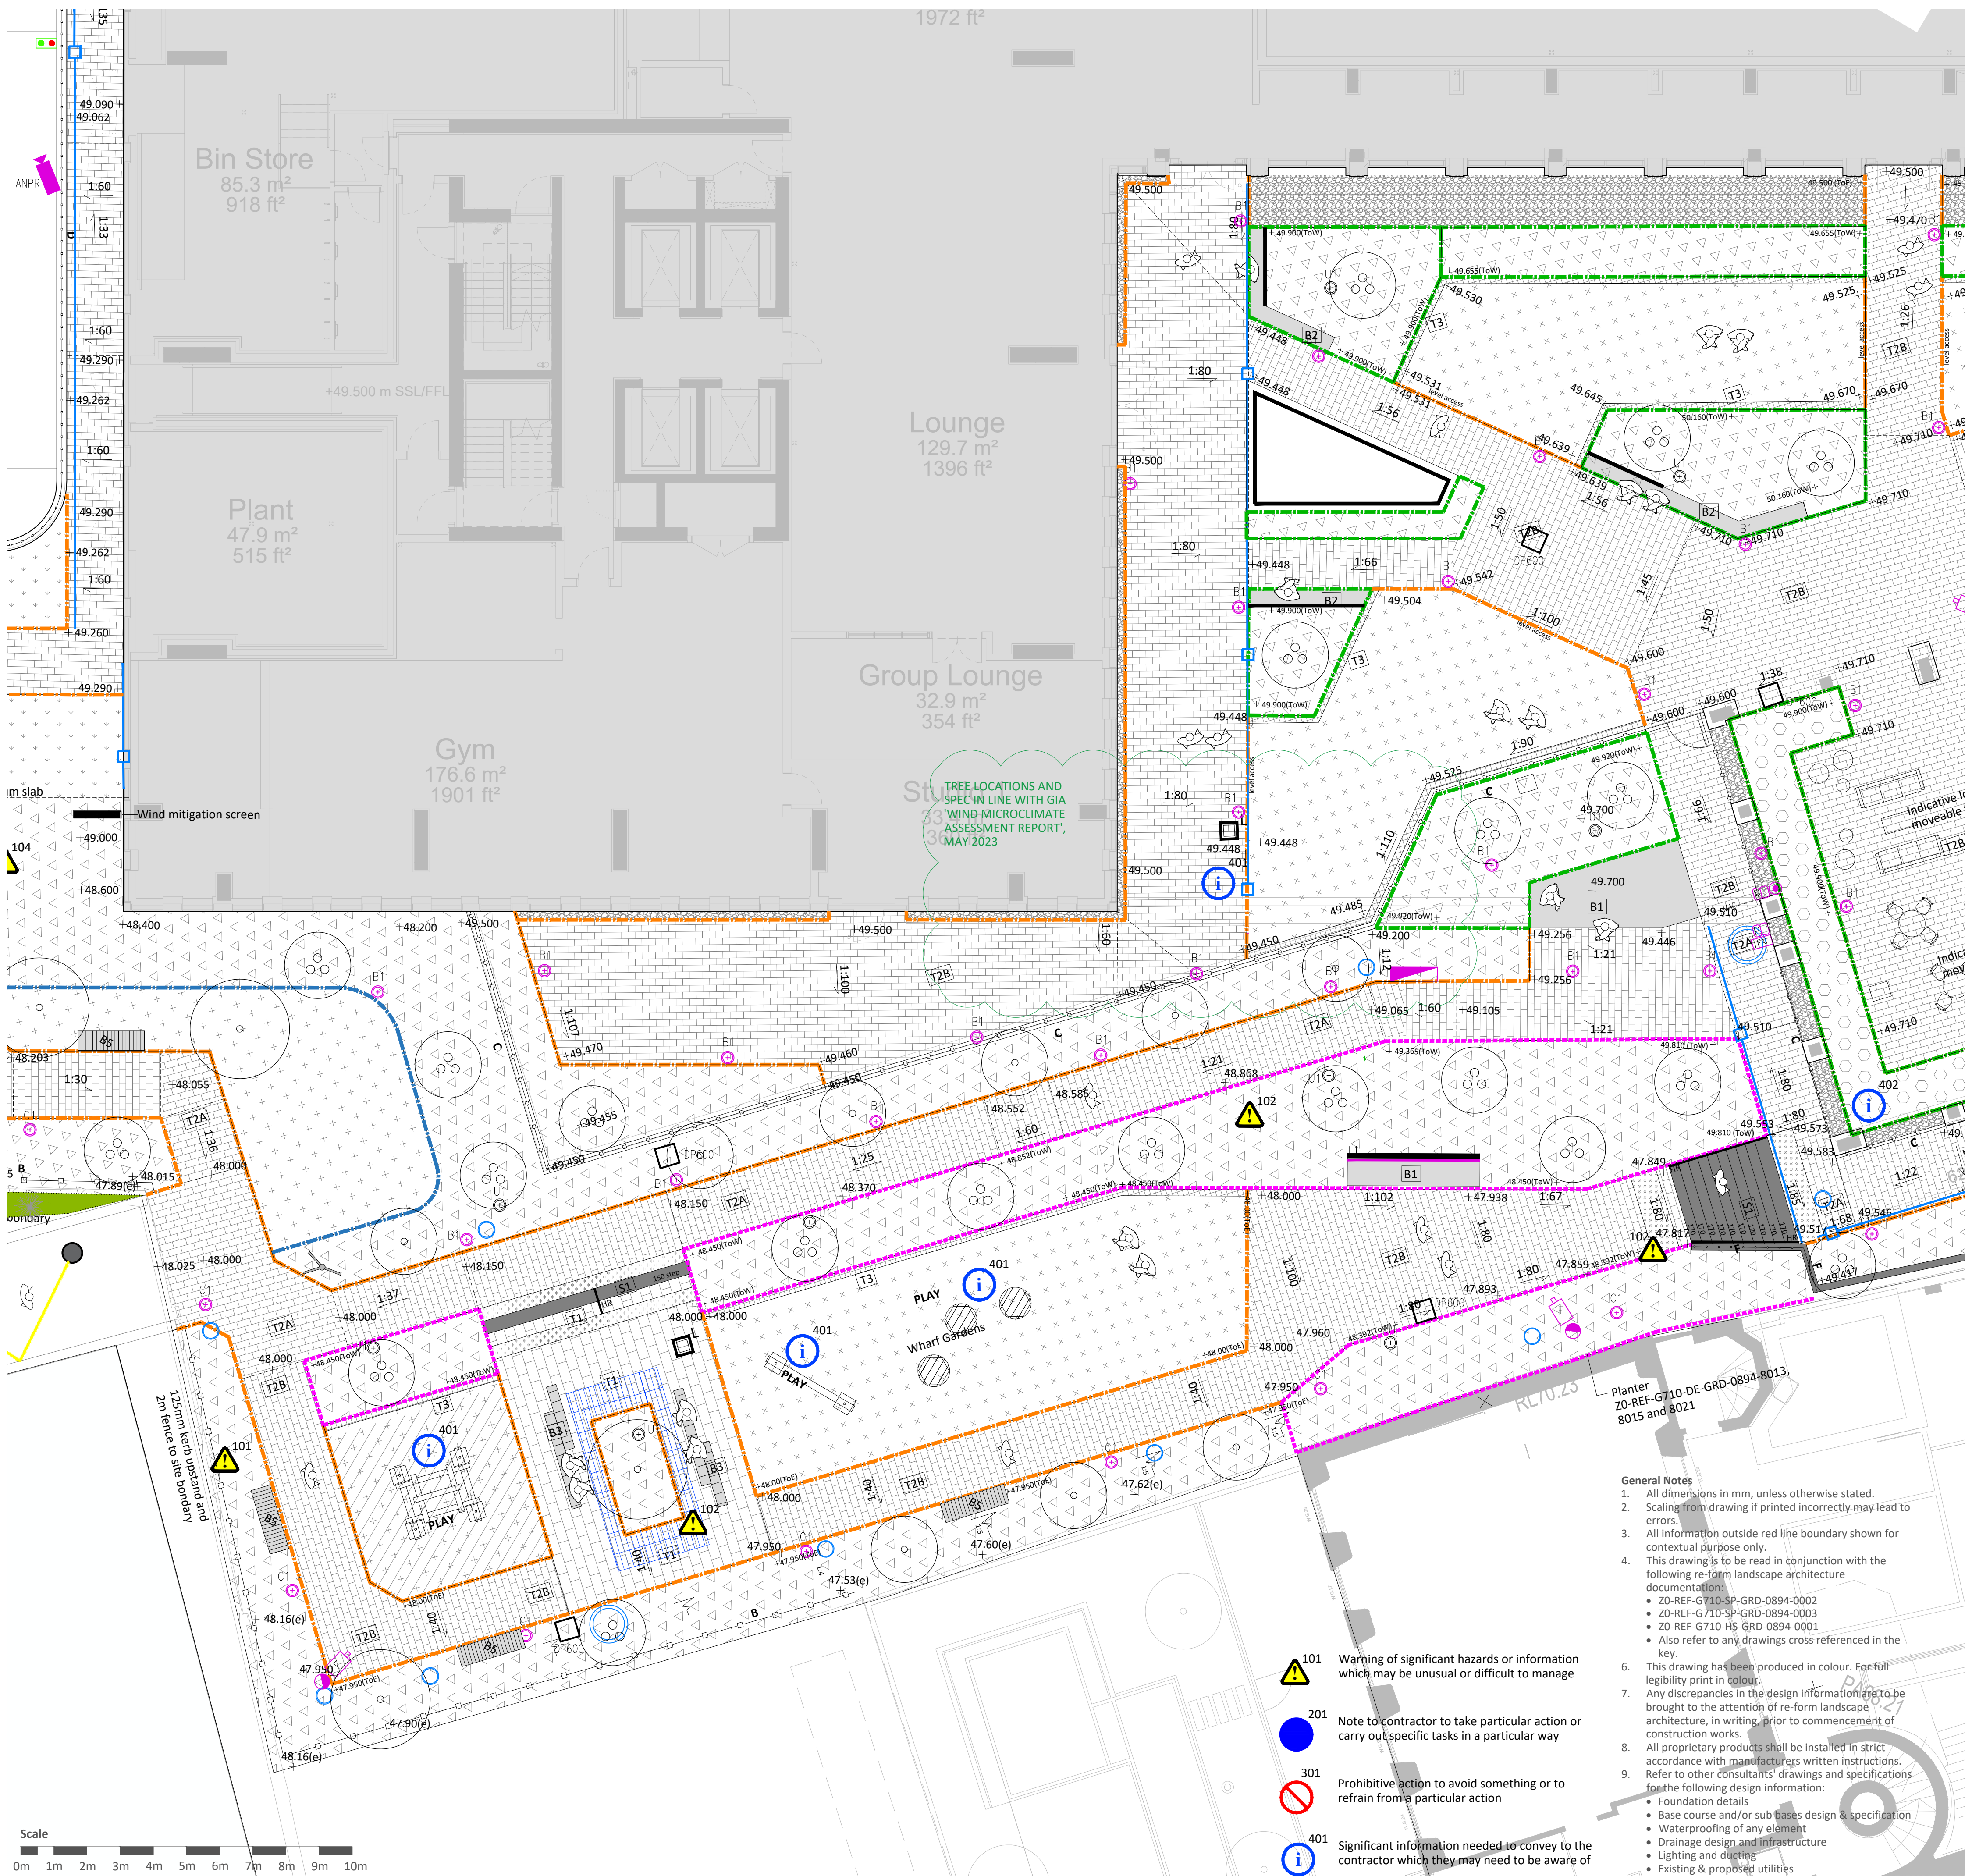

23.05.25 Levels within courtyard adjacent to courtyard wall updated.

Date

Description of revision

JR/MS

MS

MS

C08

Drawn

Checked

Approved

Revision

re-form

landscape architecture

Beehive Mill, Jersey Street,
Manchester M4 6JG
T: +44 (0)161 397 4953
E: info@re-formlandscape.com
W: re-formlandscape.com

Project

PORT STREET, MANCHESTER
RF21-894

Client

RENAKER BUILD

Document title

DETAILED HARDWORKS PLAN 2 OF 3

Paper size

A1

Scale

1:100

Status

FOR REVIEW AND COMMENT

S3

Drawing number

Z0-REF-G710-PL-GRD-0894-0009

Revision

C08

© re-form landscape architecture

General Notes

- All dimensions in mm, unless otherwise stated.
- Scaling from drawing if printed incorrectly may lead to errors.
- All information outside red line boundary shown for contextual purpose only.
- This drawing is to be read in conjunction with the following re-form landscape architecture documentation:
 - Z0-REF-G710-SP-GRD-0894-0002
 - Z0-REF-G710-SP-GRD-0894-0003
 - Z0-REF-G710-HS-GRD-0894-0001Also refer to any drawings cross referenced in the key.
- This drawing has been produced in colour. For full legibility print in colour.
- Any discrepancies in the design information are to be brought to the attention of re-form landscape architecture, in writing, prior to commencement of construction works.
- All proprietary products shall be installed in strict accordance with manufacturers written instructions. Refer to other consultants' drawings and specifications for the following design information:
 - Foundation details
 - Base course and/or sub bases design & specification
 - Waterproofing of any element
 - Drainage design and infrastructure
 - Lighting and ducting
 - Existing & proposed utilities
-
-