

This drawing is the copyright of LDM Design.
All dimensions to be checked on site.
All levels to be checked on site and refer to Ordnance Survey Datum Newlyn unless alternative datum given.
All errors and omissions to be reported to the Architect prior to commencement.
This drawing must be read in conjunction with the relevant specification clauses.
This drawing must not be used on site unless issued for construction.

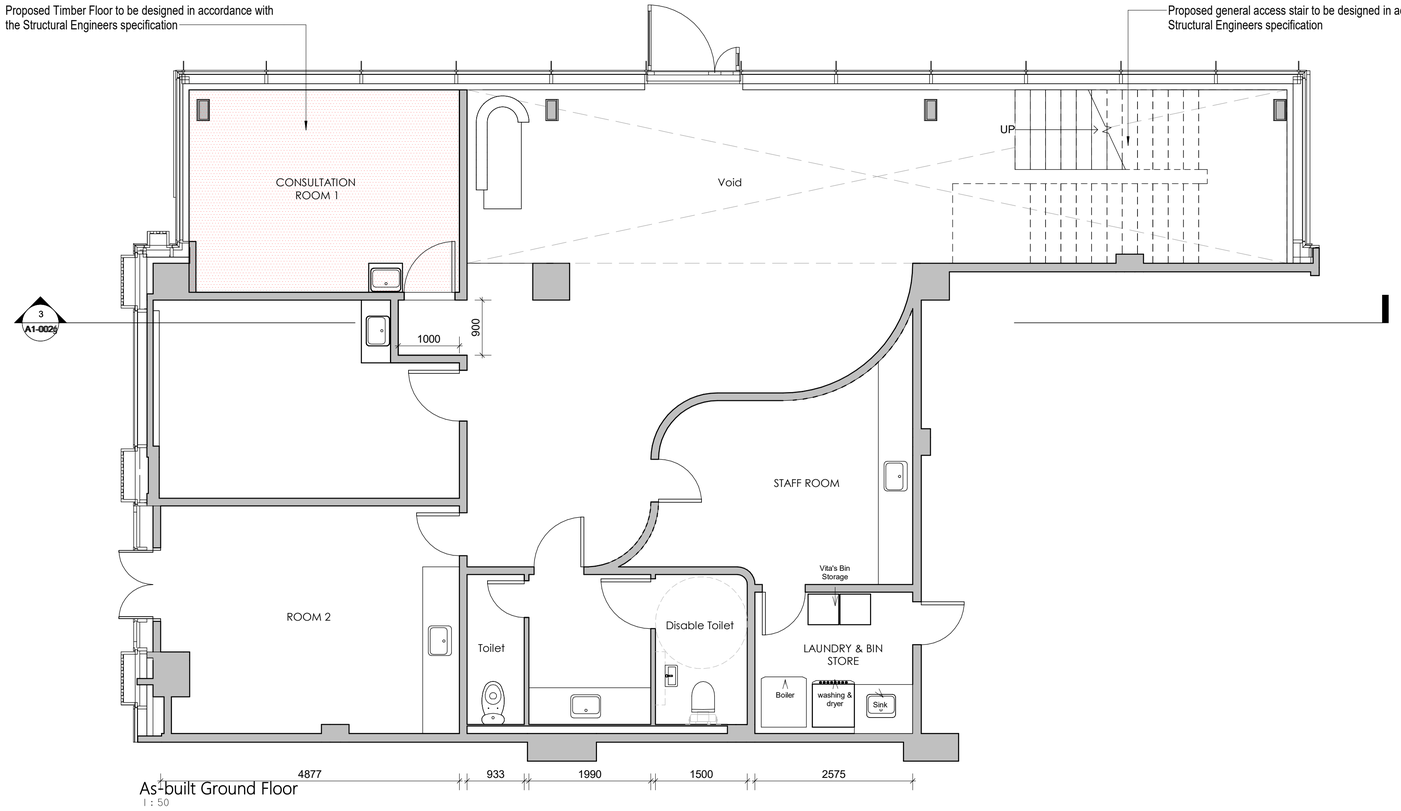

As-built Ground Floor
1 : 50

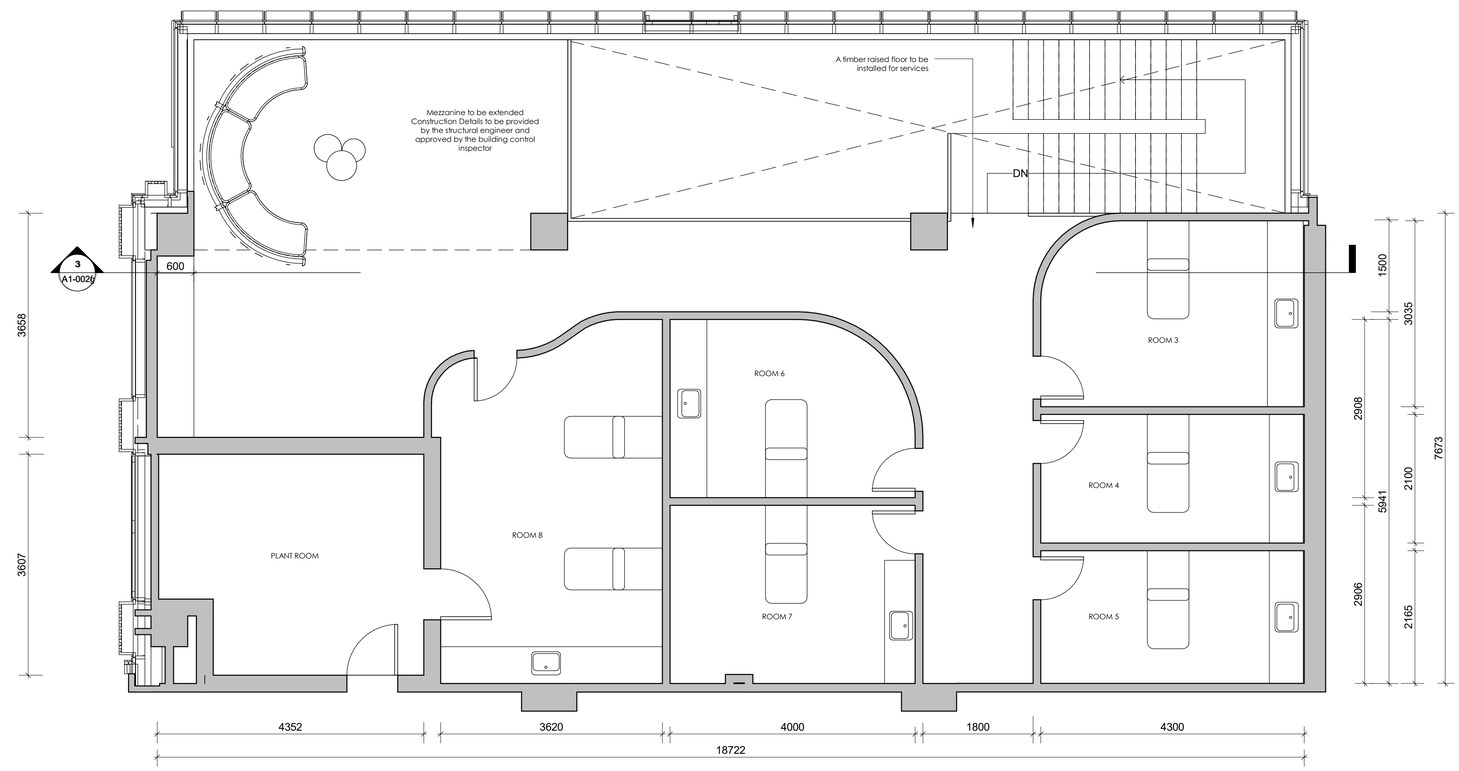

As-built Mezzanine Floor
1 : 50

0 1 2 3 4 5
GRAPHIC SCALE: 1:50

LDM Design

PROJECT
Unit L4 Vita East Circle Square 9 Nobel Way
Manchester M1 7FT

SHEET
General Arrangement Plans

CLIENT
– – –

Scale (@ A1)	As indicated		
Drawn by	BA	DRAWING NUMBER	REV
Checked by	KK	A1-002g	F