

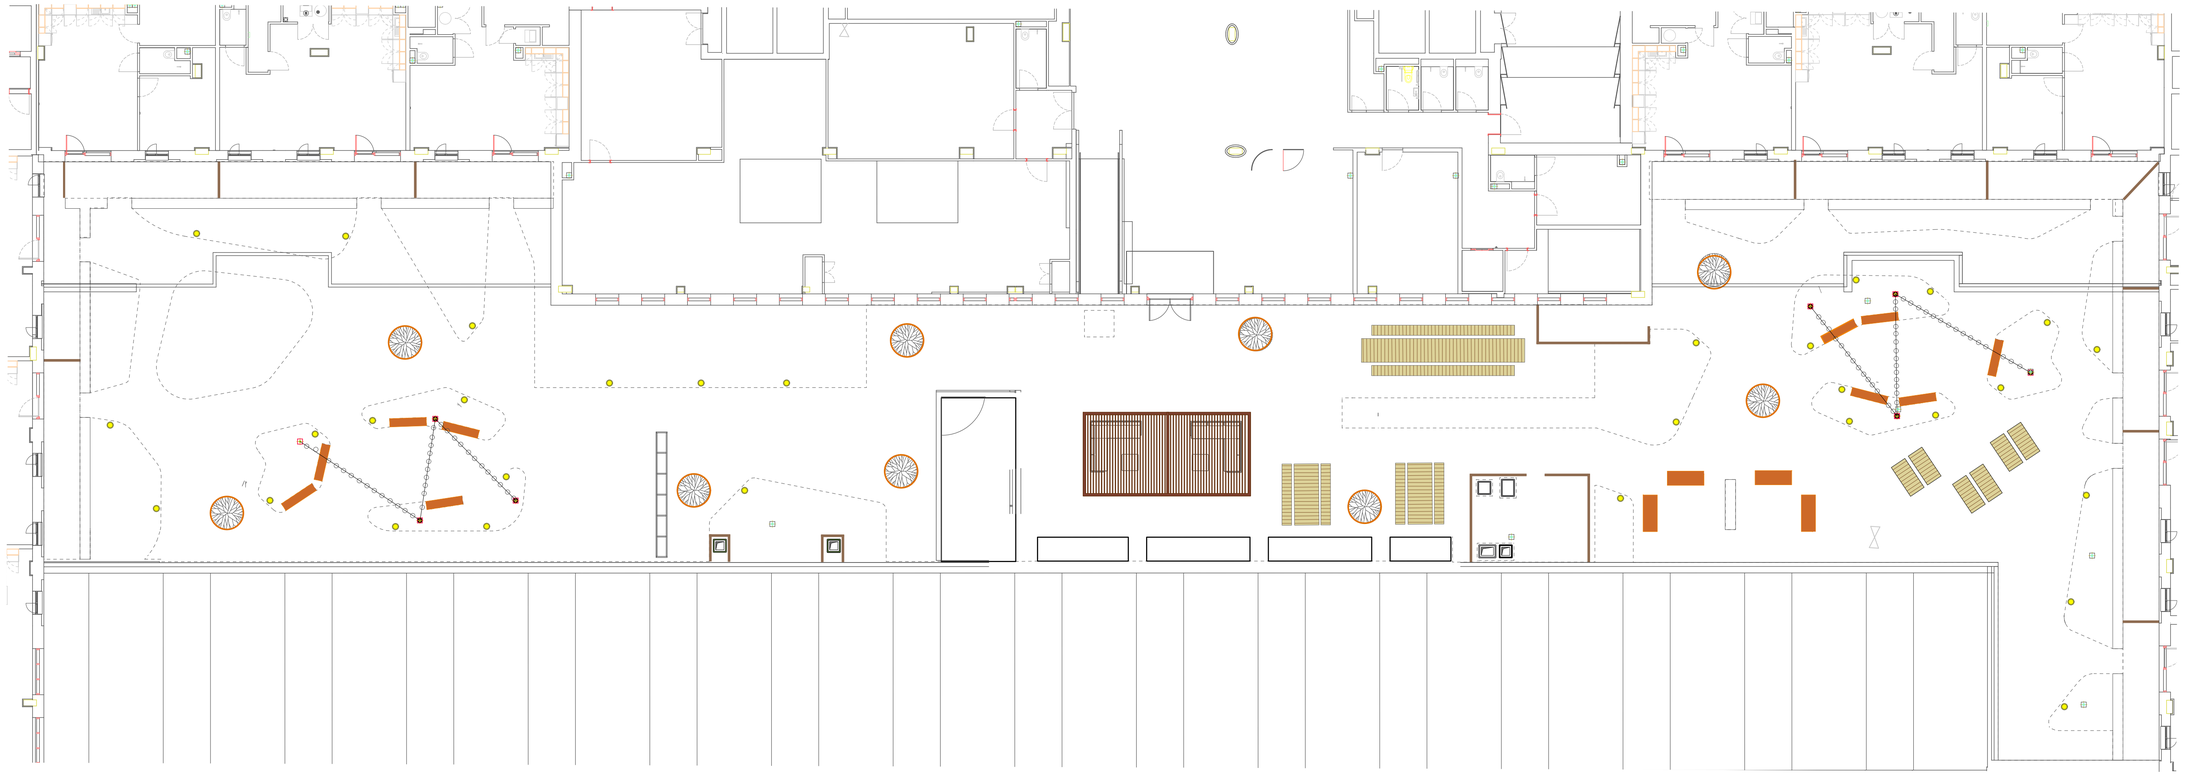


1 Podium Furniture Layout
Scale: 1:150

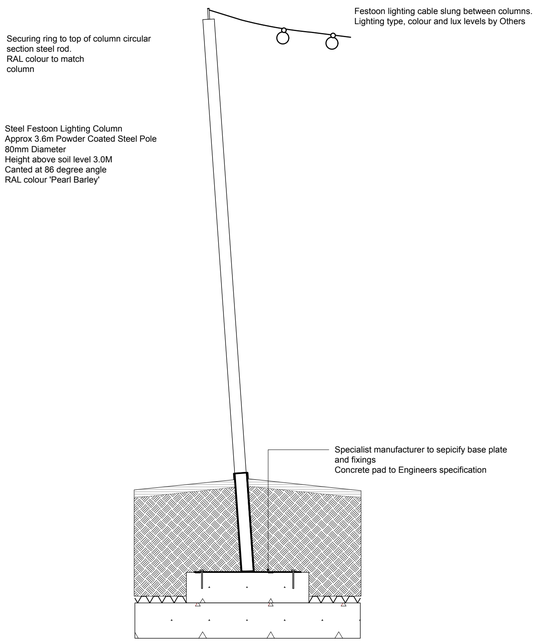

2 Festoon Lighting Pole
Scale: 1:20
Festoon Column detail subject to change
Fixing detail to engineers specification

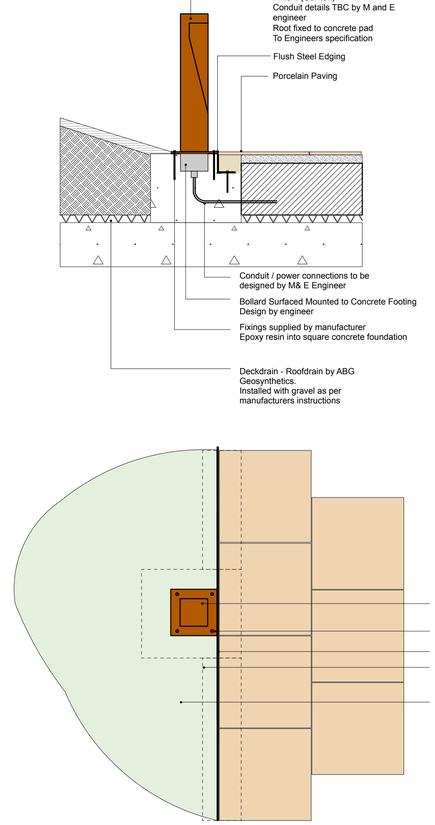

3 Bollard Fixing
Scale: 1:20

No dimensions are to be scaled from this drawing. All dimensions are to be checked on site.
Area measurements for indicative purposes only.

This drawing is the property of Wright Landscapes Limited. No part of the drawing may be reproduced in any manner without permission from Wright Landscapes Limited.

All Wright Landscapes drawings to read in conjuction with architectual / engineers plans & details.

FURNITURE AND BOUNDARY TREATMENTS

POTS
- Product: Corten Steel Planters
- Finish: Natural
- Colour: Matt Polyurethane Sealant
- Size: 800mm Diameter
- Other: Free Standing

PERGOLA
- Product: Bespoke Steel Fixed Pergola
- Finish: Powder Coated
- Colour: RAL 8029 - Pearl Copper
- Size: 8000mm X 4000mm
- Other: Fixed Below Ground
- Supplier: CUBE Street Furniture

LOUNGER SEATING
- Product: Freestanding Furniture
-Timber/ steel with cushioned seating
- Supplier: W Outdoor Living

BENCH SEATING
- Product: Steel/ Timber Bench
- Finish: Timber Natural - Steel Powder coated
- Colour: RAL 8029 to steel frame
- Size: 1800mm x 450mm H x 470/700mm seat depth
- Supplier: CUBE Street Furniture

SMALL DINING TABLE
- Pic nic Table & Bench
- Finish: Timber Natural - Steel Powder coated
- Colour: Powder Coated RAL 8029
- Size: 3000mm x 800mm x 745mm
- Supplier: CUBE Street Furniture

LARGE DINING TABLE
- Finish: Timber Natural - Steel Powder coated
- Colour: Powder Coated RAL 8029
- Size: 8000mm x 1200mm x 745mm
- Supplier: CUBE Street Furniture

CHAISE LOUNGER
Supplier: CUBE Street Furniture
Product: Timber / Steel Lounging chair

~~**RAISED PLANTER**~~ REMOVED
~~- Product: GRP Raised planters~~
~~- Finish: Powder Coated~~
~~- Colour: RAL 8029~~
~~- Size: Length to suit patio widths x 600mm H x 500mm Width~~
~~- Supplier: Europlanters or Similar Approved~~

LIGHTING

FESTOON LIGHTING COLUMN
- Product: External Festoon Lighting
- Notes: Attached to poles - eyelets to top on pc
- Colour : RAL 8029
- Pole Size: 3m H x 80mm dia pole
- Fixing: As designed/ supplied by fabricator
- Supplier: CUBE Street Furniture

ILLUMINATED BOLLARD
Product: Rusty Slot Light
Size: 120mm x 120mm x 800mm
Fixing: Root fixed to concrete pad
Colour: Coreten finish
Supplier: SLV

Revision	Date	Description	Drawn	Approved
S5-P09	14-04-25	For Construction	SB	NW
S5-P08	08-04-25	Raised planters omitted	SB	NW
S5-P07	20-03-25	Notes to Key added	SB	NW
S5-P06	14-02-25	Raised Planters added to key & dwg	SB	NW
S5-P05	07-02-25	Patio Railings/ Gates added	SB	NW
S5-P04	02-12-24	Furniture specifications added	SB	NW
S5-P03	18-10-24	For Construction	SB	NW
S4-P02	24-05-24	For Comment	PH	NW
S4-P01	07-02-24	First Issue	NW	CB

WRIGHT LANDSCAPES LIMITED

E: info@wrightlandscapes.co.uk
W: www.wrightlandscapes.co.uk
T: 01244 541959

HEAD OFFICE
Pickmere Lane, Pickmere, Knutsford,
WA16 0JL

CLIENT DOMIS CONSTRUCTION

PROJECT WATERHOUSE GARDENS

DRAWING TITLE Podium Furniture & Lighting Plan

DATE	SCALE
06/02/2024	AS NOTED
DRAWN	**SIZE**
NW	A1
APPROVED	**WORKSTAGE**
CB	Stage 5

DRAWING NUMBER 1174-WRI-XX-XX-DR-L-0007
SUITABILITY S5
REVISION P09

© Wright Landscapes Limited