



LINER LAP = 150mm

800mm CTR MAX BRACKET SPACING

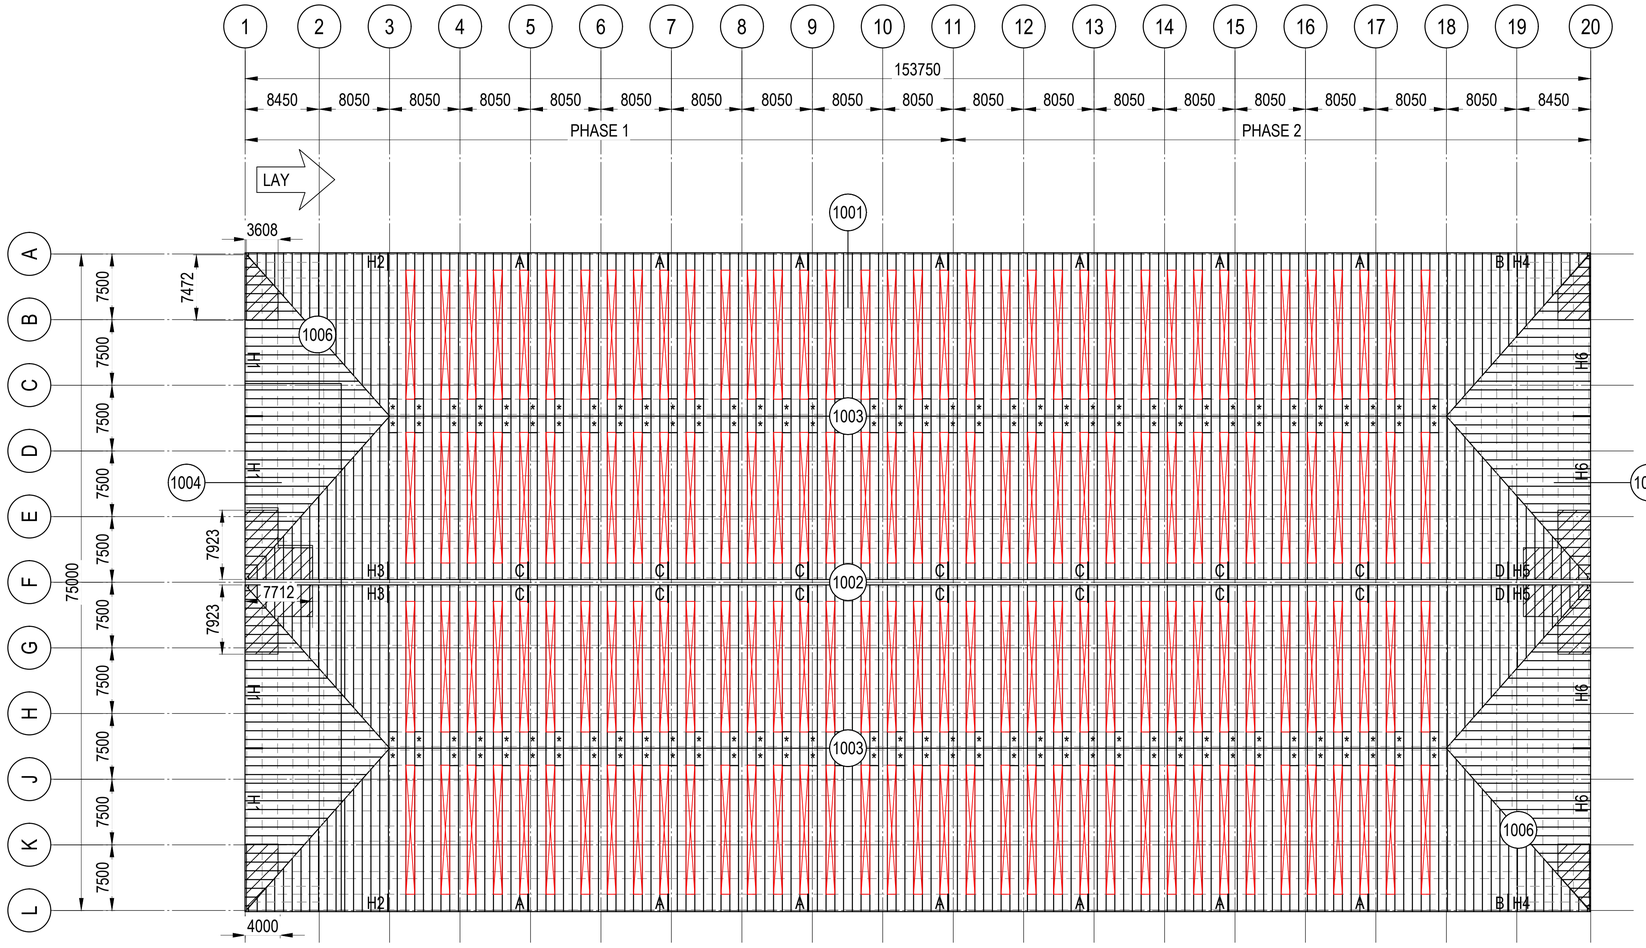

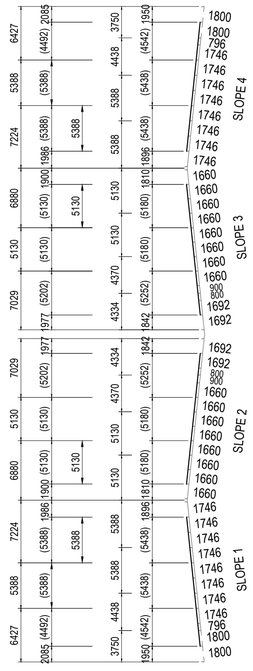

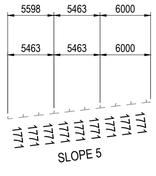

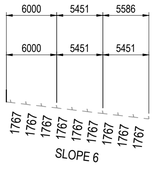

NOTES.

1. THIS DRAWING IS COPYRIGHT AND IS SENT TO YOU IN CONFIDENCE.IT MUST NOT BE COPIED,USED OR DISCLOSED IN WHOLE OR IN PART,TO THIRD PARTIES WITHOUT OUR WRITTEN PERMISSION. IT REMAINS THE PROPERTY OF FK CONSTRUCTION LIMITED AND MUST BE RETURNED ON REQUEST.

ROOFLIGHT CALCULATION
TOTAL FLOOR AREA = 10870m²
20% OF TOTAL AREA = 2174m²
74 No. ROOFLIGHTS AT 15.014m² = 1111.036m²
74 No. ROOFLIGHTS AT 14.820m² = 1096.68m²

ROOFLIGHT AREA = 2207.716m² (20.31%)

AS BUILT

REV	DETAILS	DATE
AB01	AS BUILT	17/01/20
C01	ISSUED FOR CONSTRUCTION	15/01/20
P01	ISSUED FOR COMMENT	10/10/19

KEENAN HOUSE
22-26 STOCKPORT ROAD
ALTRINCHAM
WA15 8EX

OFFICE TELEPHONE:0161 926 1350
www.fkgroup.co.uk

DRAWN BY	CHKD BY	DATE	SCALE
GDB		23/09/19	1:350

CLIENT
McLAREN CONSTRUCTION

CONTRACT
DNATA - MANCHESTER AIRPORT

DRAWING TITLE
ROOF PLAN

DRAWING No. C3353-0001 AB01

DOC REF.