KEY PLAN:

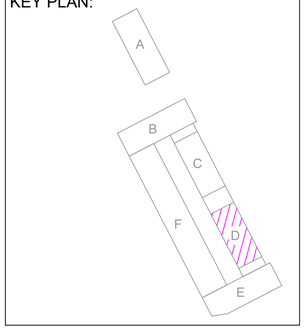

ALL DIMENSIONS ARE IN MILLIMETRES

IF IN DOUBT ASK

NOTE:

THE SMOKE SHAFT IS A BUILDERS WORK RISER (NOT IN VENT'S SCOPE OF WORKS). IT MUST BE TO THE AGREED DIMENSIONS, WITH A SMOOTH INTERNAL FINISH & SUFFICIENTLY SEALED TO LIMIT THE LEAKAGE RATE TO 3.8m³/h/m² AT 50 Pa. NO OTHER BUILDING SERVICES SHOULD BE CONTAINED WITHIN THE SMOKE SHAFT.

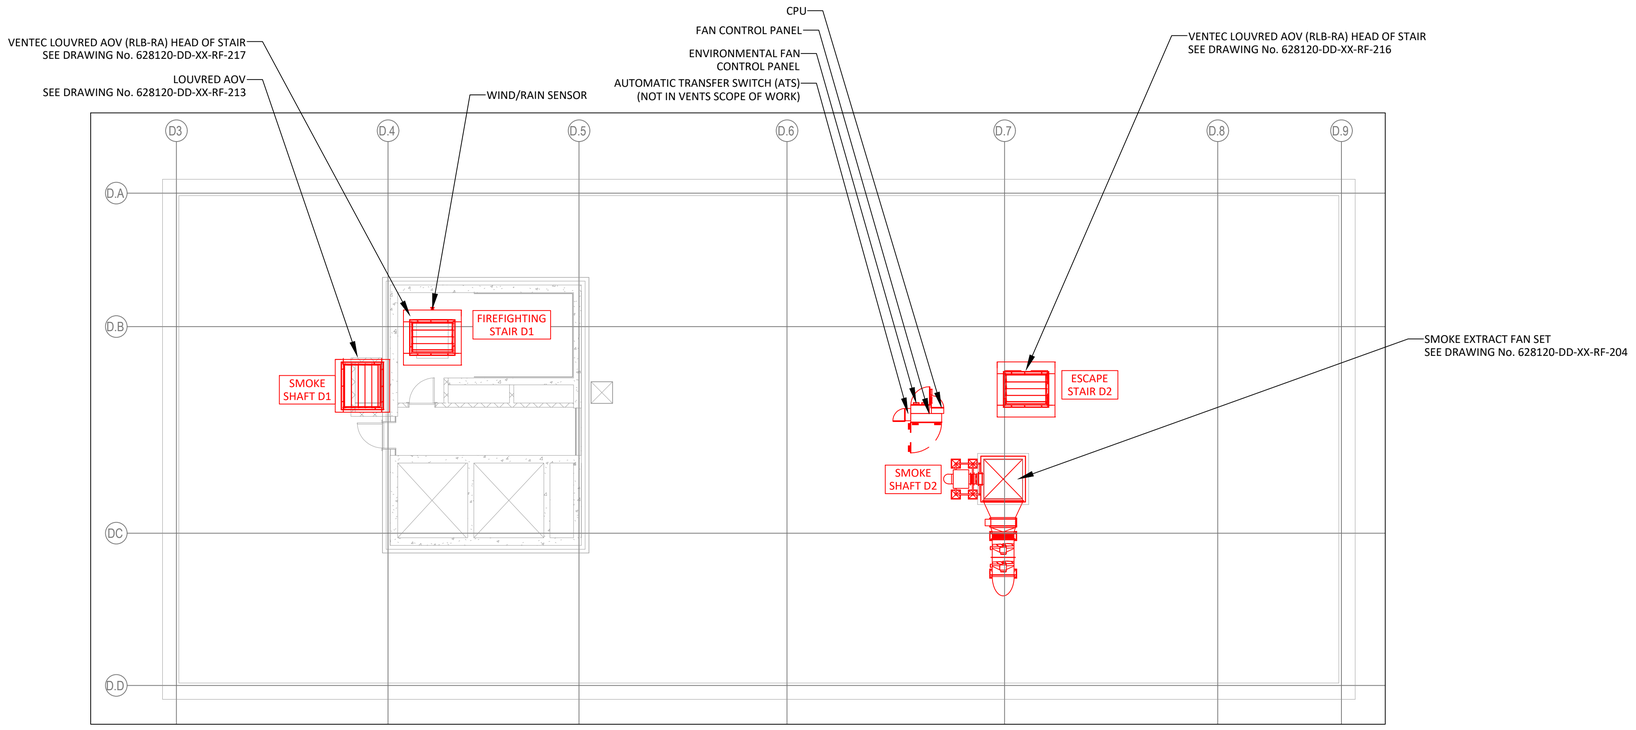

BLOCK D LEVEL 11 (ROOF)

(SCALE 1:100)

BACKGROUND DETAIL TAKEN FROM: Architects 'Studio Power'
Drawing No. 0022-SP-B3-02-DR-A-03361 REV: T1

REV	DATE	DETAILS	DRW BY	CHK BY
AB0	17.10.24	AS BUILT CR13	HW	AJM
CO0	10.10.24	CONSTRUCTION ISSUE CR09	HW	AJM
R02	23.08.24	UPSTAND SIZES UPDATED HEAD OF STAIR NO. UPDATED CR06/07	MC	AJM
R01	20.02.24	STAIR ACCESS AOV & INLET SHAFT UPDATED WITH NEW No. LAYOUT UPDATED CR03 & CR04	RA	AJM
R00	11.01.24	FIRST ISSUE FOR APPROVAL	RA	AM

DRAWING REVISION DETAILS

vent engineering
natural and smoke ventilation systems

VENTEC HOUSE
UNIT 16 CHALWYN INDUSTRIAL ESTATE
POOLE, DORSET. BH12 4PE
TEL. +44(0)1202 744958
www.vent.co.uk

© 2023 Ventec 100 Ltd

CLIENT:
MATIC BUILDING SERVICES LTD

PROJECT:
WATERHOUSE GARDENS
MANCHESTER

SALES ORDER No:
628120

DRAWING TITLE:
FLOOR PLAN FOR BLOCK D
LEVEL 11 (ROOF)

DRAWING STATUS:
◯ APPROVAL
◯ CONSTRUCTION
⊗ AS BUILT

DRAWN:	DATE:	SCALE:	SHEET:
RA	11.01.24	AS SHOWN	A1

DRAWING No.: 628120-FP-BD-RF-119
REV: AB0