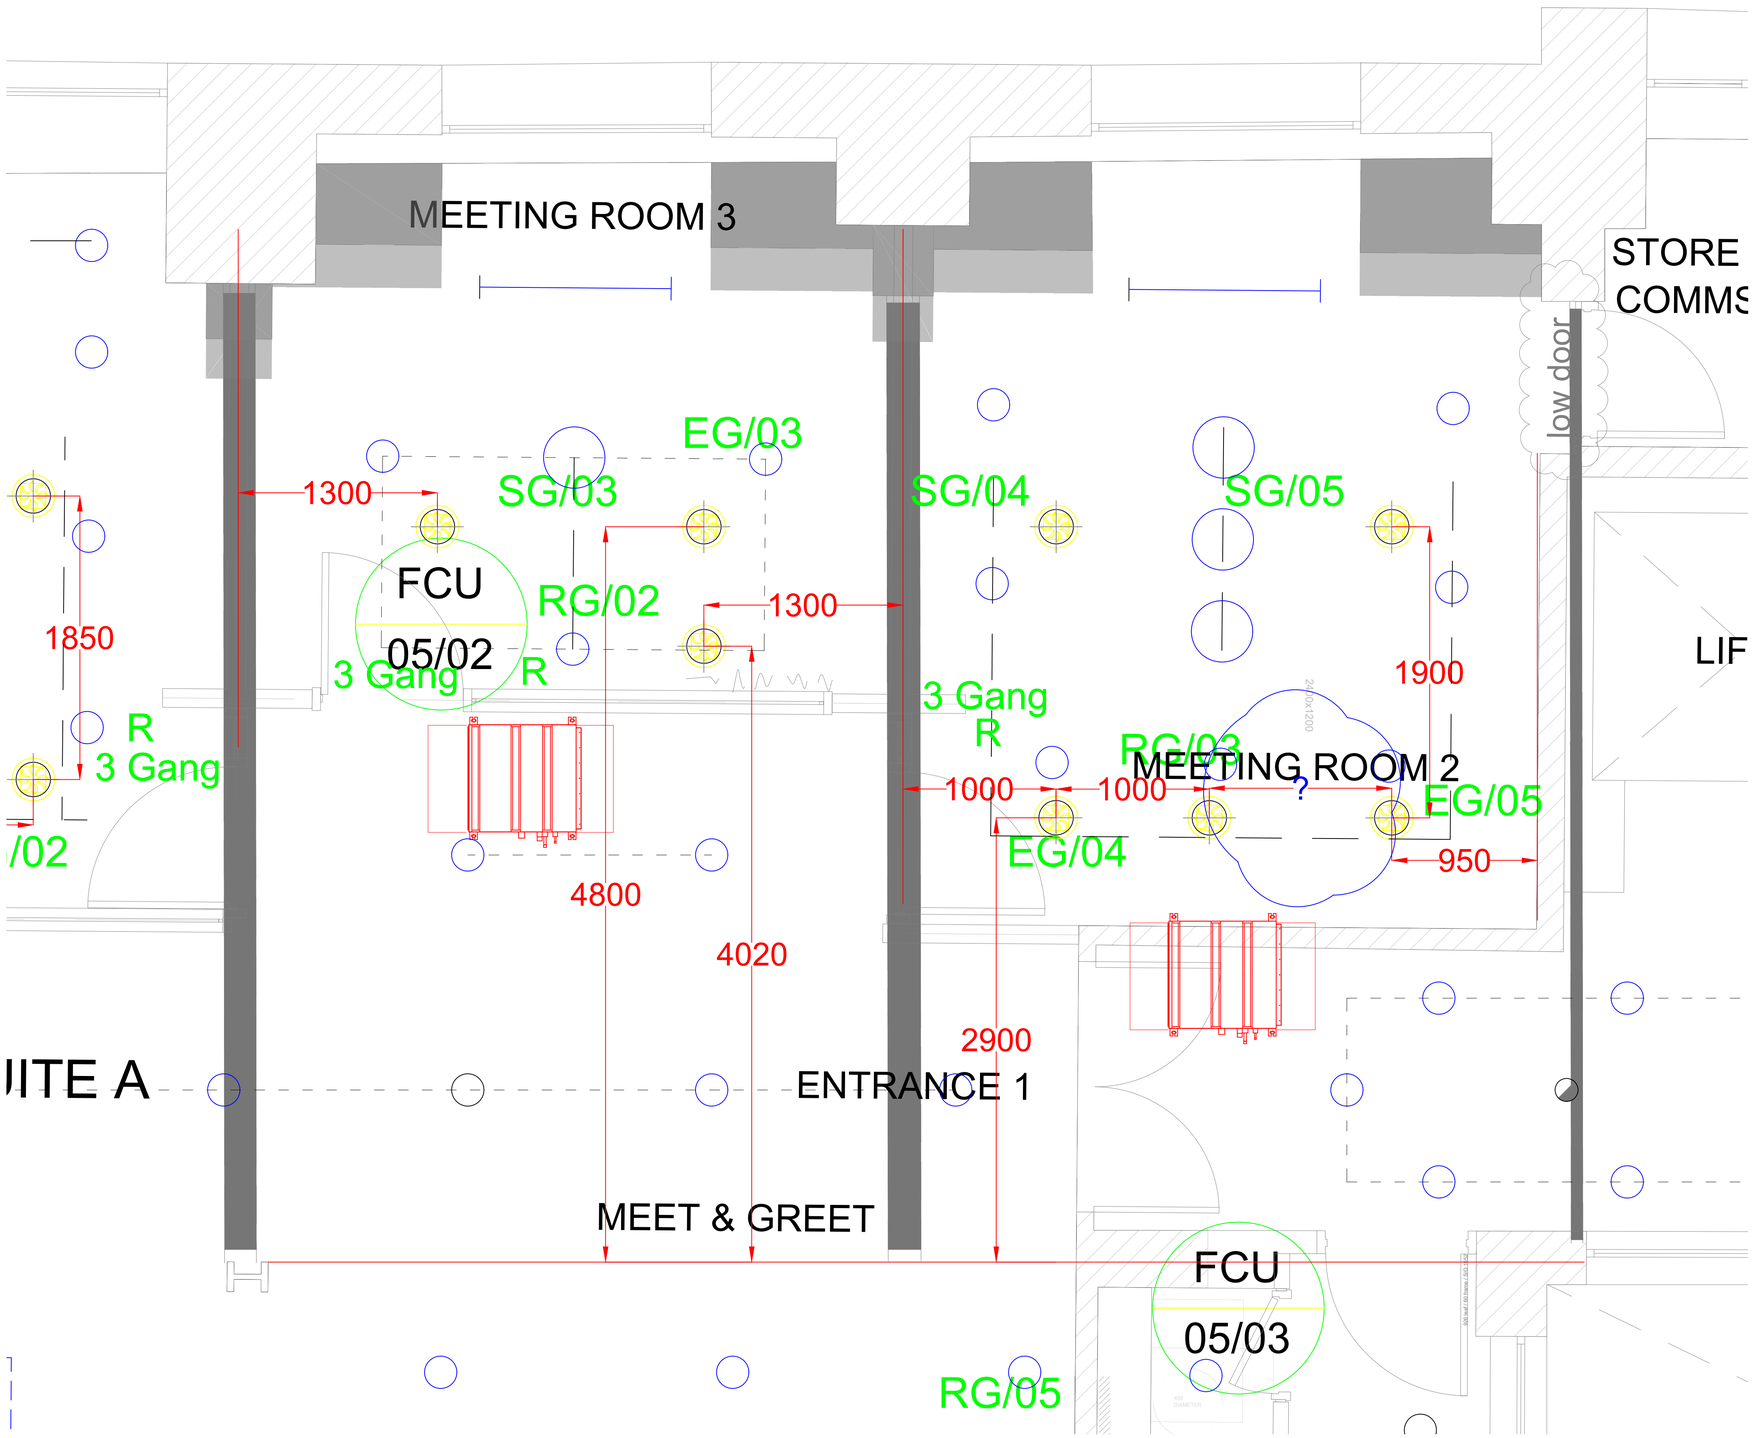


REVISION A AMENDED FOLLOWING COMMENTS	DRAWN	DH	DATE 25/11/24

DRAWING STATUS

	SKETCH		BUILDING REGS
	PRELIMINARY		TENDER
	APPROVAL		CONSTRUCTION
	PLANNING		DRAFT AS BUILT

ozone Cooling Solutions Ltd

OZONE COOLING SOLUTIONS LTD
| Unit D5, Gate 4 | Meltham Mills Ind Est |
Huddersfield | HD9 4DS |

PROJECT
196 DEANSGATE

DRAWING
FCU 05 /02 & 3 SETTING OUT

SCALE AT A1	DATE	DRAWN BY	CHECKED BY
1:50@A1	NOV/24	DMH	RD

DRAWING No.	CONTRACT No.	REVISION
M15	C2024-2367	A

© COPYRIGHT:
ALL RIGHTS RESERVED.
THIS DRAWING MUST NOT BE REPRODUCED WITHOUT PERMISSION.
DO NOT SCALE.
THE CONTRACTOR IS RESPONSIBLE FOR CHECKING DIMENSIONS
WHICH ARE IN MILLIMETRES, UNLESS OTHERWISE STATED.