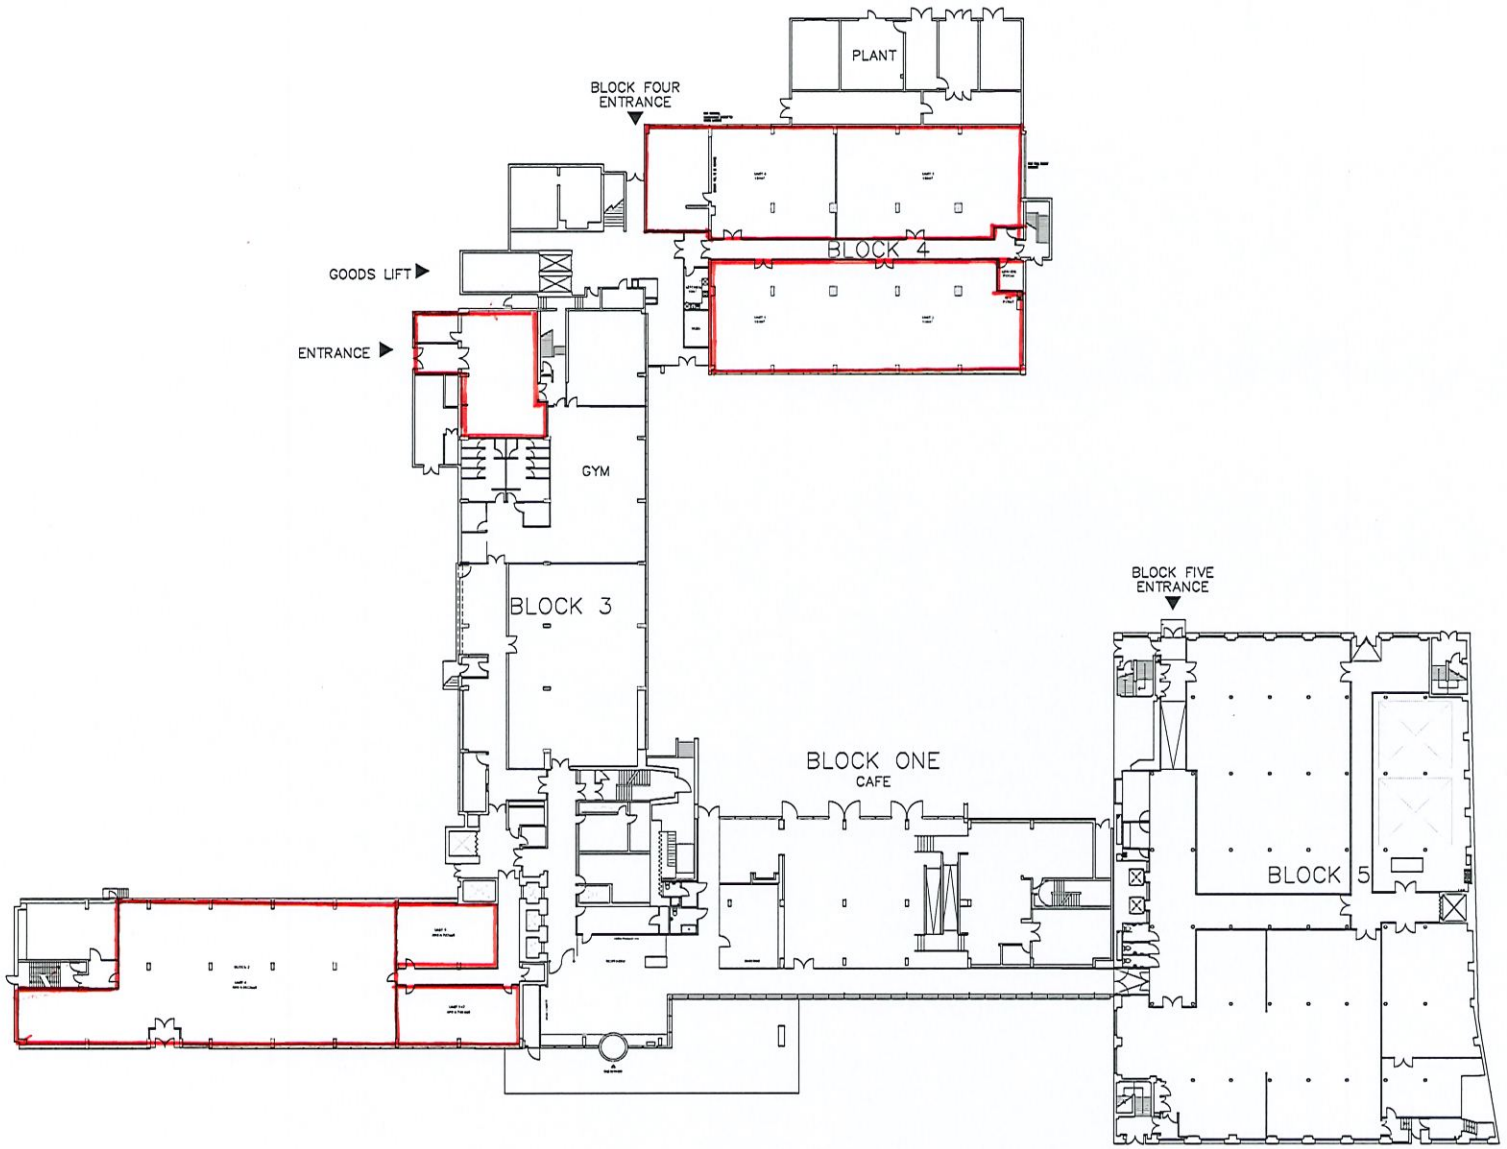

GROUND FLOOR AS BUILT GA PLANS

SCALE 1 : 250

© The copyright in this drawing is vested in CodaStudios and no license or assignment of any kind has been, or is, granted to any third party whether by provision of copies or originals or otherwise unless agreed in writing.

DO NOT SCALE FROM THIS DRAWING
The contractor shall check and verify all dimensions on site and report any discrepancies in writing to CodaStudios before proceeding work

FOR ELECTRONIC DATA ISSUE
Electronic Data / drawings are issued as "read only" and should not be interrogated for measurement. All dimensions and levels should read, only from those values stated in text, on the drawing.
When issued for information/comment/coordination values,levels, buildups or dimensions are suitable to change. Suitability Code and Purpose for issue must be consistent as per ISO 19650. Otherwise, must be reported to CodaStudios immediately. CodaStudios is not responsible for works carried out when a discrepancy on this exist.

AREA MEASUREMENT
The areas are approximate and can only be verified by a detailed dimensional survey of the completed building. Any decisions to be made on the basis of these predictions, whether as to project viability, pre-letting, lease agreements or otherwise, should include due allowance for the increases and decreases inherent in the design development and building processes. Existing buildings may present anomalies in relation to surveyed/drawn plans that may also effect the stated areas. All areas are subject to Town Planning and Conservation Area Consent and detailed Rights to Light analysis.
Figures relate to the likely areas of the building at the current stage of the design and are calculated using one of the following (as stated in the accompanying areas schedule) IPM 01, IPM 02, IPM 03, Gross External Area (GEA), Gross Internal Area (GIA) or Nett Internal Area (NIA) methods of measurement from the RICS Property Measurement 1st edition.

BIM COORDINATION
Coda Studios is not responsible for discrepancies caused by manual location of other parties BIM/FC model. All parties must follow the same agreed standard such as share positioning in relation to world coordinates.

Revision		Date	Drawn	Checked
A	FIRST ISSUE	-	-	JH

CLIENT
MCR PROPERTY LTD.

CODA Architecture

CODA Studios Ltd, 70-71 Cornish Place, Cornish St, Sheffield, S6 3AF
T: 0114 279 6003 E: information@codastudios.co.uk

PROJECT
UNIVERSAL SQUARE

Drawn	Checked	Date	Scale @A1
LC	JH	09.20	1:250

Title
UNIVERSAL SQUARE

Description
GROUND FLOOR GA PLAN - AS-BUILT

STAGE 7

Suitability Code	Purpose for Issue
A1	AS BUILT INFORMATION

Drawing No
2475 CDA AB 00 3500 A
(Project, Originator, Volume, Level, Type, Role, Number, Revision)

© The copyright in this drawing is vested in CodaStudios and no license or assignment of any kind has been, or is, granted to any third party whether by provision of copies or originals or otherwise unless agreed in writing.

DO NOT SCALE FROM THIS DRAWING
The contractor shall check and verify all dimensions on site and report any discrepancies in writing to CodaStudios before proceeding work

FOR ELECTRONIC DATA ISSUE
Electronic Data / drawings are issued as "read only" and should not be interrogated for measurement. All dimensions and levels should read, only from those values stated in text, on the drawing.
When issued for information/comments/coordination values,levels, buildups or dimensions are suitable to change. Suitability Code and Purpose for issue must be consistent as per ISO 19650. Otherwise, must be reported to CodaStudios immediately. CodaStudios is not responsible for works carried out when a discrepancy on this exist.

AREA MEASUREMENT
The areas are approximate and can only be verified by a detailed dimensional survey of the completed building. Any decisions to be made on the basis of these predictions, whether as to project viability, pre-letting, lease agreements or otherwise, should include due allowance for the increases and decreases inherent in the design development and building processes. Existing buildings may present anomalies in relation to surveyed/drawn plans that may also effect the stated areas. All areas are subject to Town Planning and Conservation Area Consent and detailed Rights to Light analysis.
Figures relate to the likely areas of the building at the current stage of the design and are calculated using one of the following (as stated in the accompanying areas schedule) IPM G1, IPM G2, IPM G3, Gross External Area (GEA), Gross Internal Area (GIA) or Nett Internal Area (NIA) methods of measurement from the RICS Property Measurement 1st edition.

BIM COORDINATION
Coda Studios is not responsible for discrepancies caused by manual location of other parties BIM/FC model. All parties must follow the same agreed standard such as share positioning in relation to world coordinates.

Revision		Date	Drawn	Checked
A	FIRST ISSUE	-	-	JH

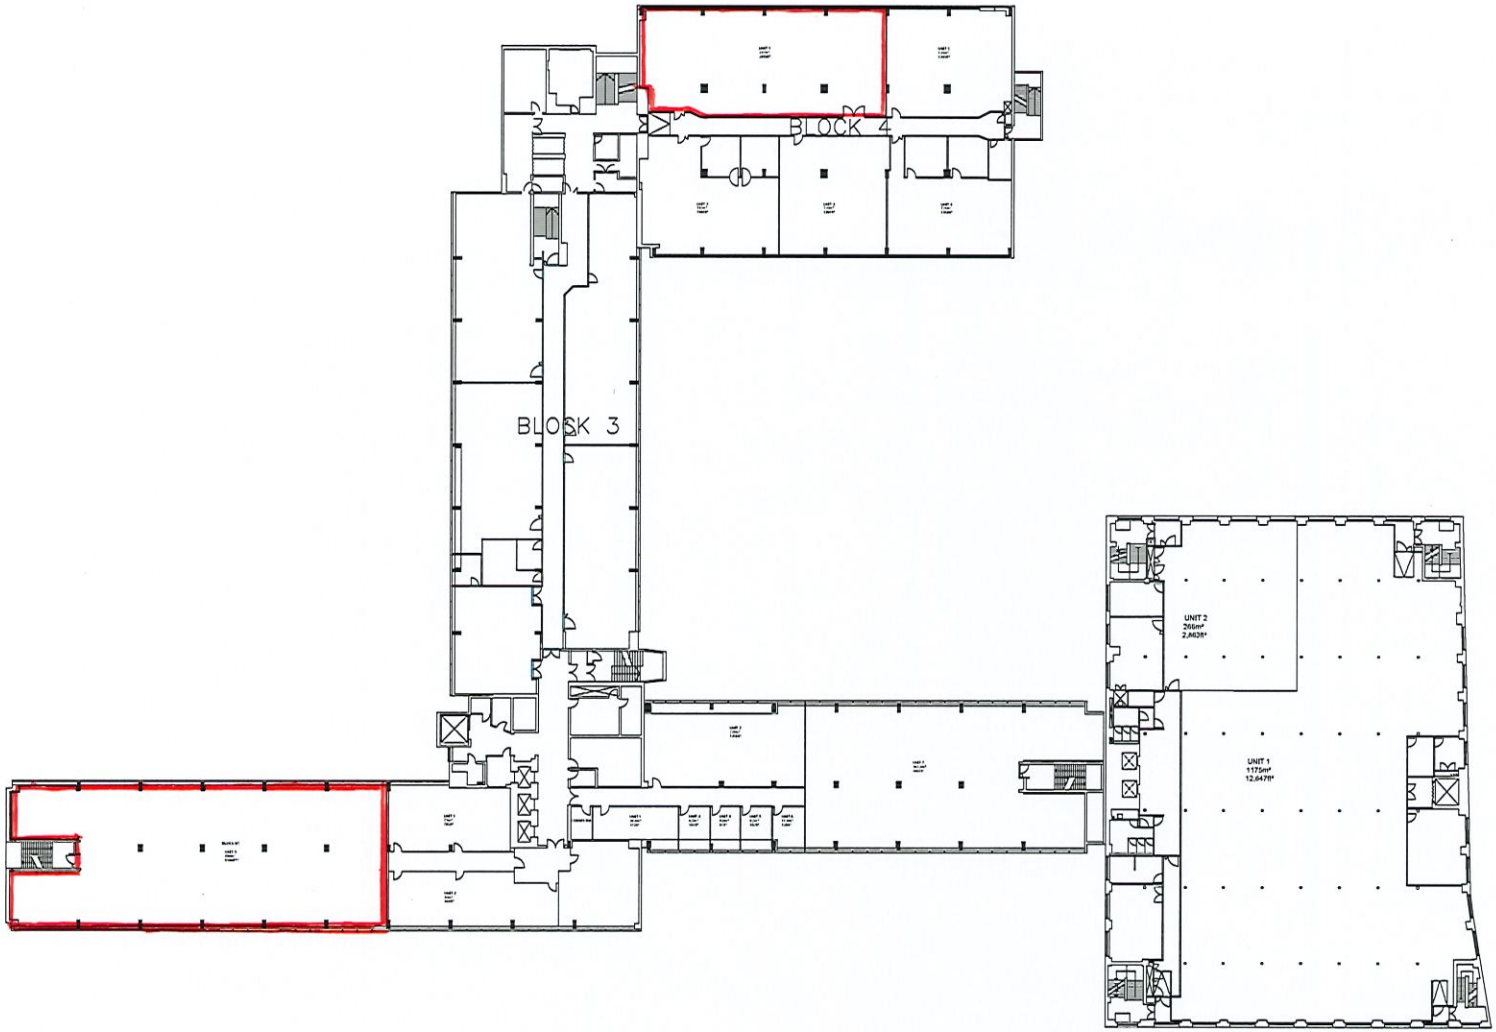

FIRST FLOOR AS BUILT GA PLANS
SCALE 1 : 250

CLIENT
MCR PROPERTY LTD.

CODA Architecture
CODA Studios Ltd. 70-71 Cornish Place. Cornish St. Sheffield, S6 3AF
T: 0114 279 6003 E: information@codastudios.co.uk

PROJECT
UNIVERSAL SQUARE, MANCHESTER

Drawn	Checked	Date	Scale @A1
LC	JH	09.20	1:250

Title
UNIVERSAL SQUARE

Description
FIRST FLOOR GA PLAN - AS BUILT

STAGE 7

Suitability Code	Purpose for issue
A1	AS BUILT INFORMATION

Drawing No
2475 CDA AB 01 - - 3501 A
(Project · Originator · Volume · Level · Type · Role · Number · Revision)

© The copyright in this drawing is vested in CodaStudios and no license or assignment of any kind has been, or is, granted to any third party whether by provision of copies or originals or otherwise unless agreed in writing.

DO NOT SCALE FROM THIS DRAWING
The contractor shall check and verify all dimensions on site and report any discrepancies in writing to CodaStudios before proceeding work

FOR ELECTRONIC DATA ISSUE
Electronic Data / drawings are issued as "read only" and should not be interrogated for measurement. All dimensions and levels should read, only from those values stated in text, on the drawing.
When issued for information/comments/coordination values,levels, buildups or dimensions are suitable to change, Suitability Code and Purpose for Issue must be consistent as per ISO 19650. Otherwise, must be reported to CodaStudios immediately. CodaStudios is not responsible for works carried out when a discrepancy on this exist.

AREA MEASUREMENT
The areas are approximate and can only be verified by a detailed dimensional survey of the completed building. Any decisions to be made on the basis of these predictions, whether as to project viability, pre-letting, lease agreements or otherwise, should include due allowance for the increases and decreases inherent in the design development and building processes. Existing buildings may present anomalies in relation to surveyed/drawn plans that may also effect the stated areas. All areas are subject to Town Planning and Conservation Area Consent and detailed Rights to Light analysis.
Figures relate to the likely areas of the building at the current stage of the design and are calculated using one of the following (as stated in the accompanying areas schedule) IPM G1, IPM G2, IPM G3, Gross External Area (GEA), Gross Internal Area (GIA) or NIA Internal Area (NIA) methods of measurement from the RICS Property Measurement 1st edition.

BIM COORDINATION
Coda Studios is not responsible for discrepancies caused by manual location of other parties BIM/FC model. All parties must follow the same agreed standard such as share positioning in relation to world coordinates.

Revision		Date	Drawn	Checked
A	FIRST ISSUE	-	-	JH

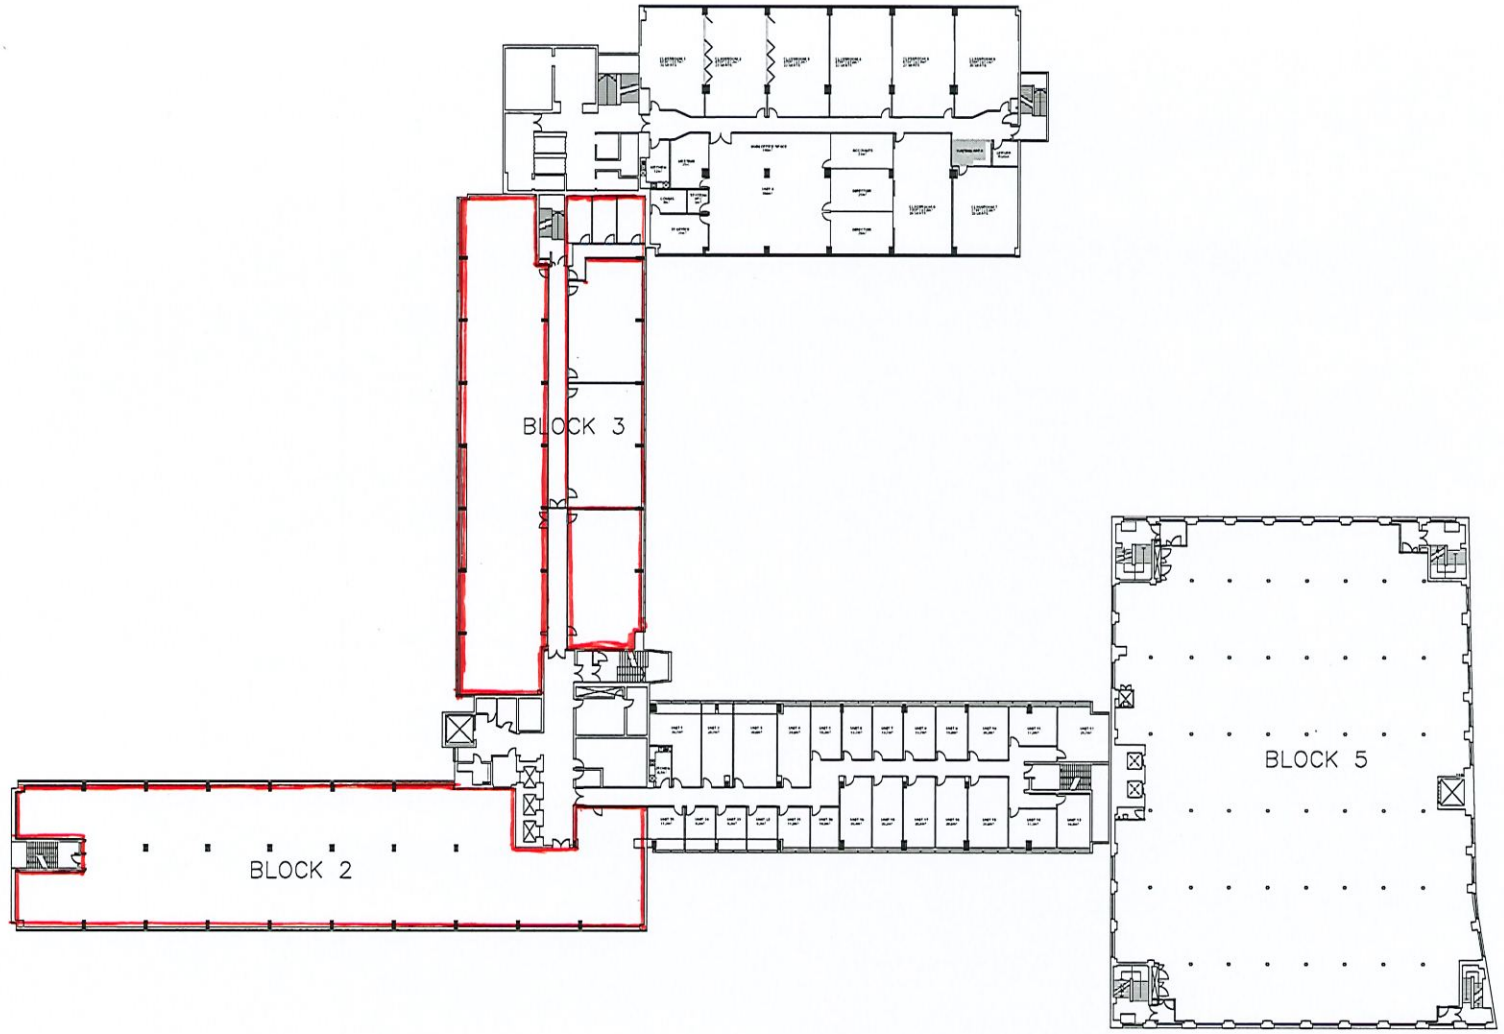

THIRD FLOOR AS BUILT GA PLANS
SCALE 1 : 250

CLIENT
MCR PROPERTY LTD.

CODA Architecture
CODA Studios Ltd. 70-71 Cornish Place, Cornish St. Sheffield, S6 3AF
T: 0114 279 6003 E: information@codastudios.co.uk

PROJECT
UNIVERSAL SQUARE, MANCHESTER

Drawn	Checked	Date	Scale @A1
LC	JH	09.20	1:250

Title
UNIVERSAL SQUARE

Description
THIRD FLOOR GA PLAN - AS BUILT

STAGE 7

Suitability Code	Purpose for Issue
A1	AS BUILT INFORMATION

Drawing No

Project	Originator	Volume	Level	Type	Role	Number	Revision
2475	CDA	AB	03			3503	A

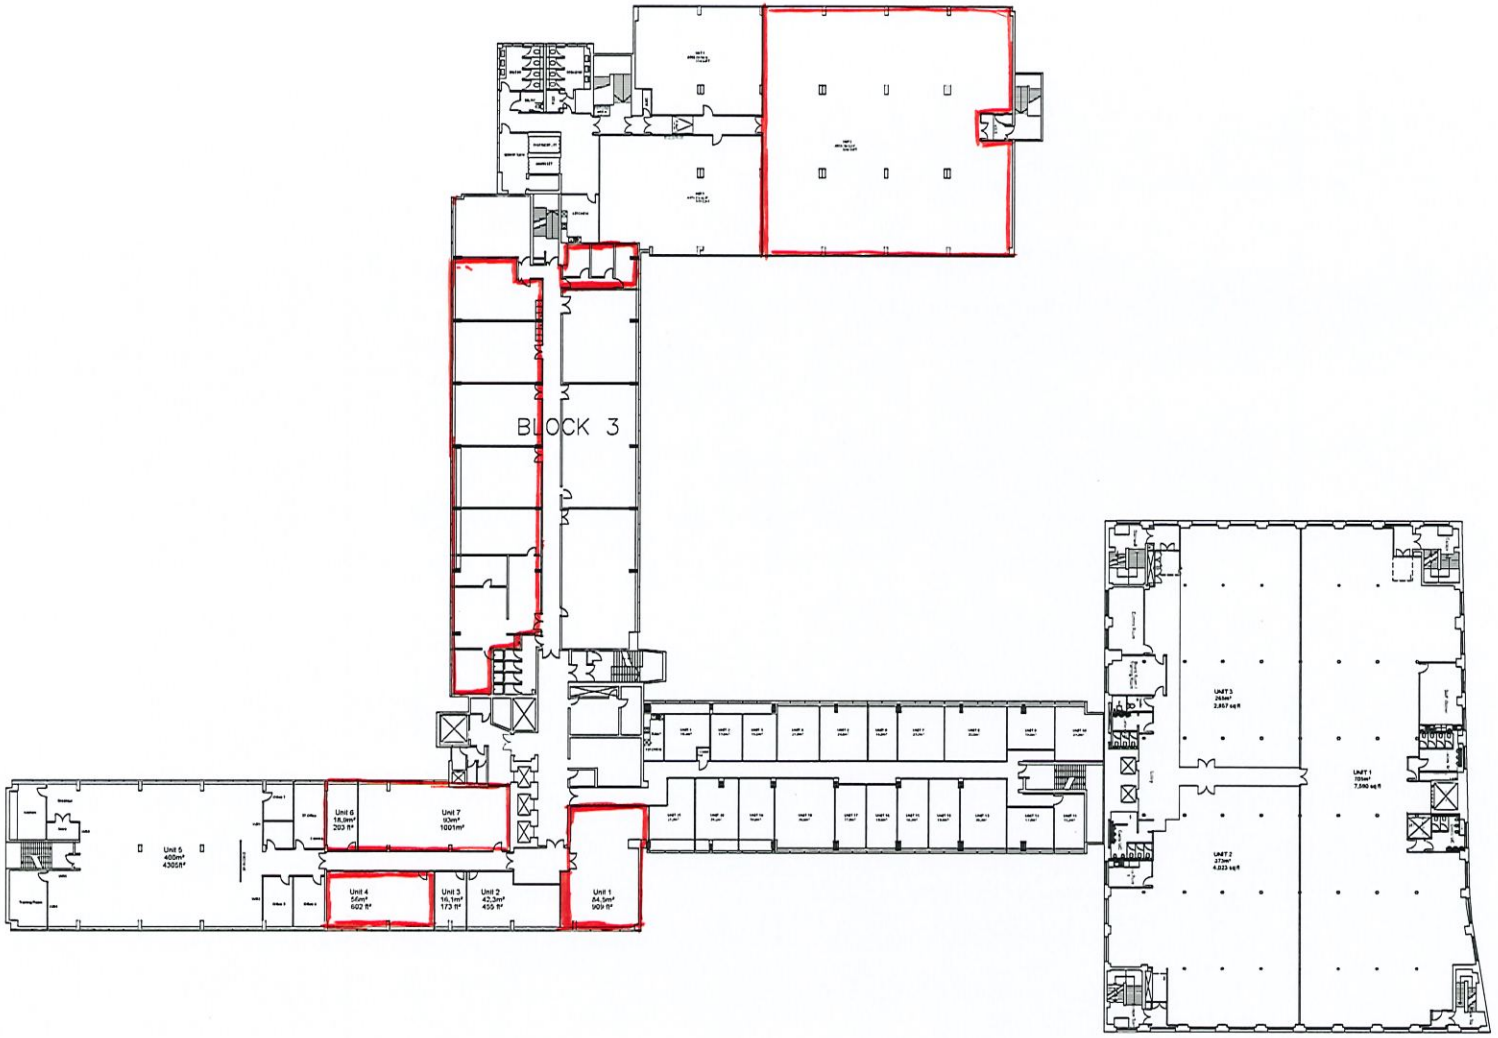

FOURTH FLOOR AS BUILT GA PLANS

SCALE 1 : 250

A1

© The copyright in this drawing is vested in CodaStudios and no license or assignment of any kind has been, or is, granted to any third party whether by provision of copies or originals or otherwise unless agreed in writing.

DO NOT SCALE FROM THIS DRAWING
The contractor shall check and verify all dimensions on site and report any discrepancies in writing to CodaStudios before proceeding work

FOR ELECTRONIC DATA ISSUE
Electronic Data / drawings are issued as "read only" and should not be interrogated for measurement. All dimensions and levels should read, only from those values stated in text, on the drawing.
When issued for information/comments/coordination values,levels, buildups or dimensions are suitable to change, Suitability Code and Purpose for issue must be consistent as per ISO 19650. Otherwise, must be reported to CodaStudios immediately. CodaStudios is not responsible for works carried out when a discrepancy on this exist.

AREA MEASUREMENT
The areas are approximate and can only be verified by a detailed dimensional survey of the completed building. Any decisions to be made on the basis of these predictions, whether as to project viability, pre-letting, lease agreements or otherwise, should include due allowance for the increases and decreases inherent in the design development and building processes. Existing buildings may present anomalies in relation to surveyed/drawn plans that may also affect the stated areas. All areas are subject to Town Planning and Conservation Area Consent and detailed Rights to Light analysis.
Figures relate to the likely areas of the building at the current stage of the design and are calculated using one of the following (as stated in the accompanying areas schedule) IPM 01, IPM 02, IPM 03, Gross External Area (GEA), Gross Internal Area (GIA) or Nett Internal Area (NIA) methods of measurement from the RICS Property Measurement 1st edition.

BIM COORDINATION
Coda Studios is not responsible for discrepancies caused by manual location of other parties BIM/FC model. All parties must follow the same agreed standard such as share positioning in relation to world coordinates.

Revision		Date	Drawn	Checked
A	FIRST ISSUE	-	-	JH

CLIENT
MCR PROPERTY LTD.

CODA Architecture

CODA Studios Ltd. 70-71 Cornish Place, Cornish St. Sheffield, S6 3AF
T: 0114 279 6003 E: information@codastudios.co.uk

PROJECT
UNIVERSAL SQUARE, MANCHESTER

Drawn	Checked	Date	Scale @A1
LC	JH	09.20	1:250

Title
UNIVERSAL SQUARE

Description
FOURTH FLOOR GA PLAN - AS BUILT

STAGE 7

Suitability Code: A1
Purpose for Issue: AS BUILT INFORMATION

Drawing No: 2476 (Project) CDA (Originator) AB (Volume) 04 (Level) (Type) (Role) 3504 (Number) A (Revision)

M