



This drawing is Copyright © of Avison Young Limited.


DO NOT SCALE THIS DRAWING.
All dimensions to be checked on site.
Drawing to be read in conjunction with any specifications, schedules and Consultants drawings and details.
This drawing has been produced for the client for the project on the site shown. It was prepared for a purpose agreed with the client and will have a commensurate degree of accuracy.
It is not a record "As Built". This drawing is not intended for use by any other person or for any other purpose than that specified here. Avison Young accept no liability if this drawing is used by any other person for any other purpose.

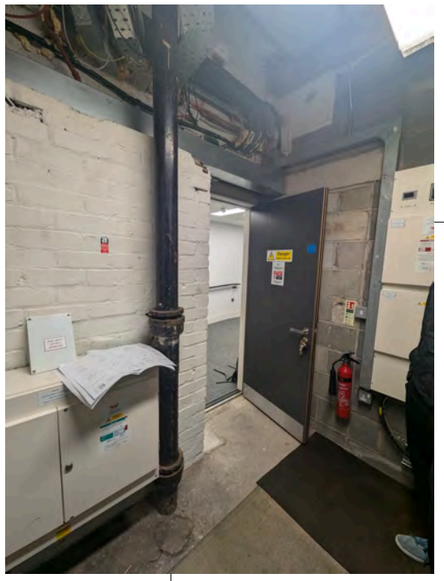

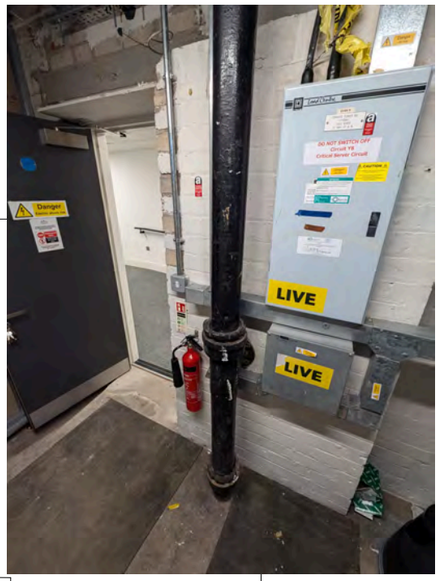

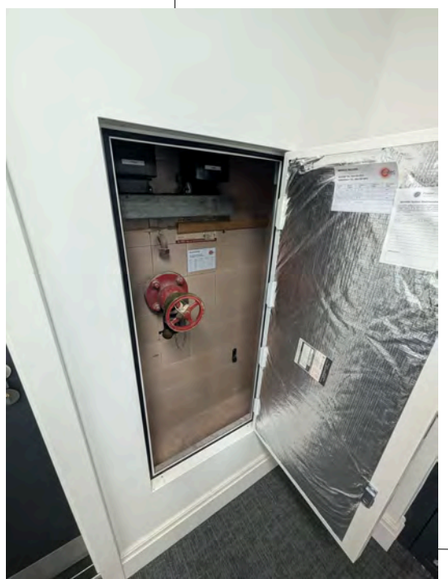

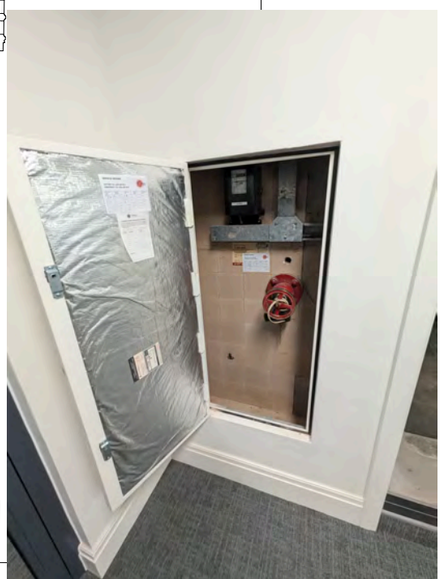

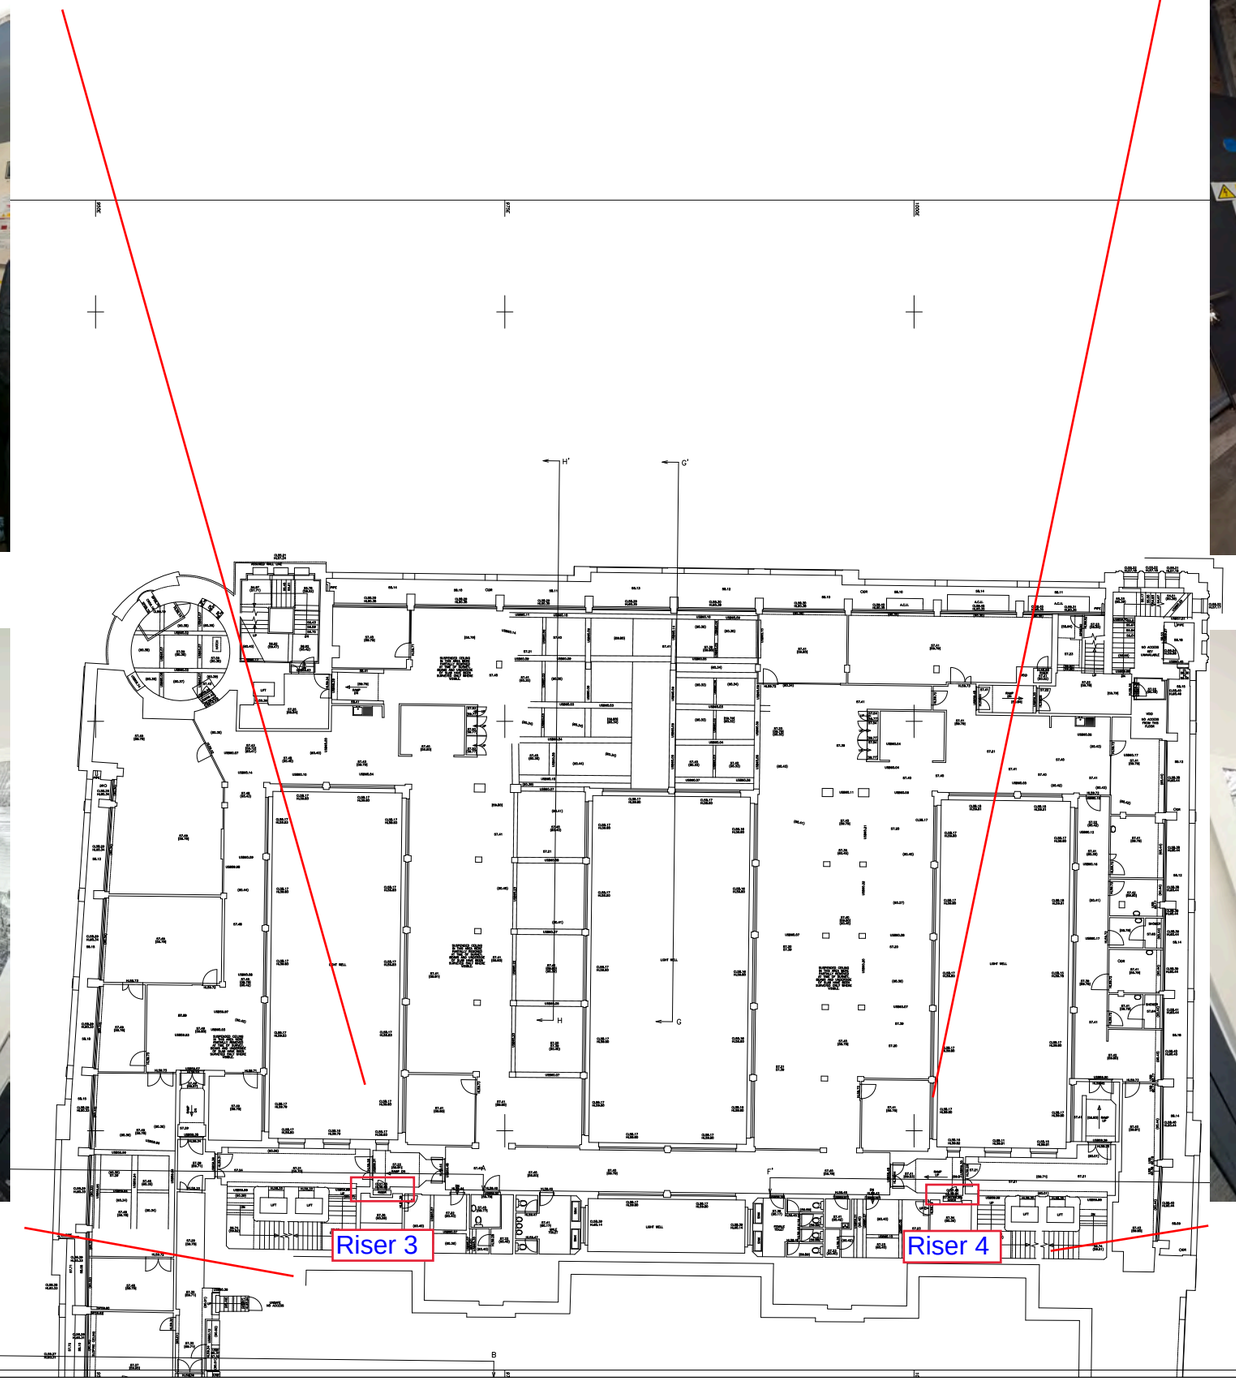

Rev	Description	By	Chk	Date

A3
Final

AVISON YOUNG
08449 02 03 04
11 York Street
Manchester
M2 2AW
www.avisonyoung.co.uk

Project Name
Wet and Dry Riser Project
Existing Wet Riser Installation

Client
Hines

Drawing Title
Fourth Floor
Existing Wet Riser Installation

Drawn By	Chk'd by	Scale @ A3	Date
JG	FL	NTS	15/11/2024

Project No.
04B700635

Drawing No.
1

Revision
A