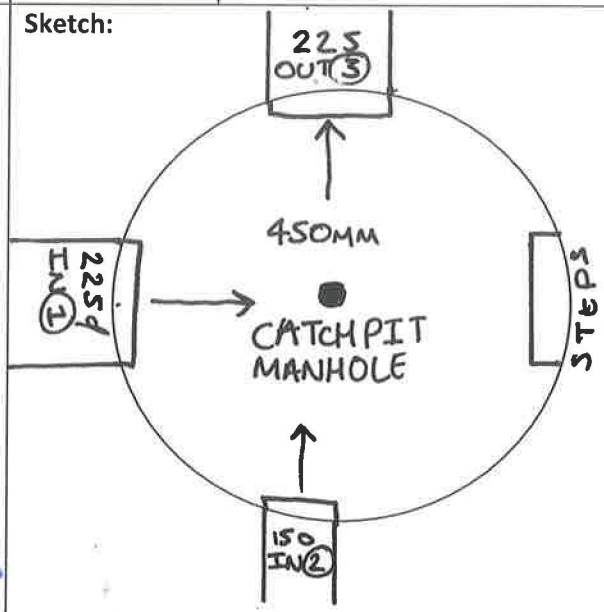
MURRAYWOOD CONSTRUCTION LTD

QA Form - Manholes

Installation of Manhole			Sheet No:	002
Project	First Street Manchester		**Date:**	
Location: **As built coordinates:** **Cover Level:**	SW03 To Drainage Schedule " " TBC	**Drawing No:**	MN2A-RAM-22-XX-DR-C 000100	
Manhole No: **Invert:**	SW03 30.075 = SUMP IL 30.525 = INCOM IL'S	**Type:** **(circle as appropriate)**	FOUL/SURFACE WATER/COMBINED	
Inverts and Diameter of pipes:	Upstream: 31.525 Dia: 225 Downstream: 30.075 Dia: 225 Inlet 1: 30.525 Dia: 225 ø Inlet 2: 30.530 Dia: 150 ø Inlet 3: 225 ø Dia: 30.525 Inlet 4: Dia: Inlet 5: Dia:	**Sketch:**		
Chamber Details:	Dia. Size: 1200ø 1x500 1x750 Overall depth: 1.875m Cover Depth: Biscuit Depth: Reducing Slab:	Position of step irons/fittings, orientation of cover/slab and branches (including backdrops) to be detailed.		

WORK TO BE INSPECTED	Accepted Yes/ No or N/a	Comments	MW Construction Eng/QA Signed as Checked:-
Setting out to drawing	Y		M.E
Trench excavation supported	Y		NO
Installation of concrete to channel	Y		NO
Installation of drainage channel/first manhole ring	Y		NO

MURRAYWOOD CONSTRUCTION LTD

QA Form - Manholes

MWC Signature confirming invert/positioning check	M · E	Date	14/3/23
Client Signature confirming invert/positioning check		Date	14/3/23

WORK TO BE INSPECTED	Accepted Yes/ No or N/A	Comments	MW Construction Eng/QA Signed as Checked:-
Installation of manhole rings to required levels	Y	Depths and No's of rings: 1x 750 1200 Twinwall 1x 500 1200 " "	MD
Installation of dropshafts/inlets above manhole invert	Y		MD
Manhole Surround	N/A	Details: Twinwall used	
Backfilling to manhole to required level and layers as instructed in spec	Y		MD
Biscuit Installation	TBC	Type:	
Benching/Water proofing to Manhole	"		
Installation of Step Irons	Y	Type & Numbers: Plastic SNO Total	MD
Brickwork	"	No of courses:	
Lid and Frame	"	Cover Type:	
Client Signature confirming Handover of Manhole:-		**Date**	14/3/23
MWC Signature confirming Handover of Manhole:-	M · E	**Date**	14/3/23




FIRST STREET
1ST
ST
MURRAYWOOD