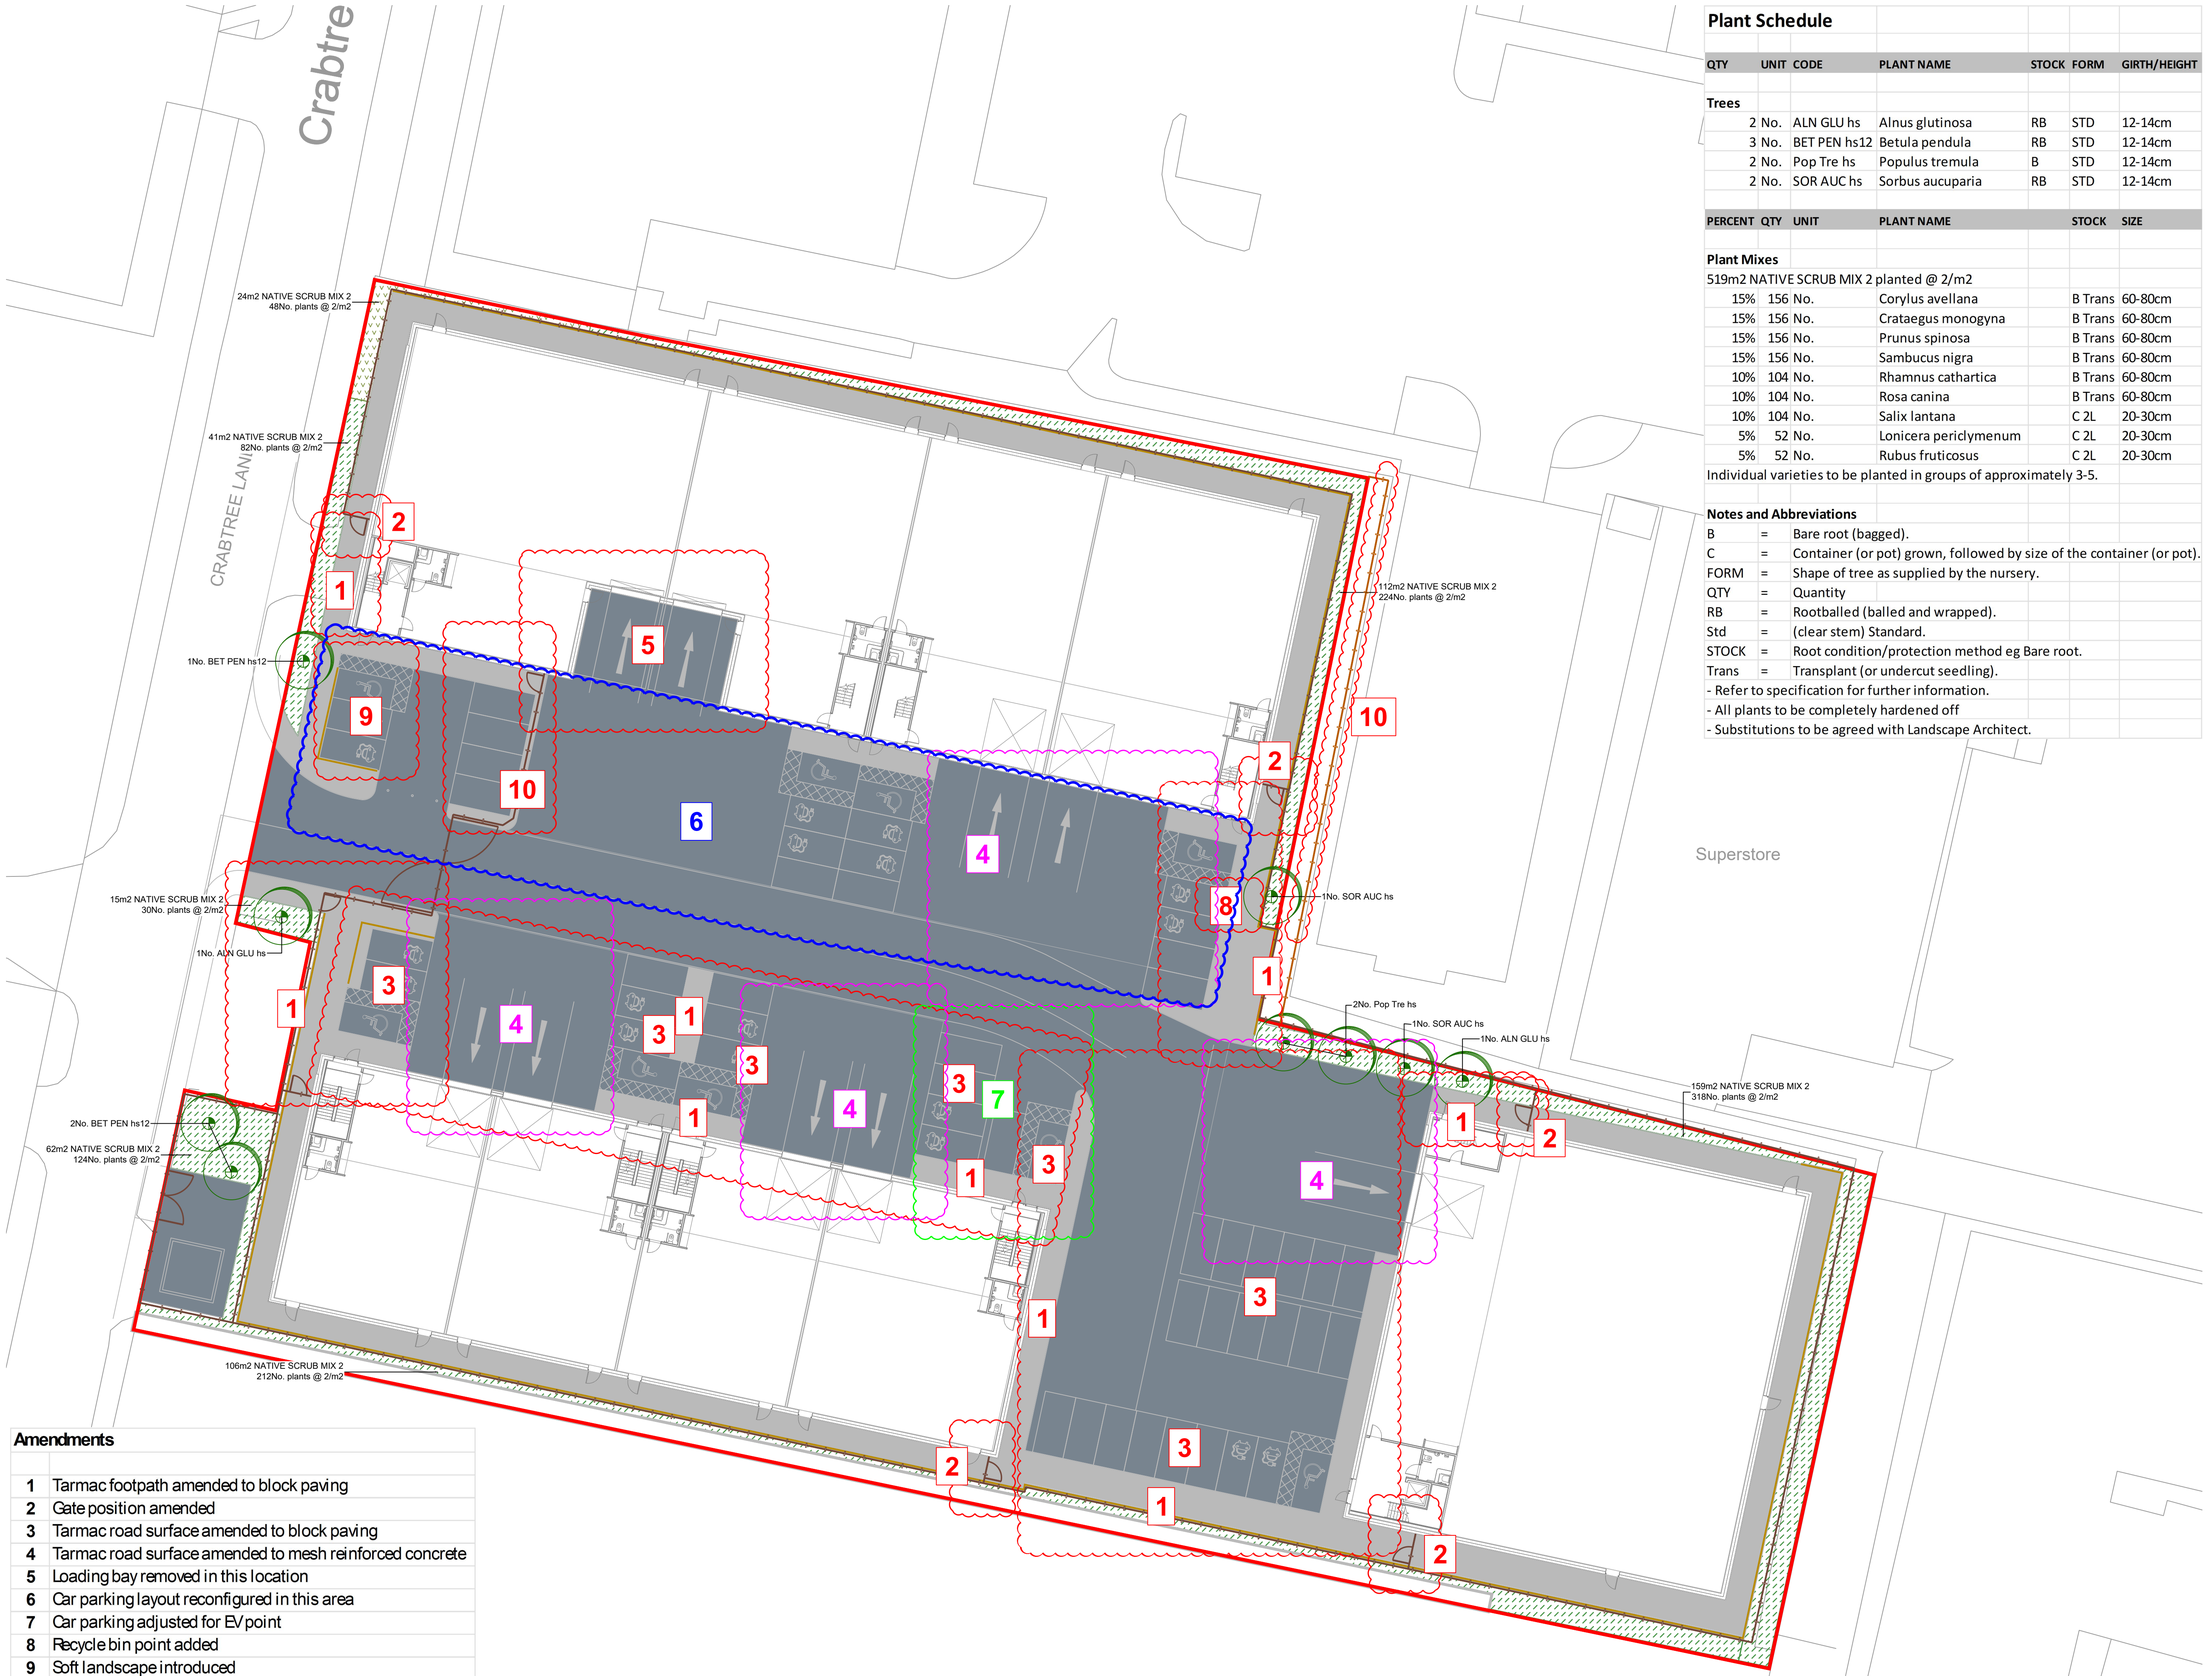


Amendments

1	Tarmac footpath amended to block paving
2	Gate position amended
3	Tarmac road surface amended to block paving
4	Tarmac road surface amended to mesh reinforced concrete
5	Loading bay removed in this location
6	Car parking layout reconfigured in this area
7	Car parking adjusted for EV point
8	Recycle bin point added
9	Soft landscape introduced
10	Fence line amended

REFER TO NEW DRAWING: UG_2066_LAN_GA_DRW_01 P11

Plant Schedule

QTY	UNIT	CODE	PLANT NAME	STOCK	FORM	GIRTH/HEIGHT
Trees						
2	No.	ALN GLU hs	Alnus glutinosa	RB	STD	12-14cm
3	No.	BET PEN hs12	Betula pendula	RB	STD	12-14cm
2	No.	Pop Tre hs	Populus tremula	B	STD	12-14cm
2	No.	SOR AUC hs	Sorbus aucuparia	RB	STD	12-14cm

PERCENT	QTY	UNIT	PLANT NAME	STOCK	SIZE
Plant Mixes					
519m2 NATIVE SCRUB MIX 2 planted @ 2/m2					
15%	156	No.	Corylus avellana	B Trans	60-80cm
15%	156	No.	Crataegus monogyna	B Trans	60-80cm
15%	156	No.	Prunus spinosa	B Trans	60-80cm
15%	156	No.	Sambucus nigra	B Trans	60-80cm
10%	104	No.	Rhamnus cathartica	B Trans	60-80cm
10%	104	No.	Rosa canina	B Trans	60-80cm
10%	104	No.	Salix lantana	C 2L	20-30cm
5%	52	No.	Lonicera periclymenum	C 2L	20-30cm
5%	52	No.	Rubus fruticosus	C 2L	20-30cm
Individual varieties to be planted in groups of approximately 3-5.					

Notes and Abbreviations

B	=	Bare root (bagged).
C	=	Container (or pot) grown, followed by size of the container (or pot).
FORM	=	Shape of tree as supplied by the nursery.
QTY	=	Quantity
RB	=	Rootballed (balled and wrapped).
Std	=	(clear stem) Standard.
STOCK	=	Root condition/protection method eg Bare root.
Trans	=	Transplant (or undercut seedling).
- Refer to specification for further information.		
- All plants to be completely hardened off		
- Substitutions to be agreed with Landscape Architect.		

Do not scale this drawing (printed or electronic version).

Contractors must check all dimensions from site

This drawing is copyright and is for use on this site only. This drawing should be read in conjunction with all relevant consultants drawings and specialist subcontractors / supply chain drawings and specifications.

All works to be carried out in accordance with the latest British Standards / Codes of Practice unless specifically directed otherwise in the specification.

Responsibility for the reproduction of this drawing in paper form, or issued in electronic format, lies with the recipient to check that all information has been replicated in full and is correct when comparedto the original paper or electronic image.

Graphical representations of equipment on this drawing have been co-ordinated, but are approximations only. Please refer to the specifications and / or details for actual sizes and / or specific contractor construction information.

Notes:-

KEY

Hard Works

- **Vehicular Asphalt Surface** — *Black colour. To engineer specification & recommendation*
- **Pedestrian Asphalt Surface** — *Black colour. To engineer specification & recommendation*
- **Propose 2.4m Paladin Fence** — Including matching gates as required
- **Retaining Wall** — *To engineer specification & recommendation*
- **Existing 2.4m Paladin Fence** — Including matching gates as required

Soft Works

- **Proposed Tree** — Refer to planting schedule.
- **Existing Native Shrub Mix** — To be retained and improve.
- **Proposed Native Shrub Planting**

14/11/24 - MARK UP TO SHOW AMENDMENTS IN LATEST REVISION (P11)

REV.	DATE	DESCRIPTION	DRAWN	CHK'D
P06	03/04/24	UPDATED	TH	SA
P05	19/12/23	UPDATED	TH	SA
P04	14/12/23	UPDATED	TH	SA
P03	11/12/23	UPDATED	TH	SA

U R B A N
G R E E N

A: Ground Floor, The Tower,
Deva City Office Park, Trinity Way,
Manchester M3 7BF

T: +44 (0) 161 312 3131

weareurbangreen.co.uk

Client: Chancery Gate

Project: Former Walkers Site,Crabtree Lane

Title: GENERAL ARRANGEMENT PLAN

Issue: PLANNING

Drawn:	Checked:	Approved:
TH	SA	MT

Project:	Scale @ A1:	Date:
UG2066	1:250	29/11/23

Dwg No: UG_2066_LAN_GA_DRW_101 **Revision:** P06